
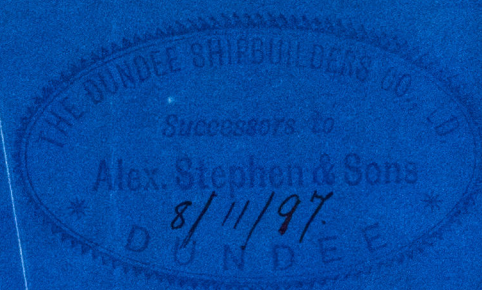


— LONGITUDINAL SECTION —

— SCREW TUG No. 114 —

— SCALE 1/2 INCH = 1 FOOT. —

8.12.97

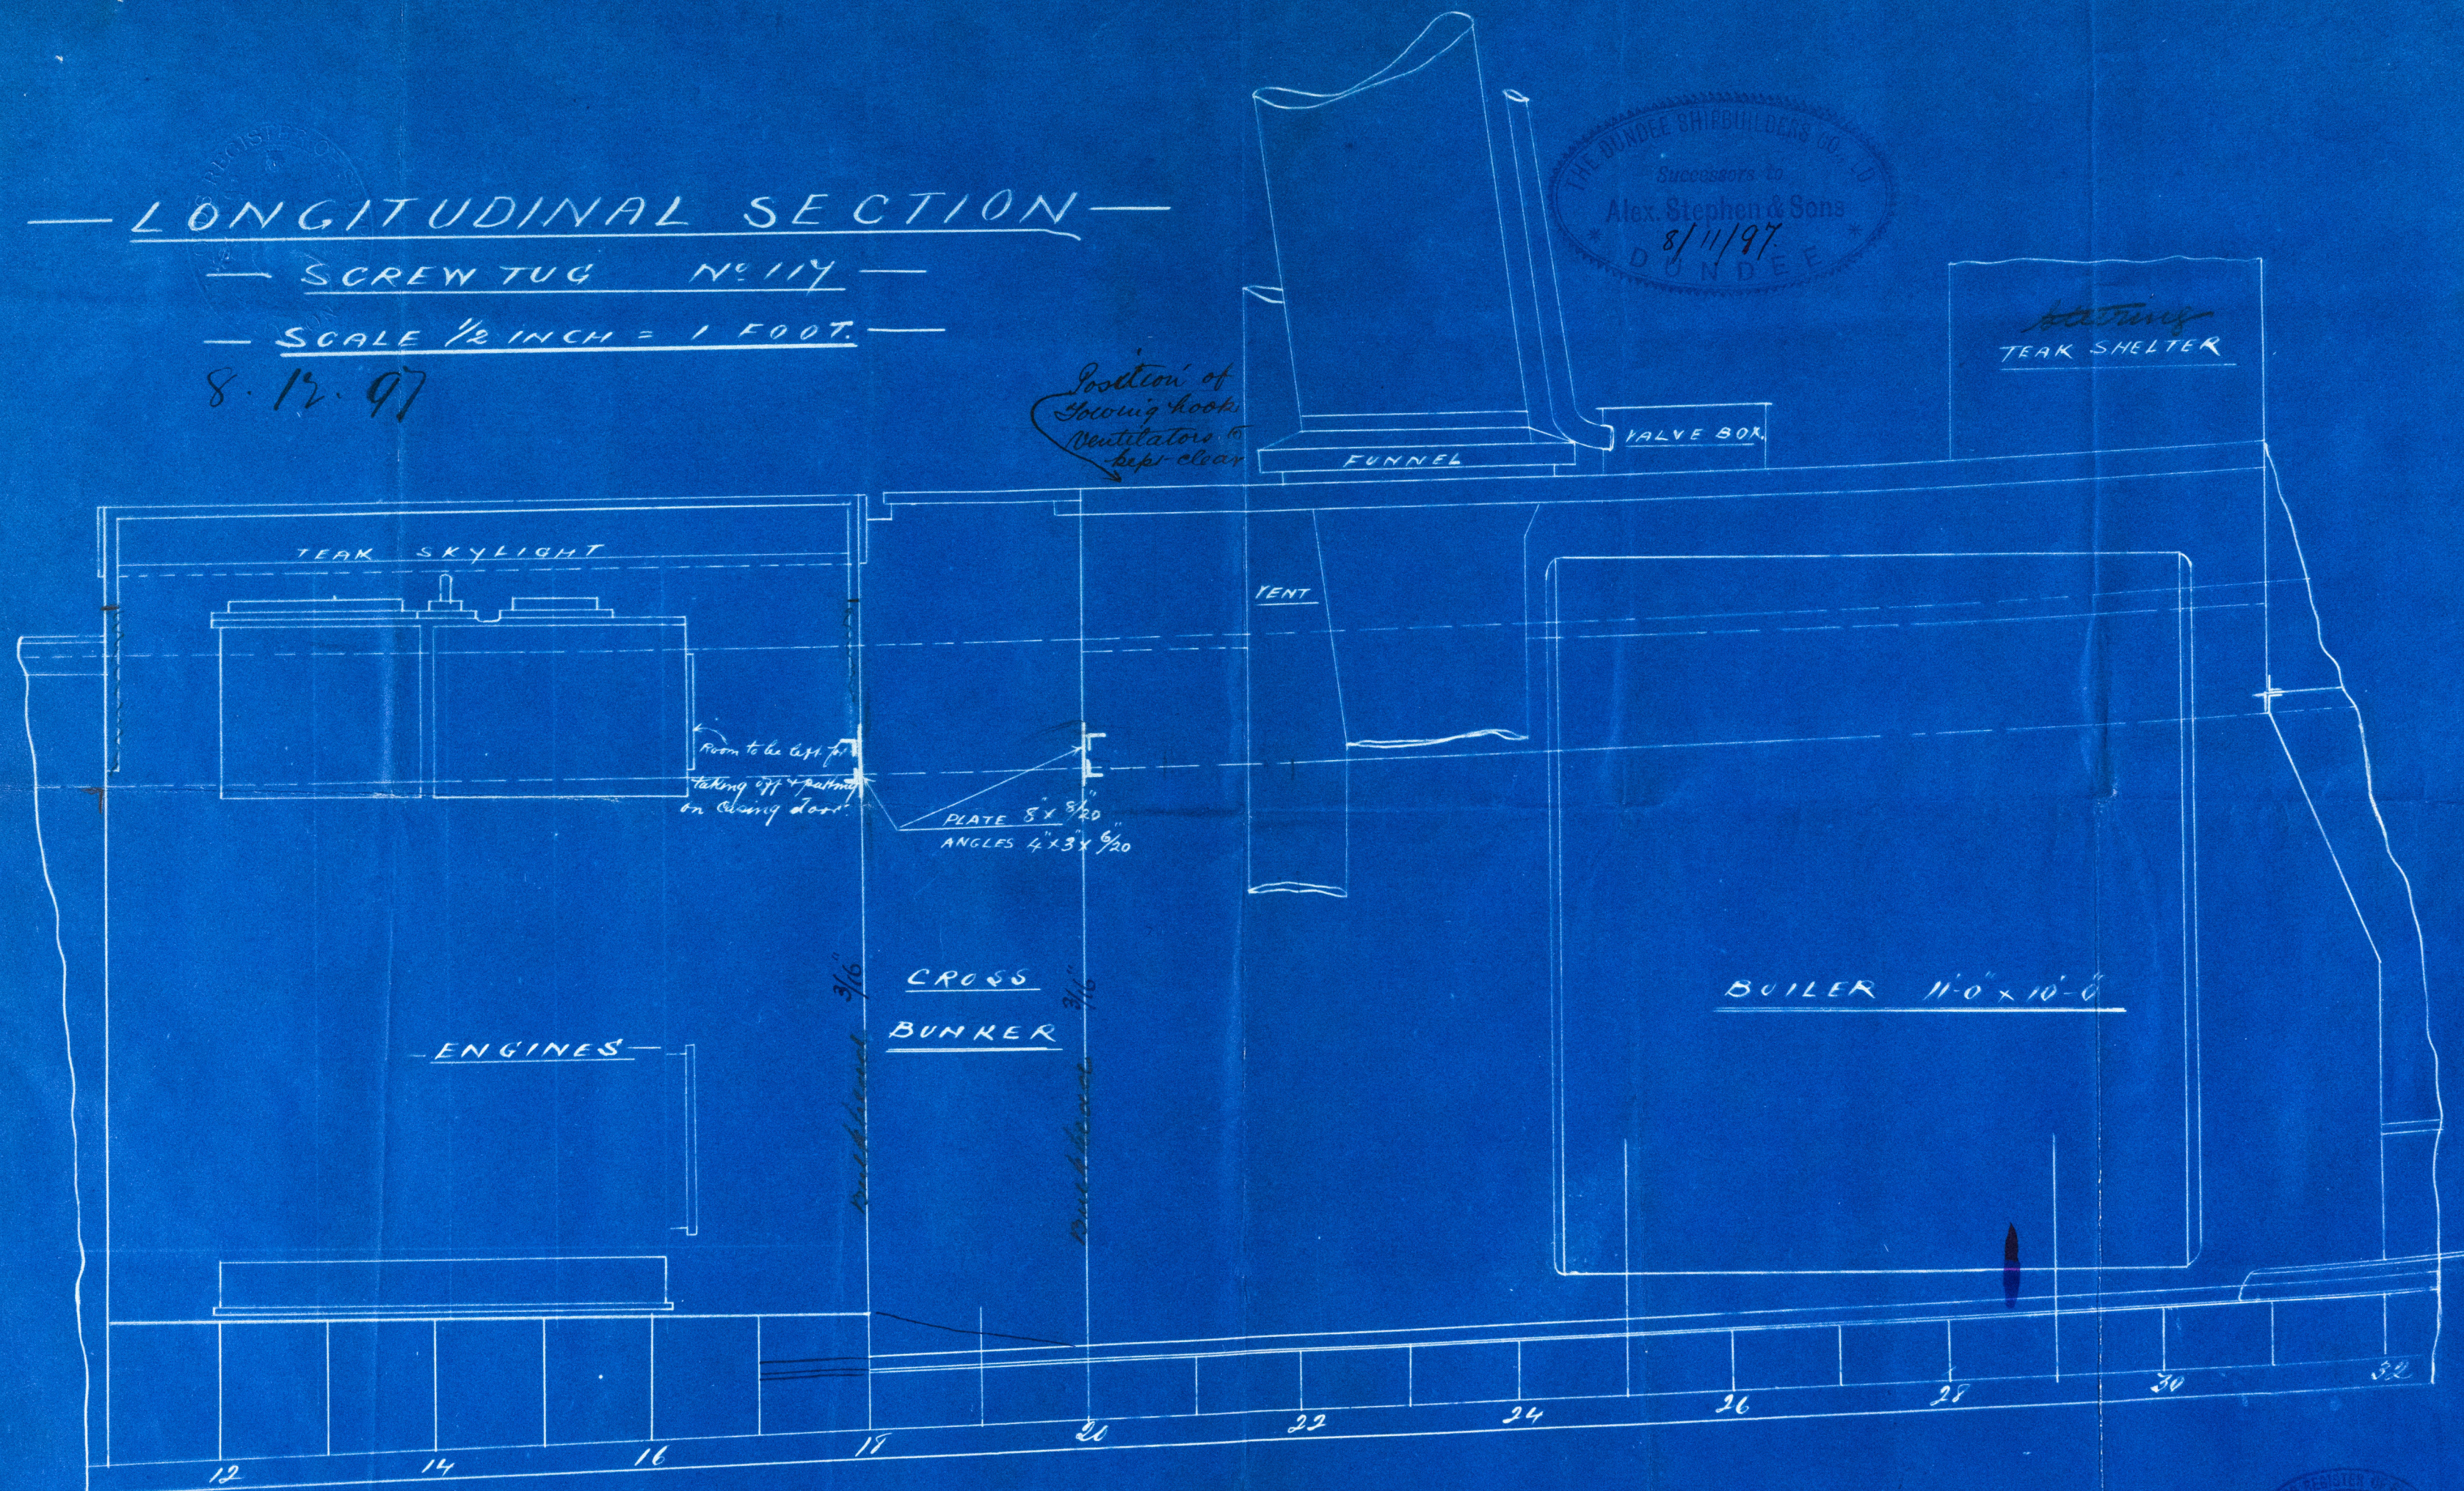

© 2019
Lloyd's Register
Foundation



Plan shewing position
of Engines & Boilers
of

Dundee SB Co Lim

SS No 114

SS "Unat"

Dun Rpt. 6413

DUN 127-0036



© 2019

Lloyd's Register
Foundation