
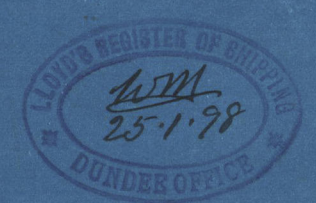
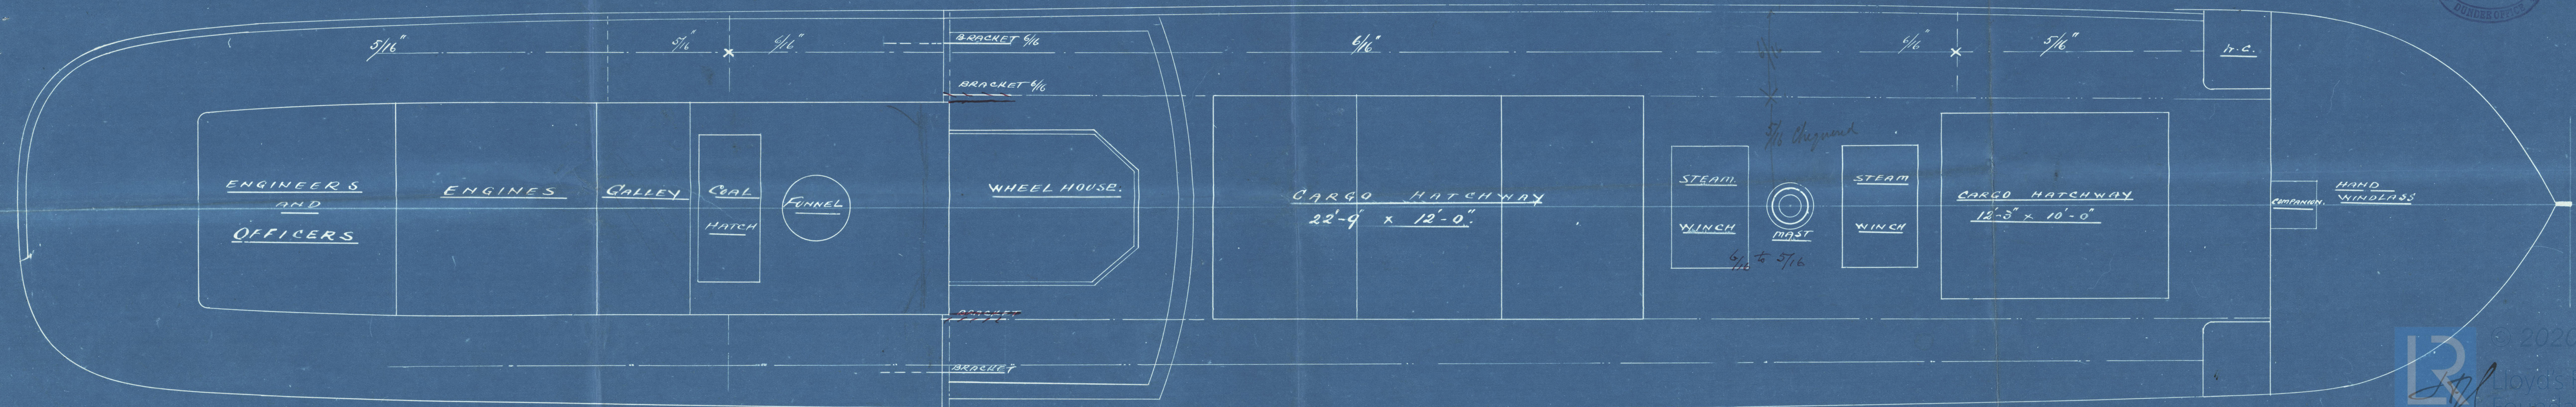
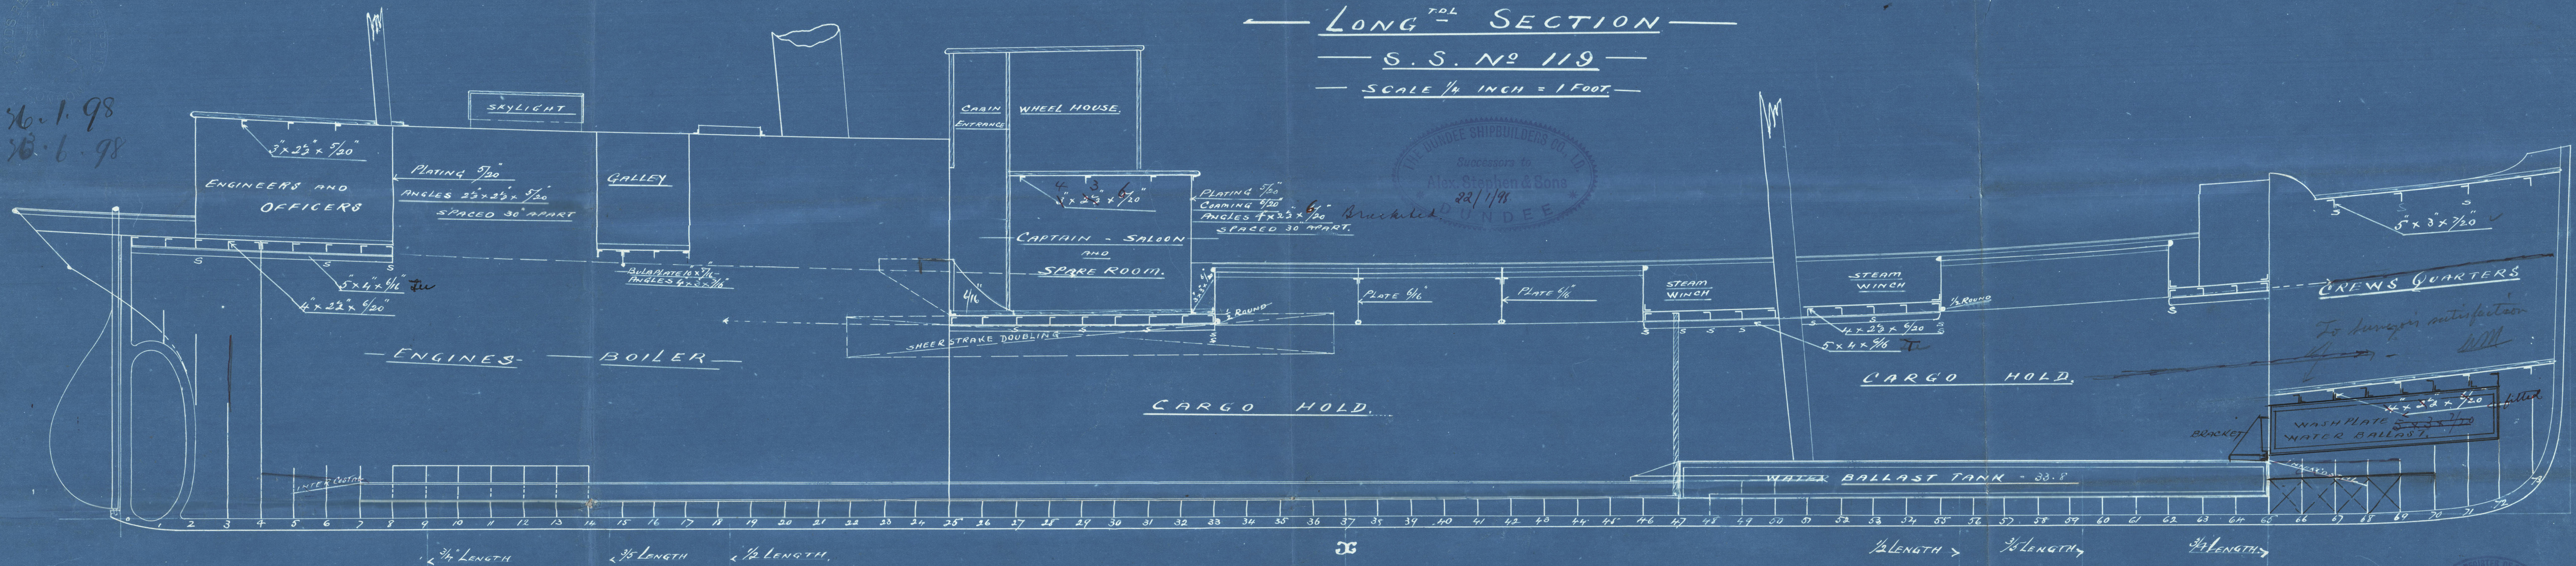


26.1.98
26.6.98

— LONG^{TOL} SECTION —
— S.S. No 119 —
— SCALE 1/4 INCH = 1 FOOT —

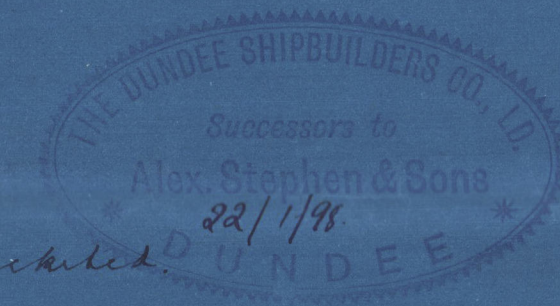


Dundee M.B. for

S.S. No 119

Longit^l section

S.S. Active

Dundee Report No 6424

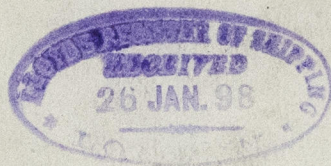

© 2020

Lloyd's Register
Foundation
DUN127-0070