

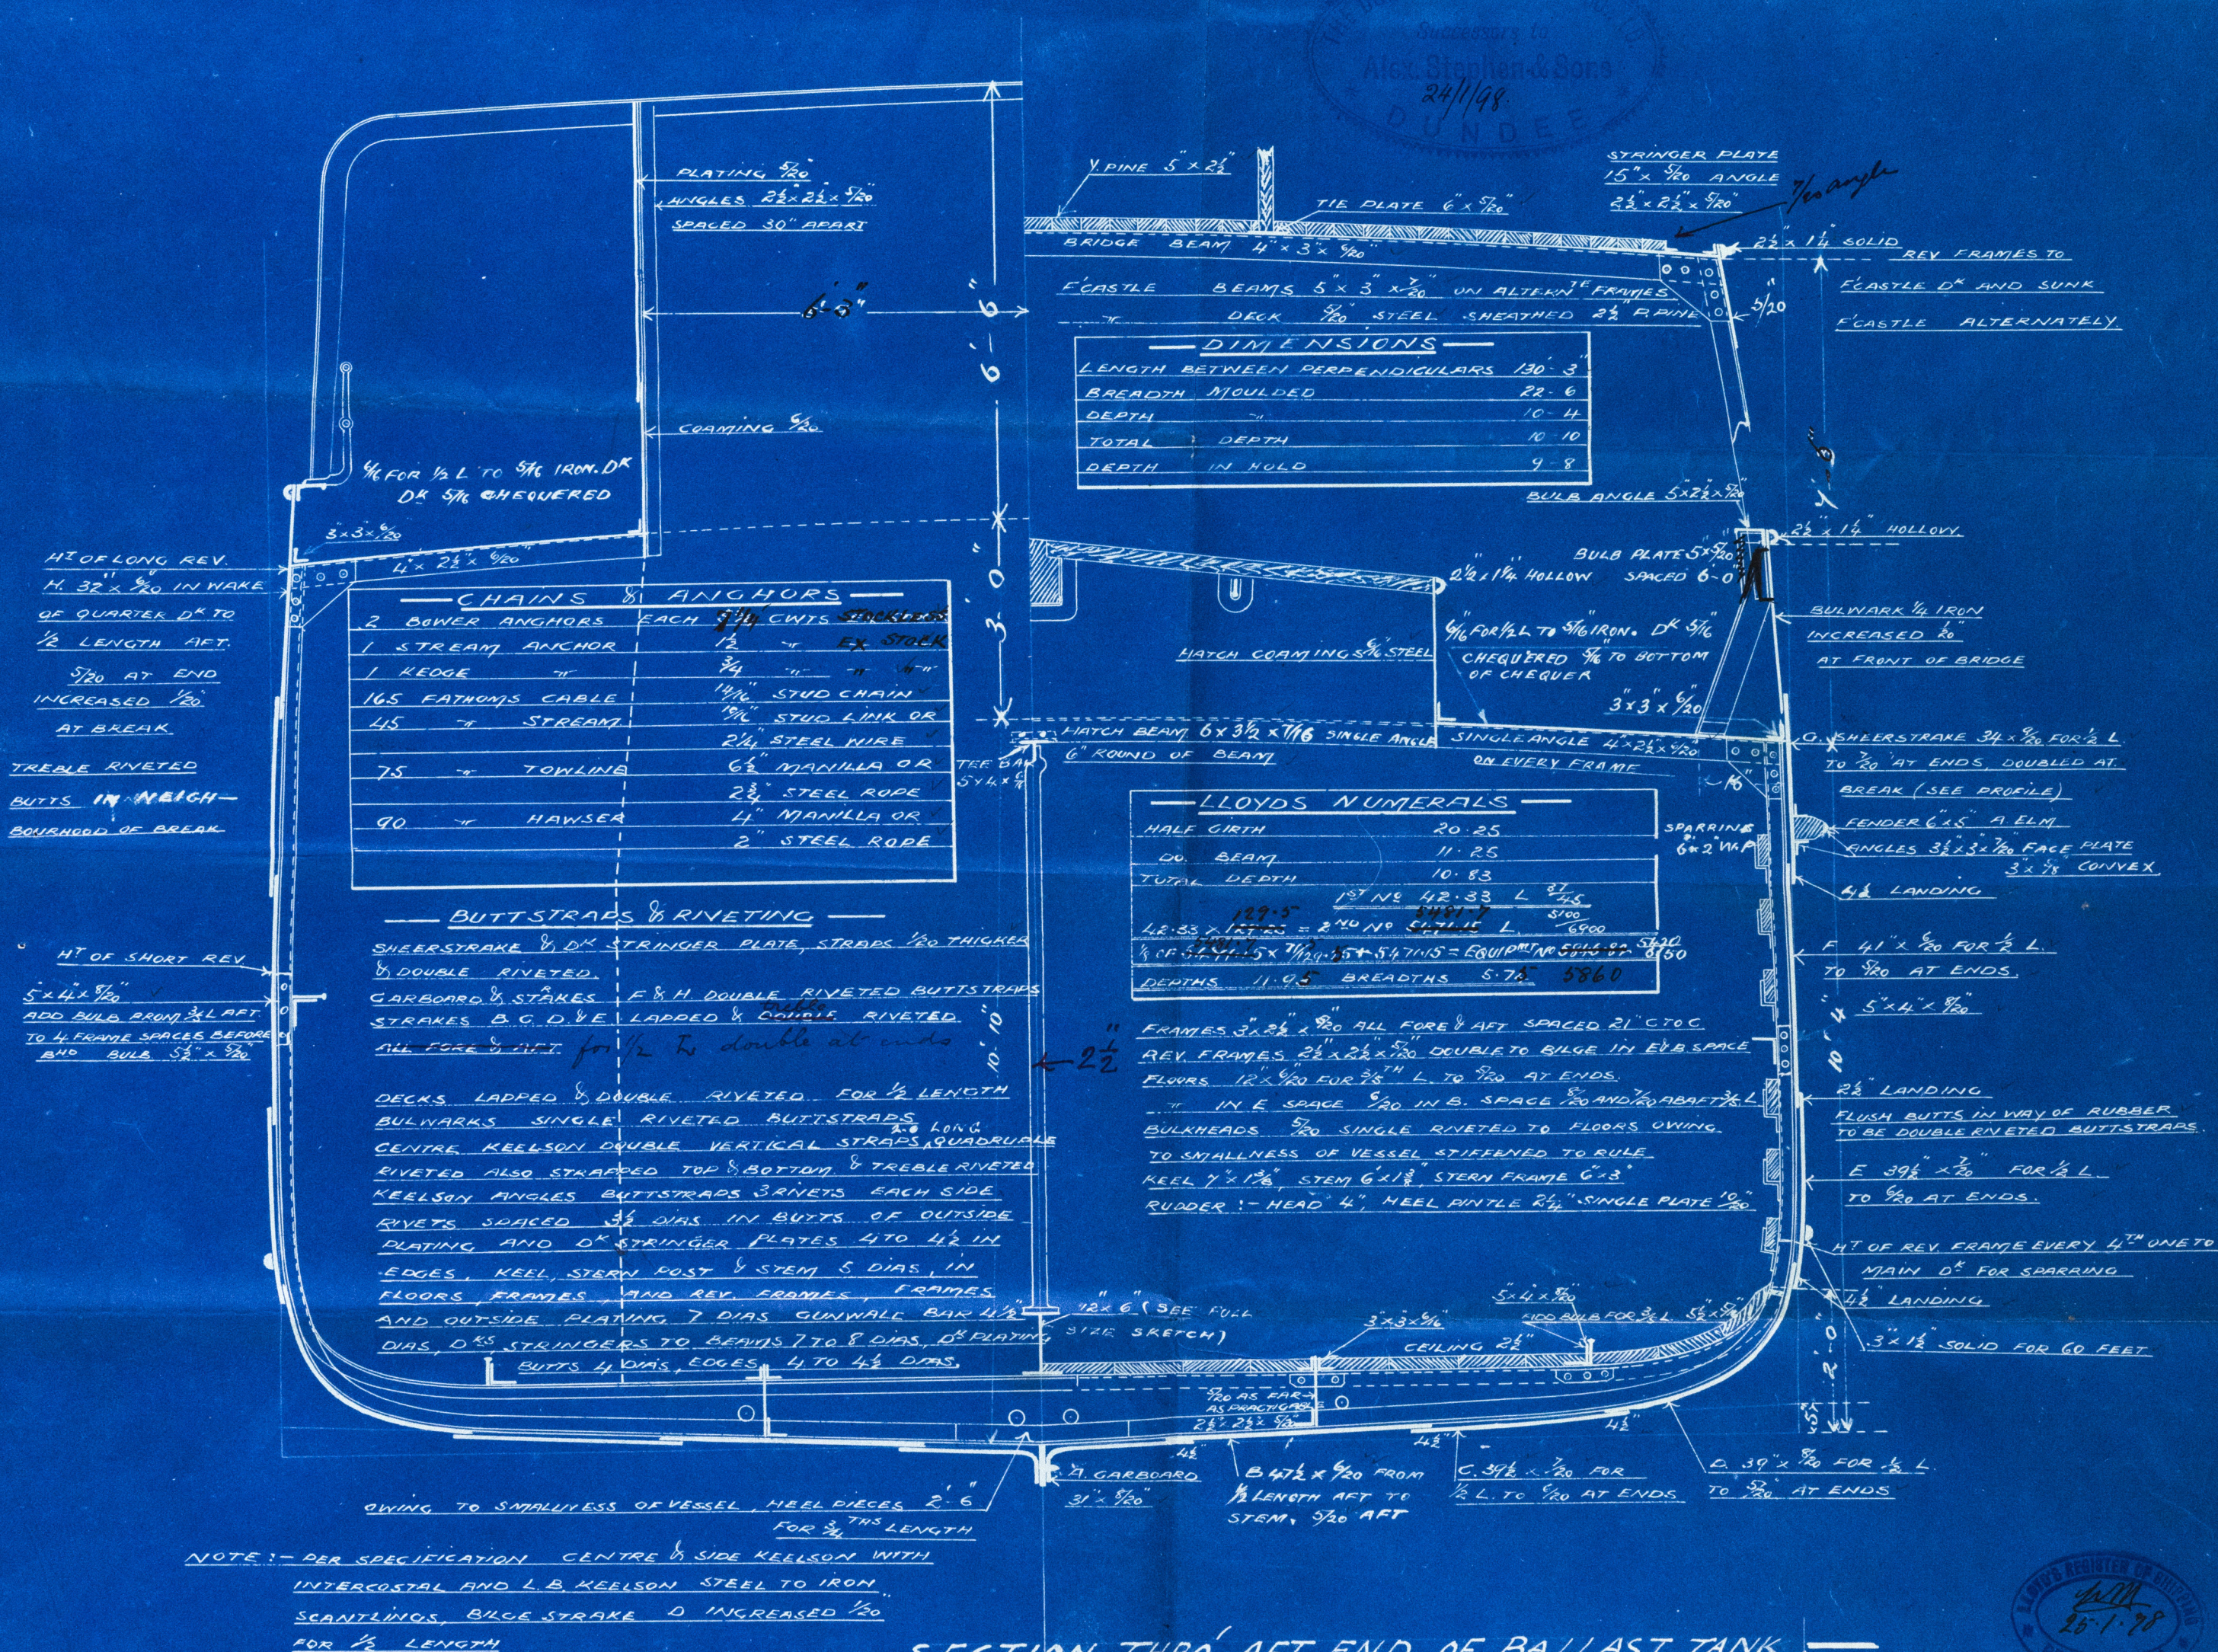


CLASS 100 A.I. STEEL. RULES 97/98

16. 1. 98
 13. 6. 98

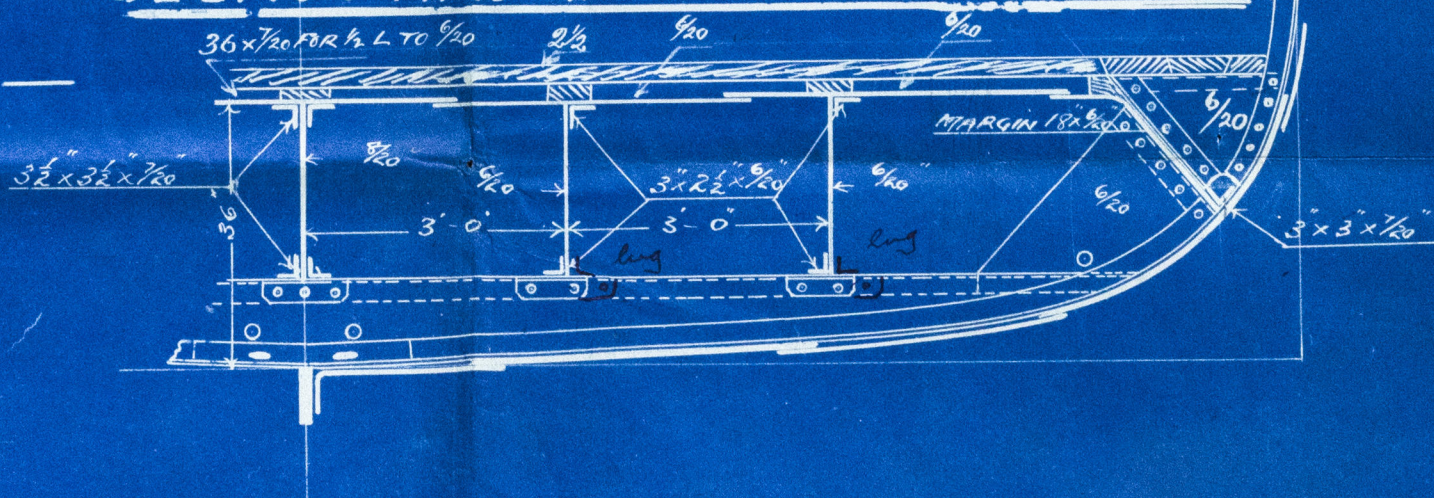

SECTION ON B^{HD} 65 LOOKING FOR D

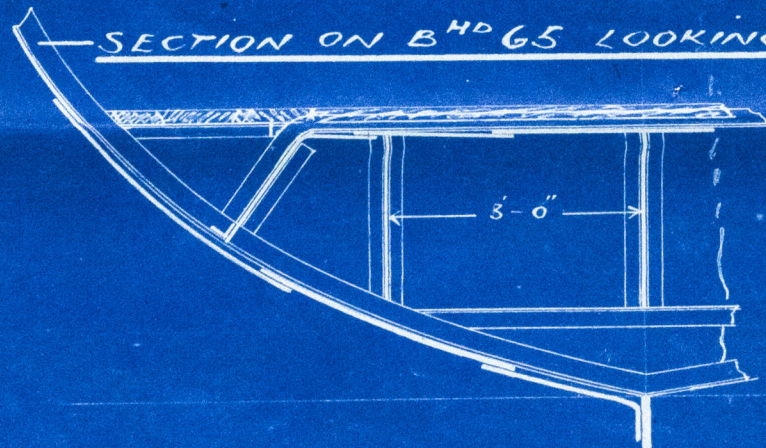

J.H.L.
26/1/98



Gunda H.B. Coi
S.S. No 119

Midship Section

S.S. Active

Gunda Report No 6424



DUN 127-0072



© 2019

Lloyd's Register
Foundation