

BOILER NO 241

FOR DUNDEE SHIPBUILDERS COY^{YS} SS NO 119

SCALE 1" = 1 FOOT

WORKING PRESSURE 180 LBS.

ALL MATERIAL STEEL EXCEPT TUBES WHICH ARE IRON.

11th MARCH 1898





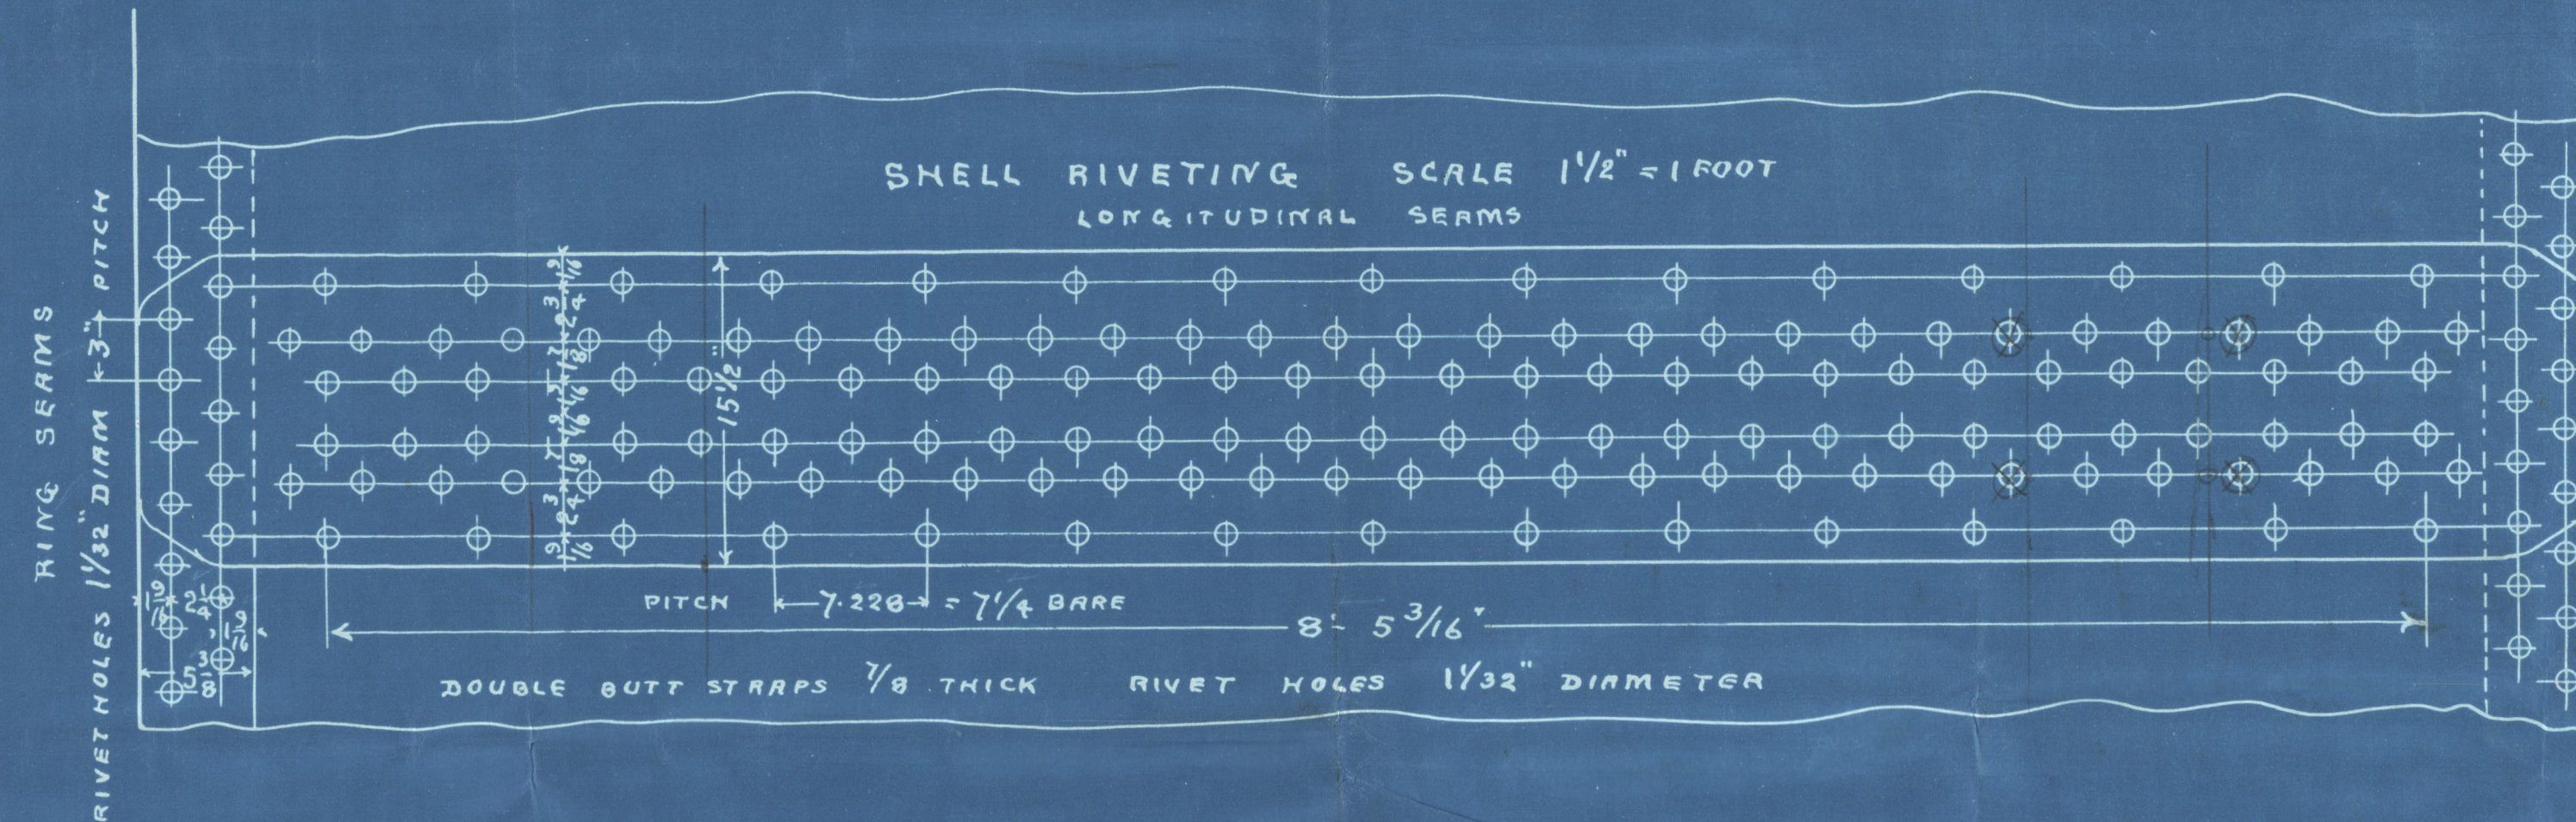


PLATE LIST	THICK	138	Lines	797.5
SHELL	3/4"	2	Fireboxes	132.0
FRNS TOP	3/4"	2	Furnaces	65.0
FRNT TOP DOUBLING	3/4"	1	Front tube plate	19.9
FRONT BOTTOM	3/4"		Total surface	1009.0
BACK BOTTOM	3/4"			
FURNACES	3/4"		Water surface	100.0
BACK TUBE PLATE	3/4"			
FIRE BOX TOPS	3/4"		Grate surface	32.0
FIRE BOX SIDES	3/4"			
FIRE BOX BOTTOM	3/4"		Area thro tubes	6.0
FIRE BOX BACK	3/4"			
				Area thro tubes Grate surface = 188.0

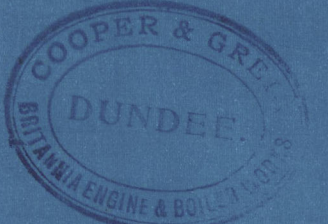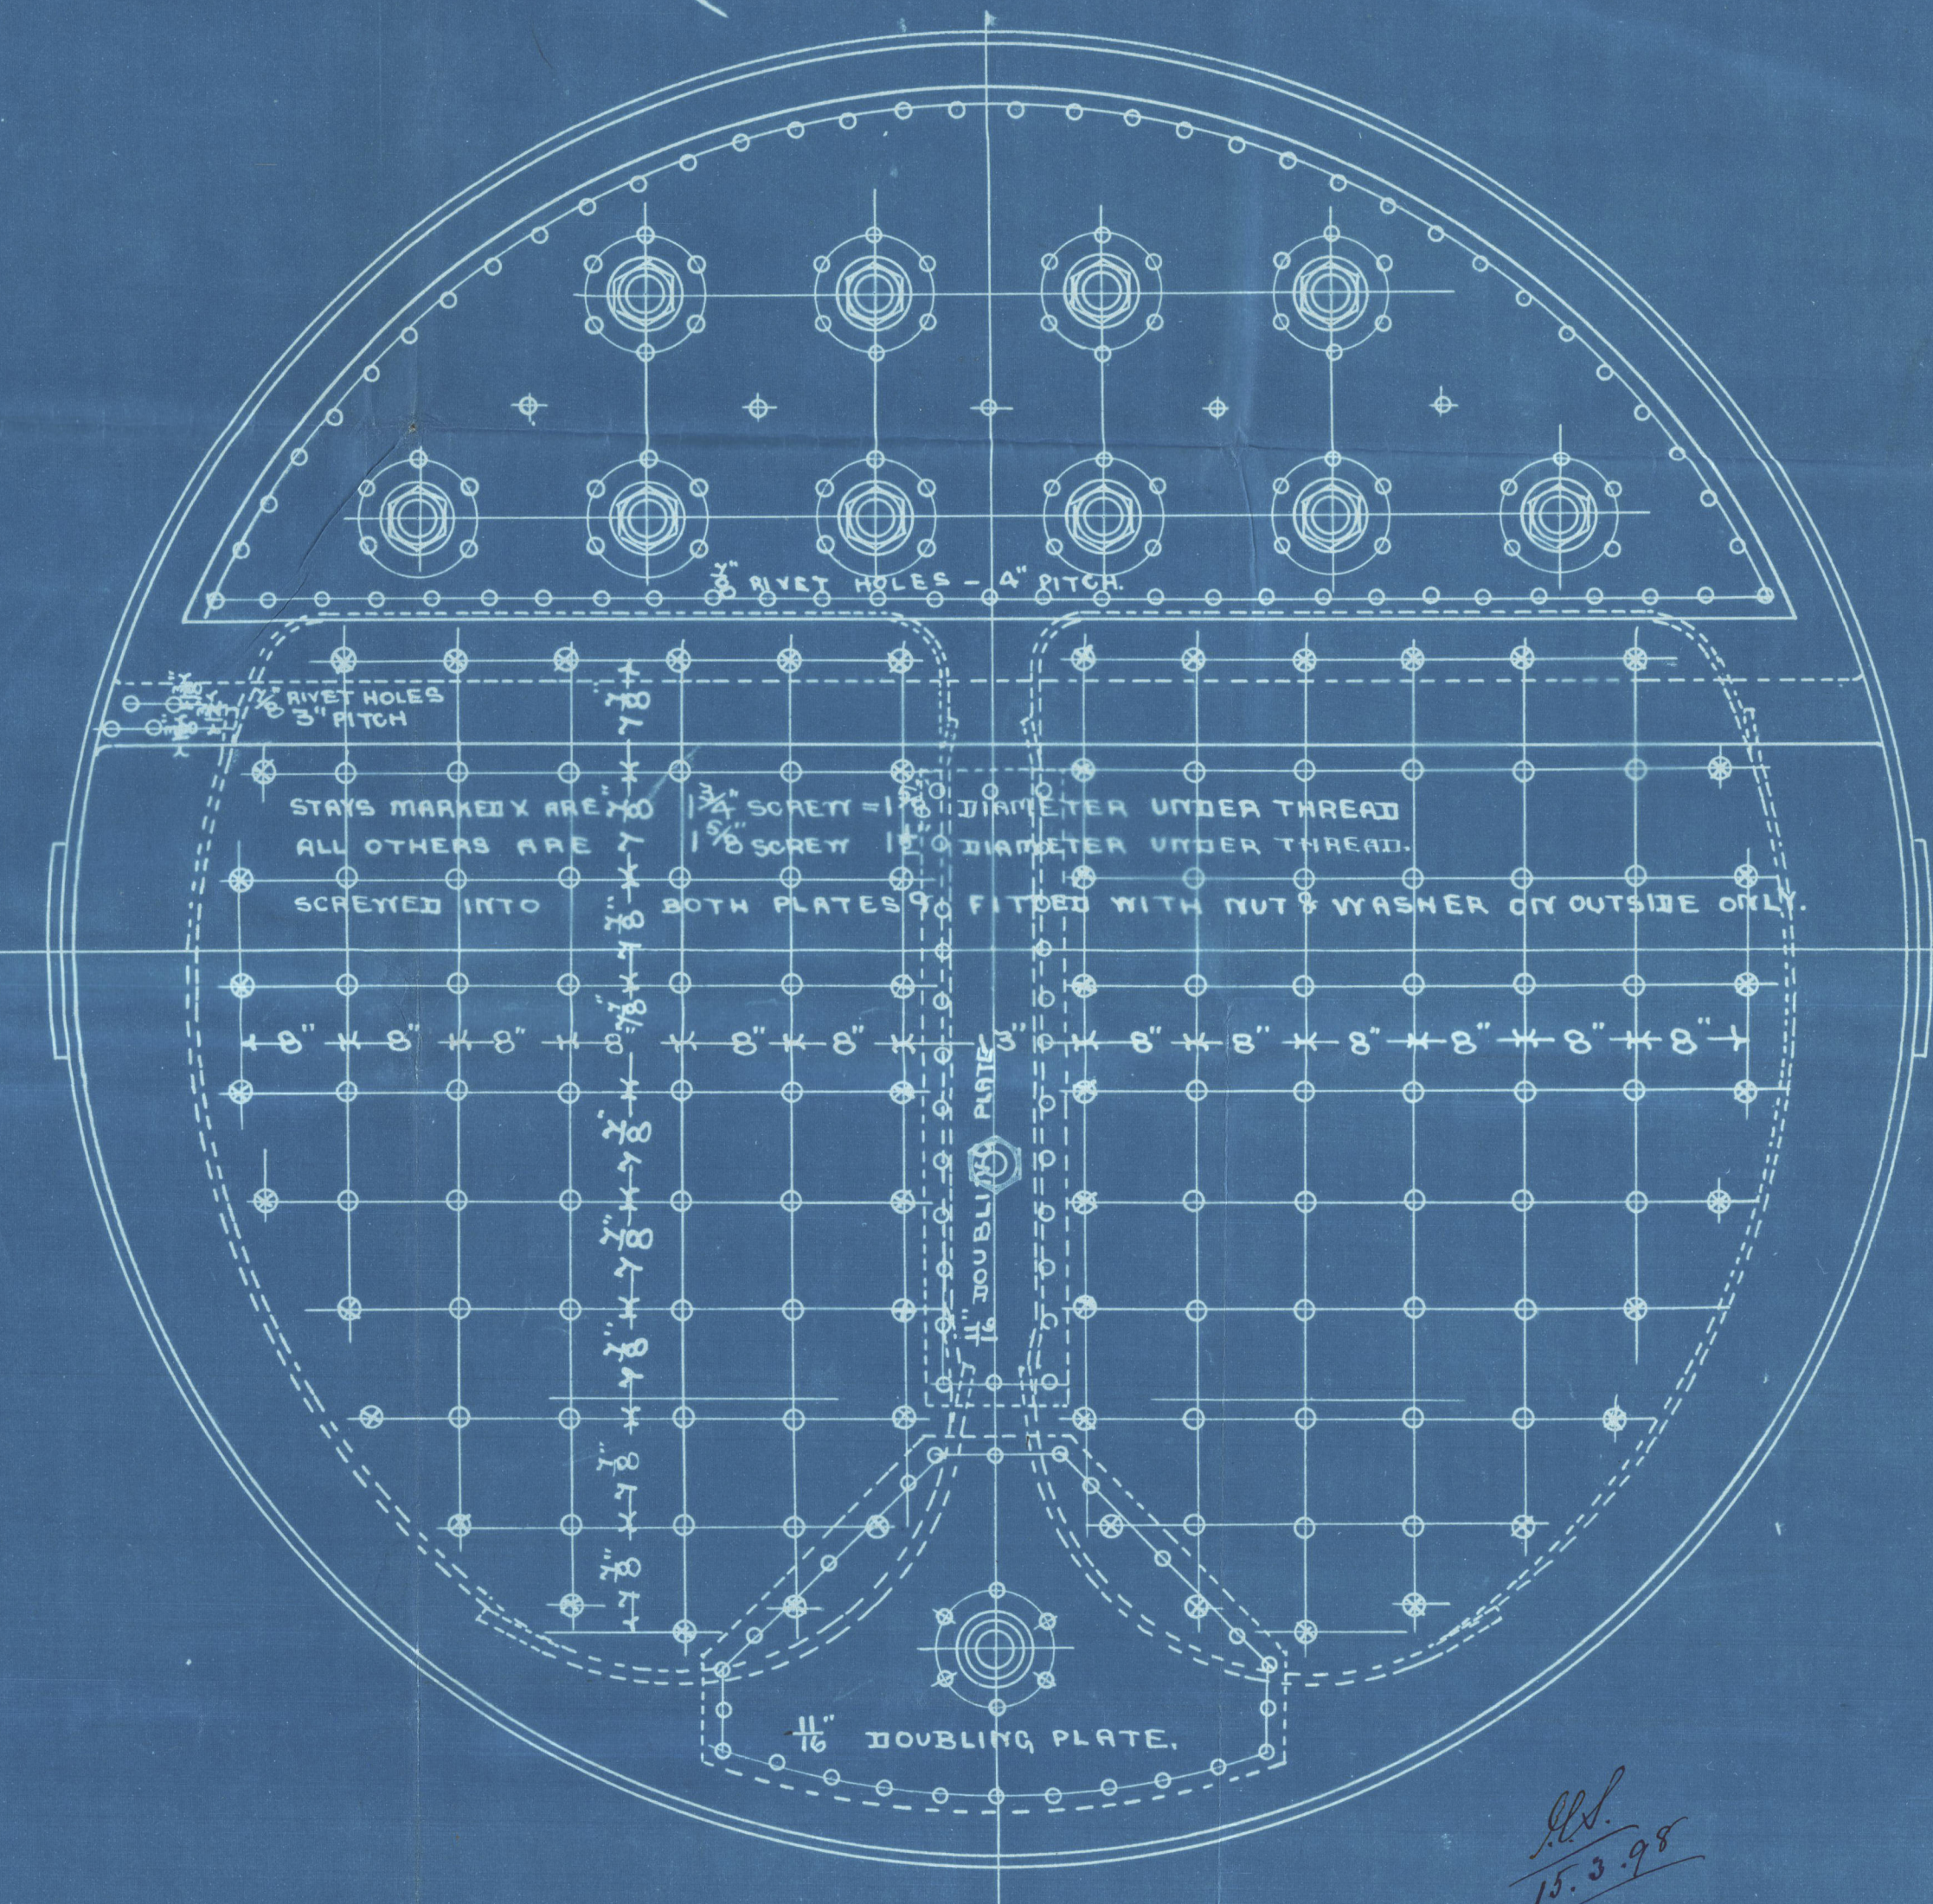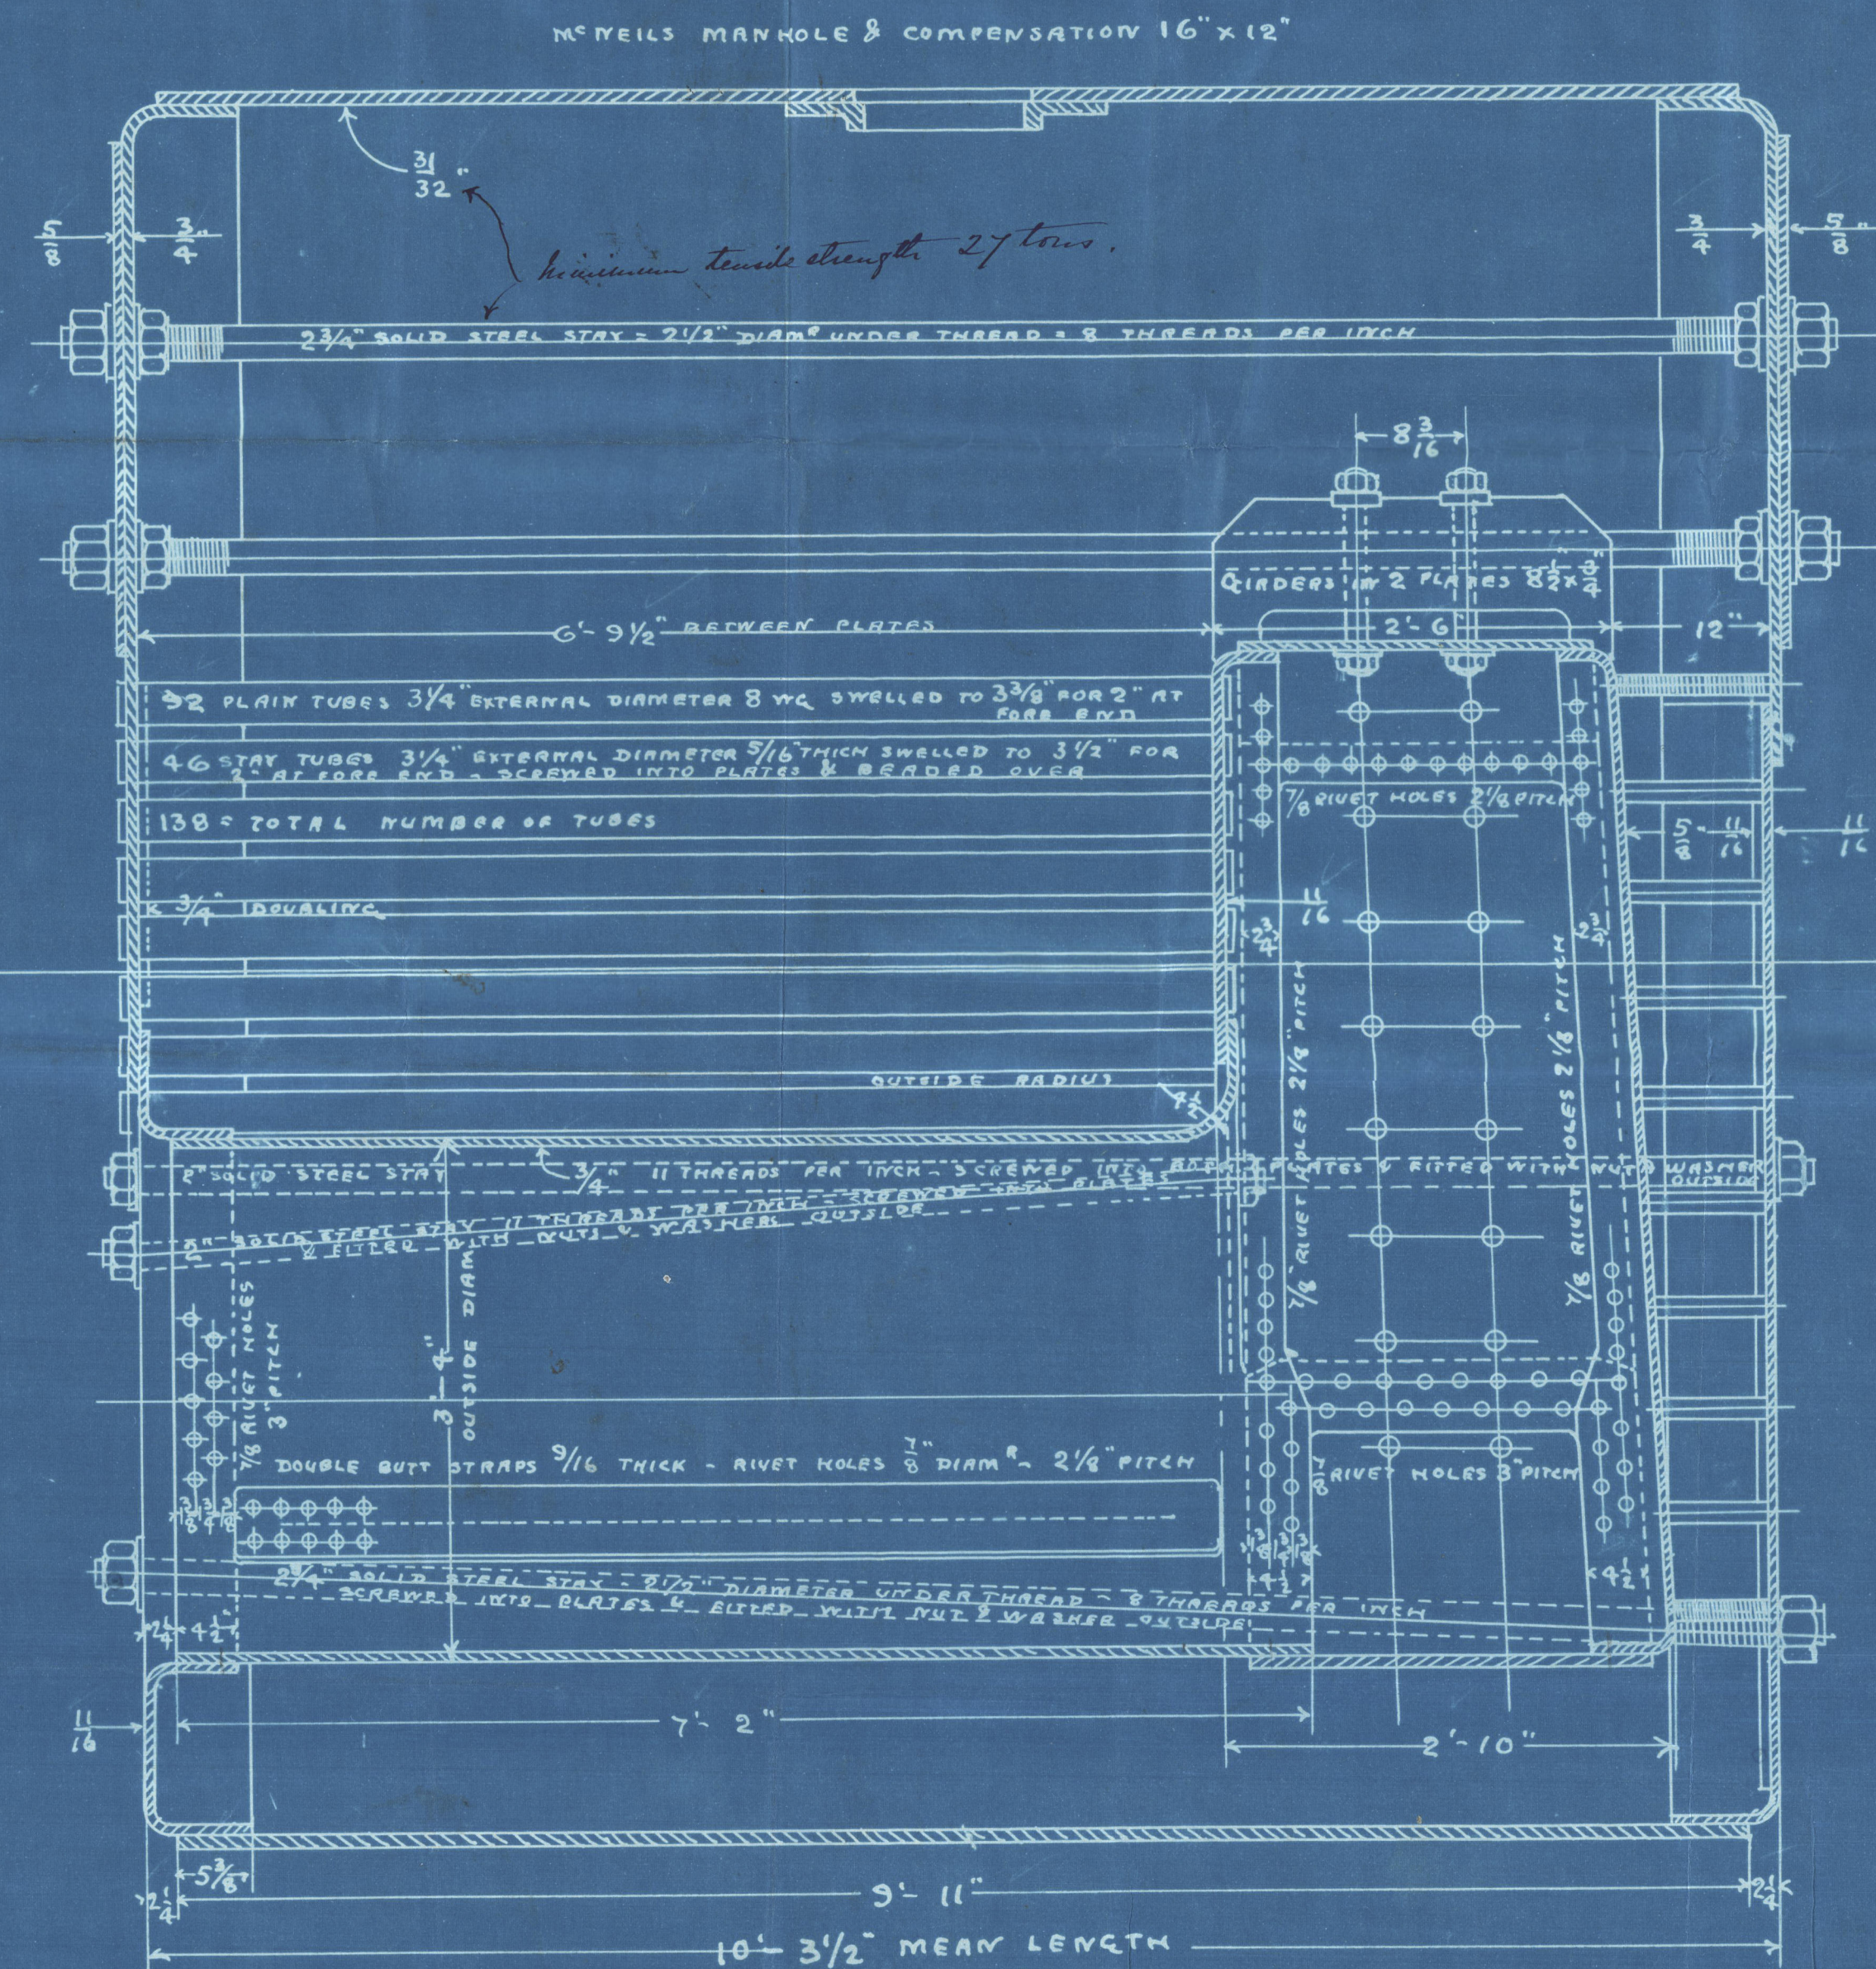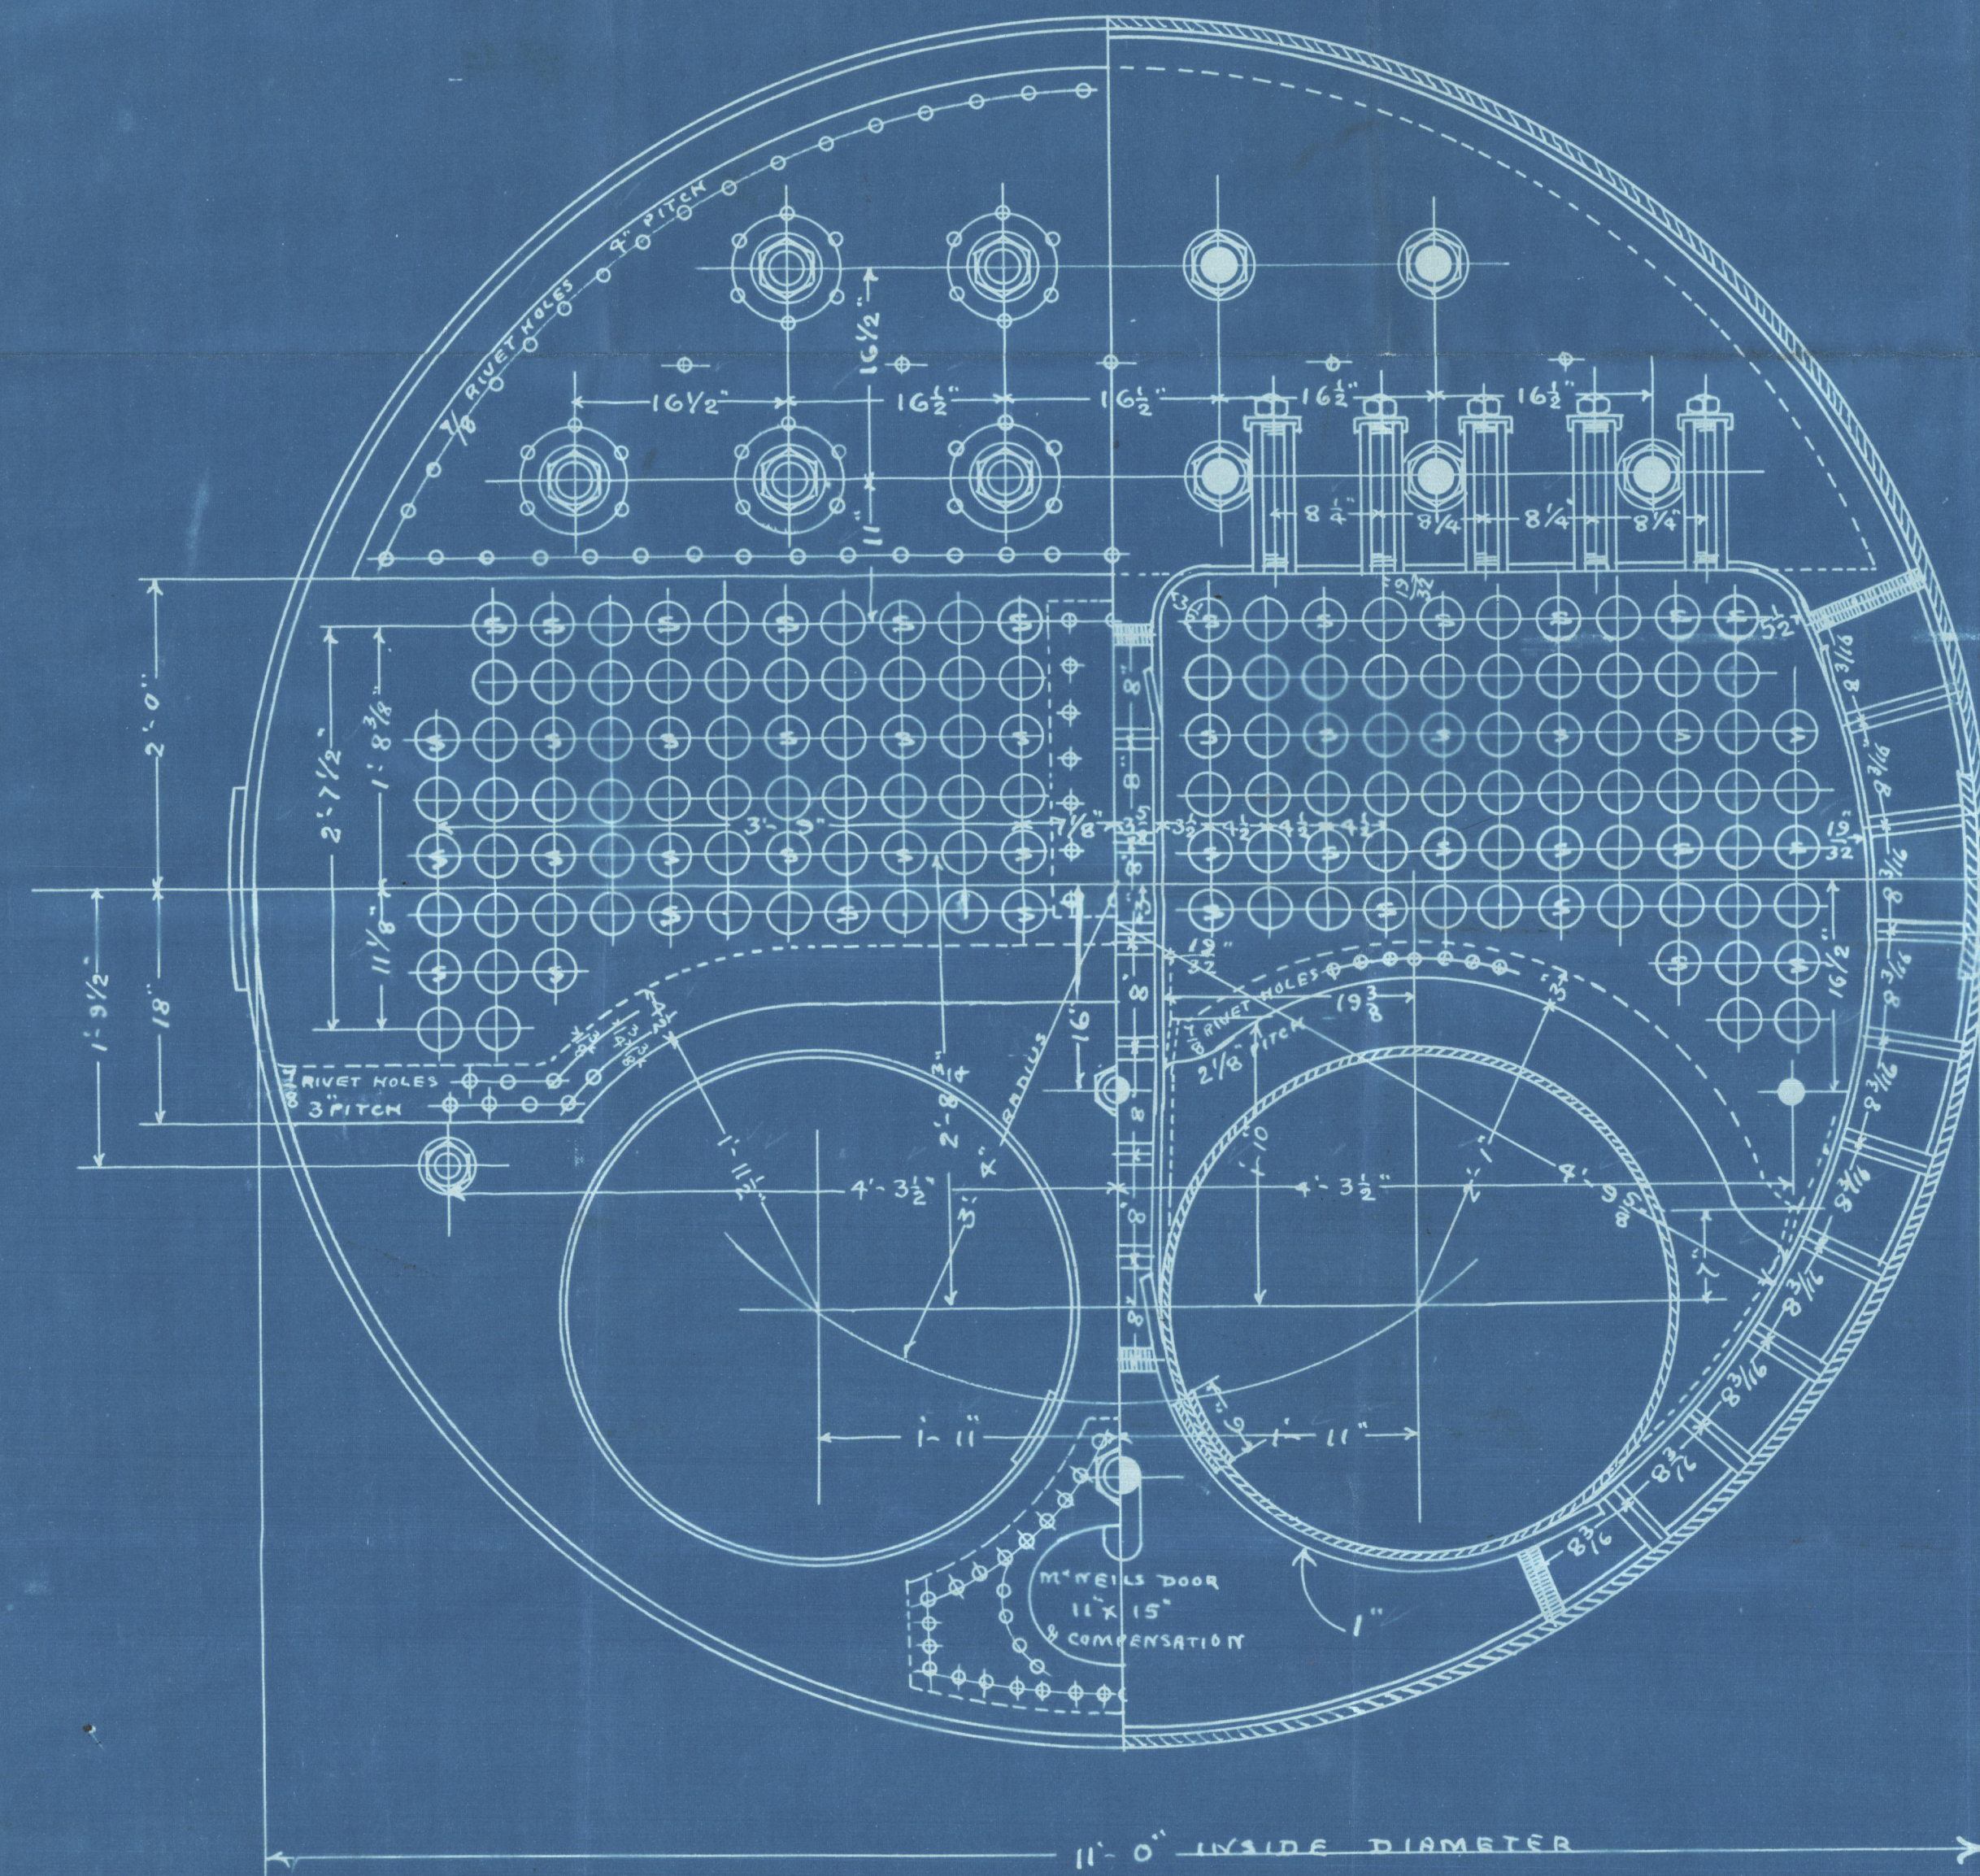

BOILER NO 241

15.3.98

Messrs Cooper & Greigs

Boiler No 241

for

Dundee Sh Co Lim

S S No 119.

S.S. "Active"

Dum Rpt No 6424.

No 7444
Lloyd's List-
360 lbs
WM-22-9-98



© 2020

Lloyd's Register
Foundation

DUN/27-10074