




22.1.98
28.3.98
13.4.98
6.5.98

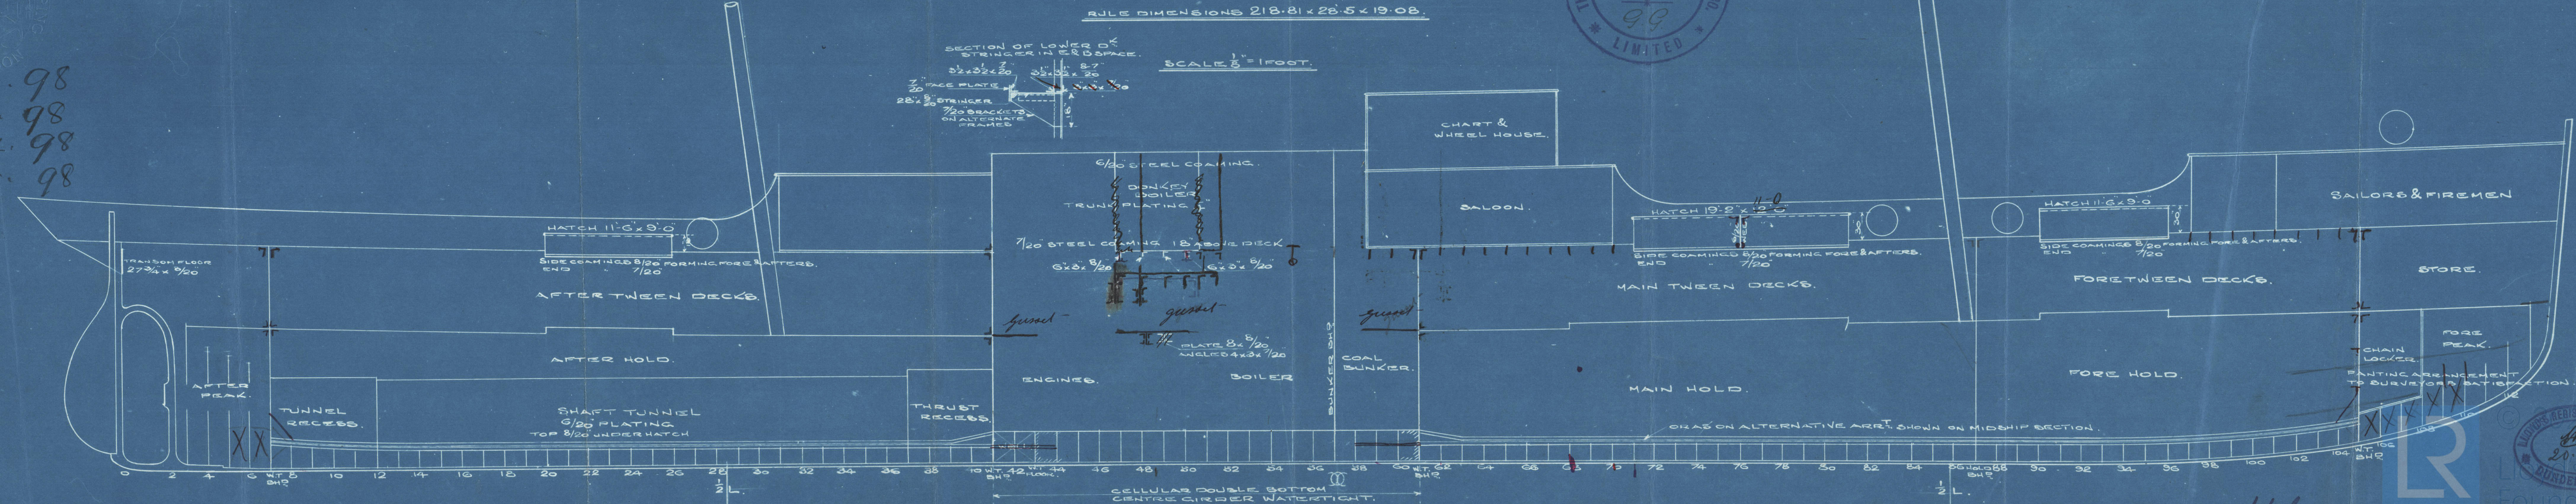

S.S. N^o 142
MOULDED DIMENSIONS 220'x28'-6"x18'-6"
RULE DIMENSIONS 218.81x28.5x19.08.

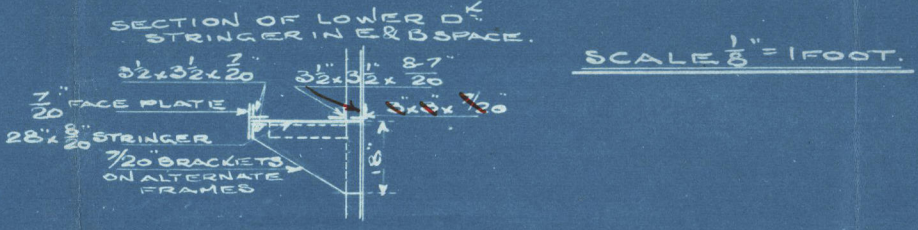

22/1/98

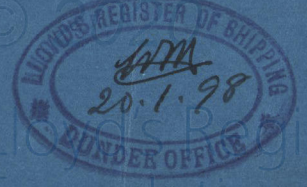

Lloyd's Register Foundation

DUN 127-0086



Profile

Baledon LB & Eng Co's

S S No 142.

S S. Tagus

Dun Rpt No 6493

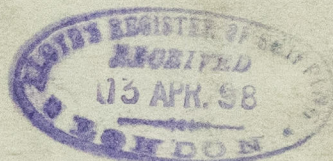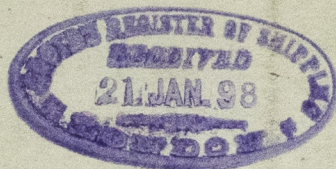

DUN127-0086