

Lloyd's Register of British and Foreign Shipping.

(Report on Vessel No. 6433 Port Dundee)No. 560SHIP FORGINGS ~~OR CASTINGS~~

I have to report that the undermentioned Iron ~~or Steel~~ Forgings ~~or Castings~~,
 manufactured by Messrs Jas Carmichael & Co
 of Dundee for the Vessel No. 142, being built
 by The Calidon S.S. & F. Co of Dundee
 have been inspected by me as set forth below, and found to be, so far as can be seen,
sound and good.

Mark on Forgings.

Lloyd's

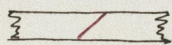
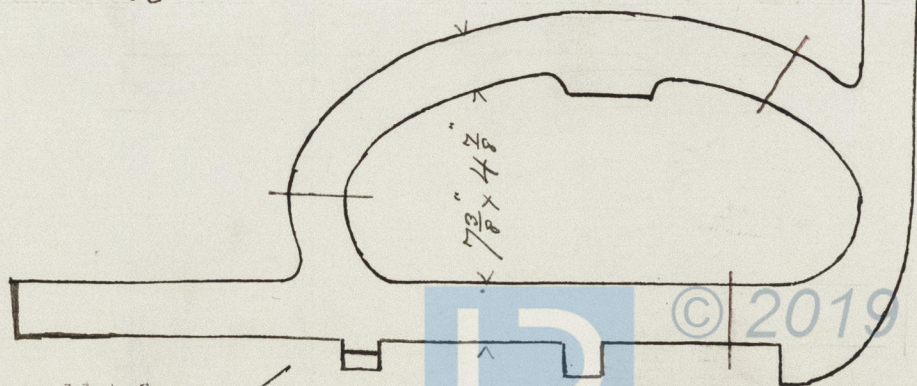
No. 613

WM-30.5.98

Wm Morrison
Dundee

	STERN FRAME.	RUDDER FRAME.	STEM.
Material* ...	<u>Scrap iron</u>		
How made ...	<u>Forged</u>		
Dimensions ...	<u>7³/₈" x 4⁷/₈"</u>		
Progress on Inspection	<u>Forged in the rough</u>		
Date when Inspected	<u>and finished</u>		
	<u>25th & 30th May, 1898</u>		

SKETCHES OF FRAMES SHOWING POSITION AND DESCRIPTION OF WELDS OF FORGINGS, OR PARTICULARS OF
 TESTS APPLIED TO CASTINGS.

weld

Fee (if any chargeable) £

To be paid at

* If of Iron, state whether scrap or puddled Iron.