


28.5.98
28.5.98
28.5.98


S.S. N° 142
PUMPING PLAN

SCALE 1" = 1 FOOT.

TONNAGE UNDER UPPER DECK ABOUT 765 TONS.

 

as sounding before the fitted.

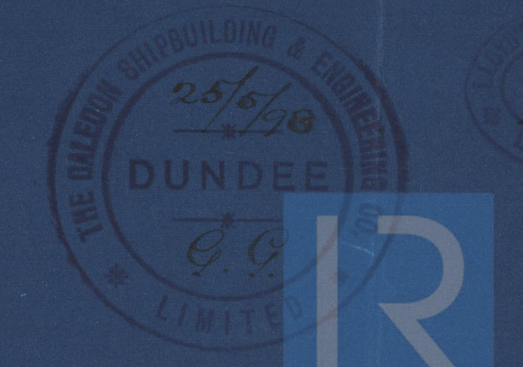

LONDON

Pumping Arrangement
— " —

Caledon M.B. & L. to Lin

S.S. 142
— " —

S.S. "Lagus"

Dun Rpt No 6433



© 2020

Lloyd's Register
Foundation

DUN127-0104