

## Lloyd's Register of British and Foreign Shipping.

(Report on Vessel No. 6460 Port Dundee)No. 570SHIP FORGINGS ~~OR CASTINGS~~.

I have to report that the undermentioned Iron ~~or Steel~~ Forgings ~~or Castings~~,  
 manufactured by Messrs Jas Carmichael & Co  
 of Dundee for the Vessel No. 31, being built  
 by Mouton & Co Ltd of Montrose  
 have been inspected by me as set forth below, and found to be, so far as can be seen,  
sound and good.


Mark on Forgings.

Lloyd's  
 No. 619  
 WM. 12.8.98

Wm MorrisonDundee

	STERN FRAME.	RUDDER FRAME.	STEM.
Material*	/	<u>Scrap iron</u>	/
How made		<u>Forged</u>	
Dimensions		<u>4" diam head</u>	
Progress on Inspection		<u>Forged in the rough</u>	
Date when Inspected		<u>and finished</u> <u>2<sup>nd</sup> May 1895 &amp; 12<sup>th</sup> Aug 1898</u>	

SKETCHES OF FRAMES SHOWING POSITION AND DESCRIPTION OF WELDS OF FORGINGS, OR PARTICULARS OF TESTS APPLIED TO CASTINGS.

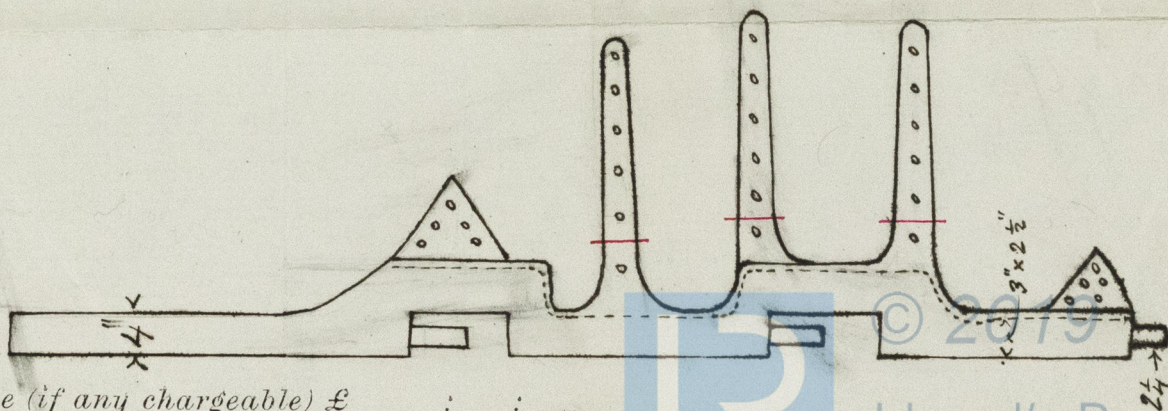

Fee (if any chargeable) £

To be paid at

Lloyd's Register  
 Foundation



Rudder Frame

John Duthie & Coys

S S "No 31"

Dun kpt No 6460.



© 2019

Lloyd's Register  
Foundation