

MIDSHIP SECTION

FOR

steel screw steamers nos 29 & 31


Scale $\frac{1}{2}$ inch = 1 foot
to class 100A1 at Lloyd's steel

Lloyd's Numerals	Proportions
Half Beam 12.5 ft	Breadths in length 5.15
Half Birth 24.44 "	Depths in " 8.9
Depth 14.458 "	
51.728 = 1 st c ^{1/2}	
123.46	
6690.34288 = 2 nd c ^{1/2}	

Equipment Numeral 6767 includes fit only

1 Bower Anchor	8 1/4 cwt	Stockless x 1 @ 3 cwt Stockless
1 Stream	"	2 "
1 Ridge	"	1 "
165 Fathoms	"	1" Stud link Chain cable
45 "	"	1/6" Stream Chain (Shotlink)
75 "	"	4" Hemp
90 "	"	5" Hawser

Note One Web Frame in way of Hatch 12' x 20' double Angles
2 1/2" x 2 1/2" x 5/16" Cold Stringer
Continuous thro' Web Frame

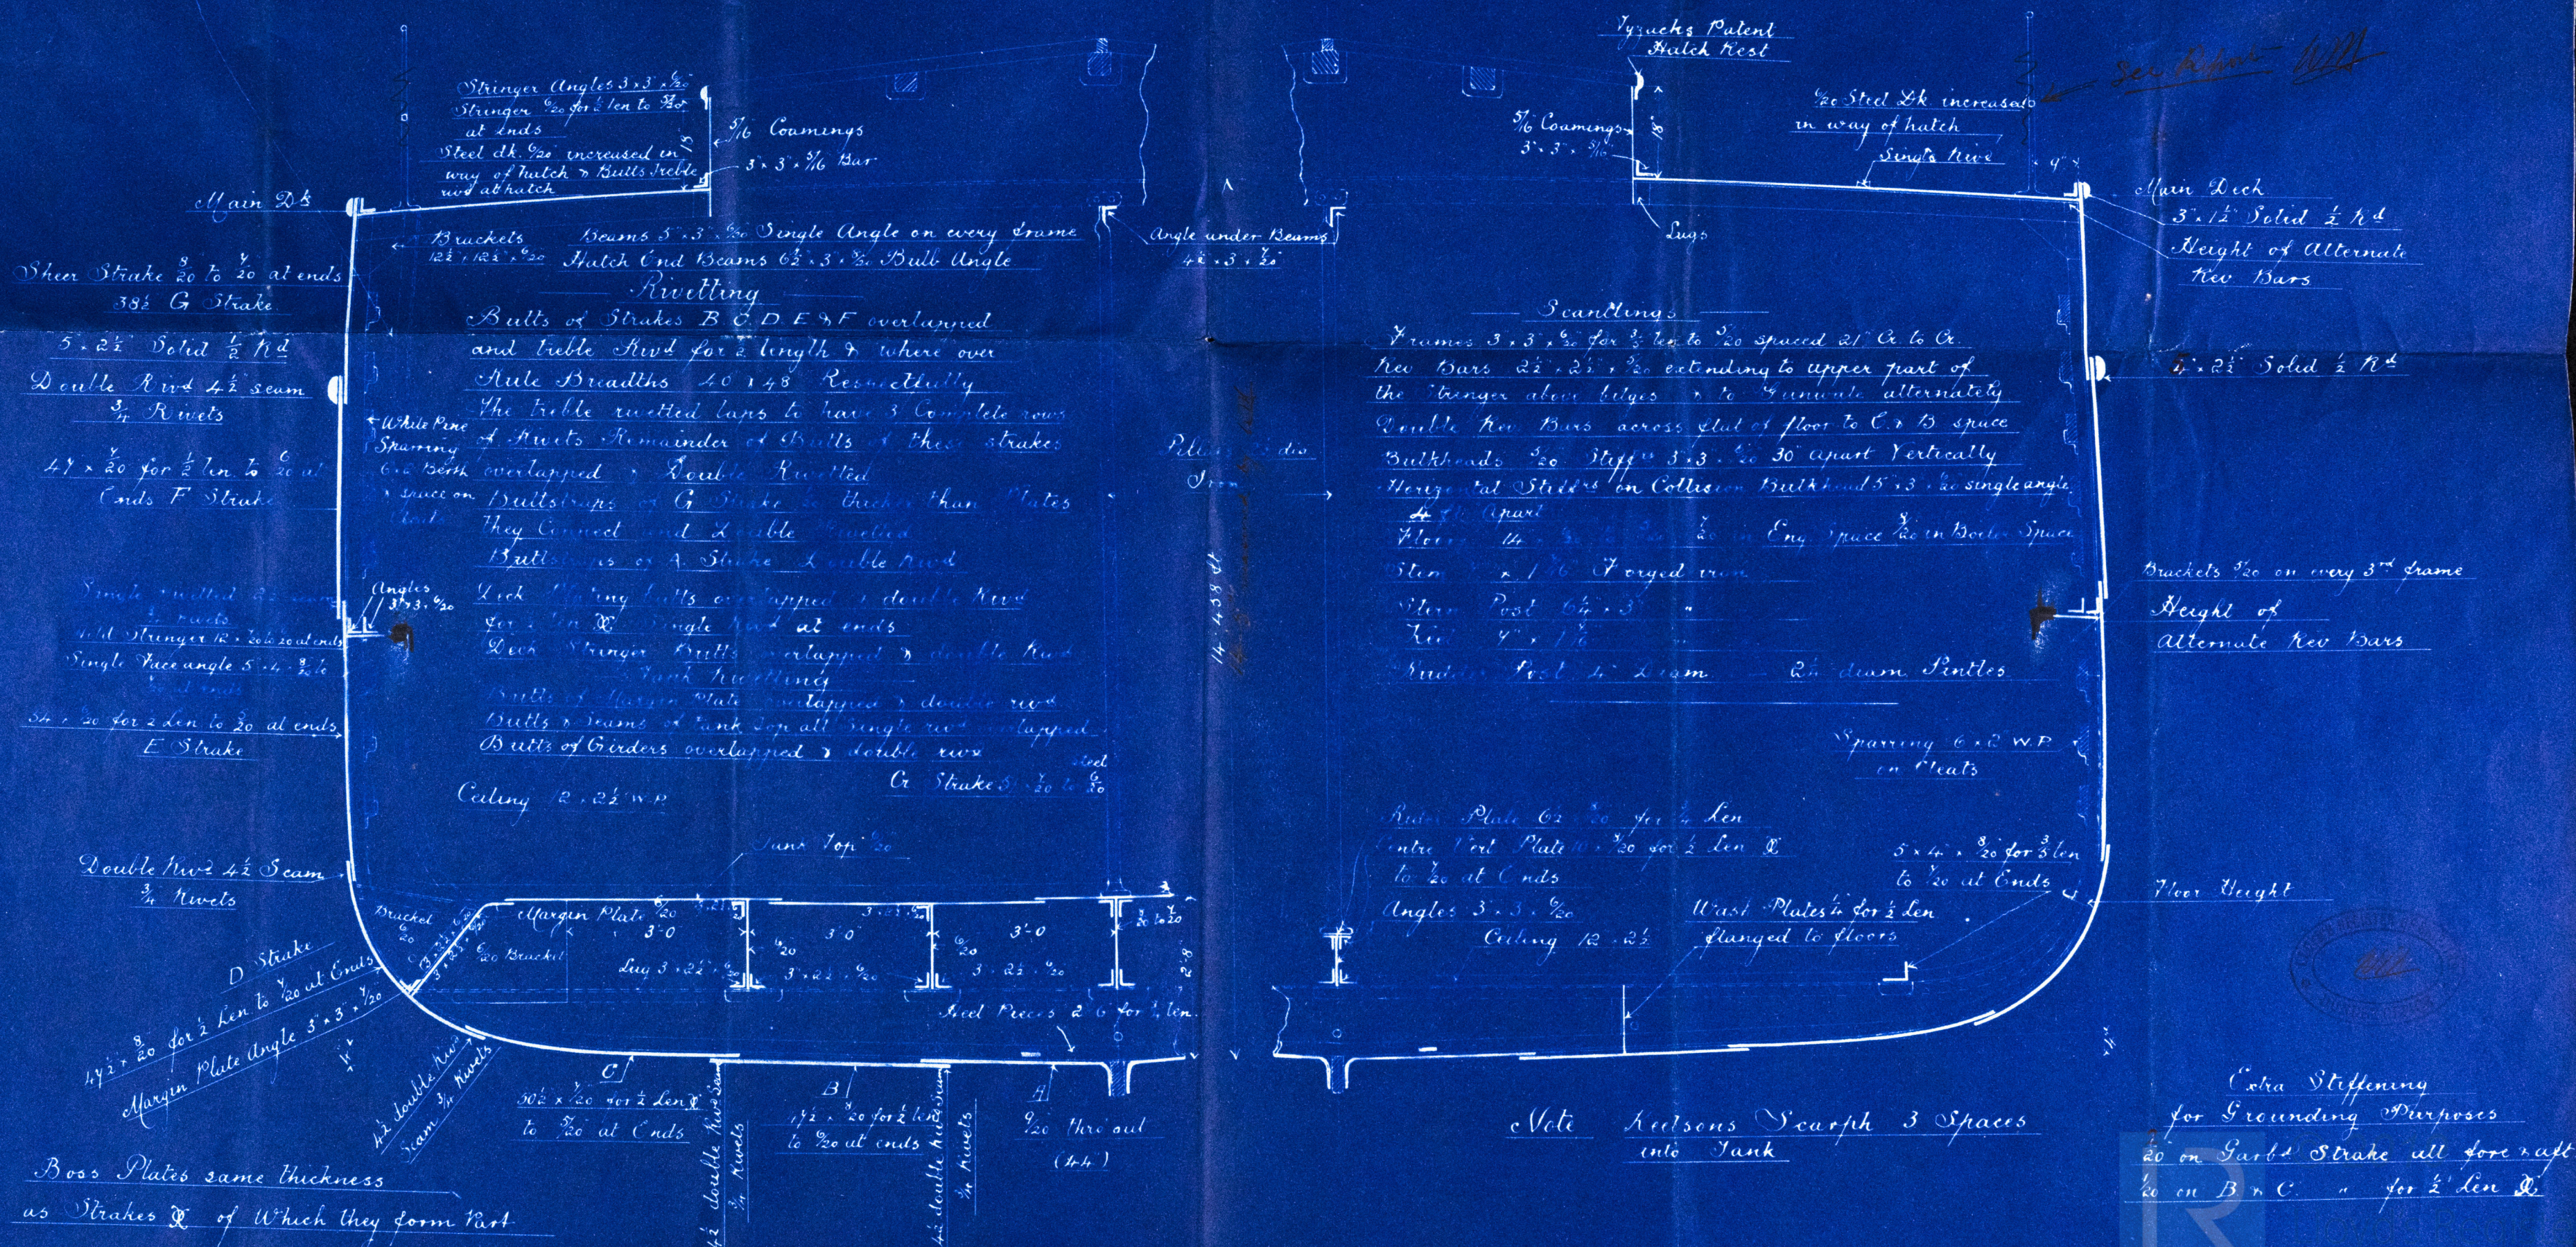

Extra Stiffening for Grounding Purposes
20 on Garb'd Strake all fore & aft
20 on B & C " for 1/2 len B

Midship Section
SS. "N^o 31"

J. Guthrie & Co
Protonne

Dun Rpt N. 6460.

Budy 15.75



© 2019

Lloyd's Register
Foundation

DW127-0135