

MARINE BOILER 11'-0" x 10'-0"

SCALE 1" = 1 FOOT

WORKING PRESSURE 130 LBS PER SQ. INCH
PLATES, RIVETS & STAYS OF SIEMENS MILD STEEL, TUBES OF IRON

JAMES NEILSON & SON
ALMA BOILER WORKS.
GLASGOW.

ALL COMBUSTION CHAMBER STAYS
SCREWED INTO BOTH PRTS, AND
NUTTED EACH END & SQUARE
WITH INSIDE PRT. SO AS TO AVOID
WASHERS ON FIRE SIDE

Main Boiler No. 2489
by
J. Neilson & Sons


W. Pressure 150 lbs

Machinery for Dundee

Gls Rpt. No. 16635

Dun 6460.

J. Duthie & Co

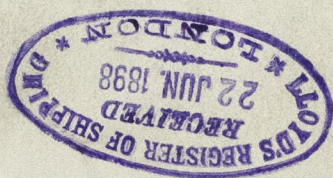

© 2020

Lloyd's Register
Foundation

DUN127-0137