





3.3.99

— S.S. No 151 —

— SHELTER DECK —

— SCALE  $\frac{1}{4}$  = ONE FOOT —

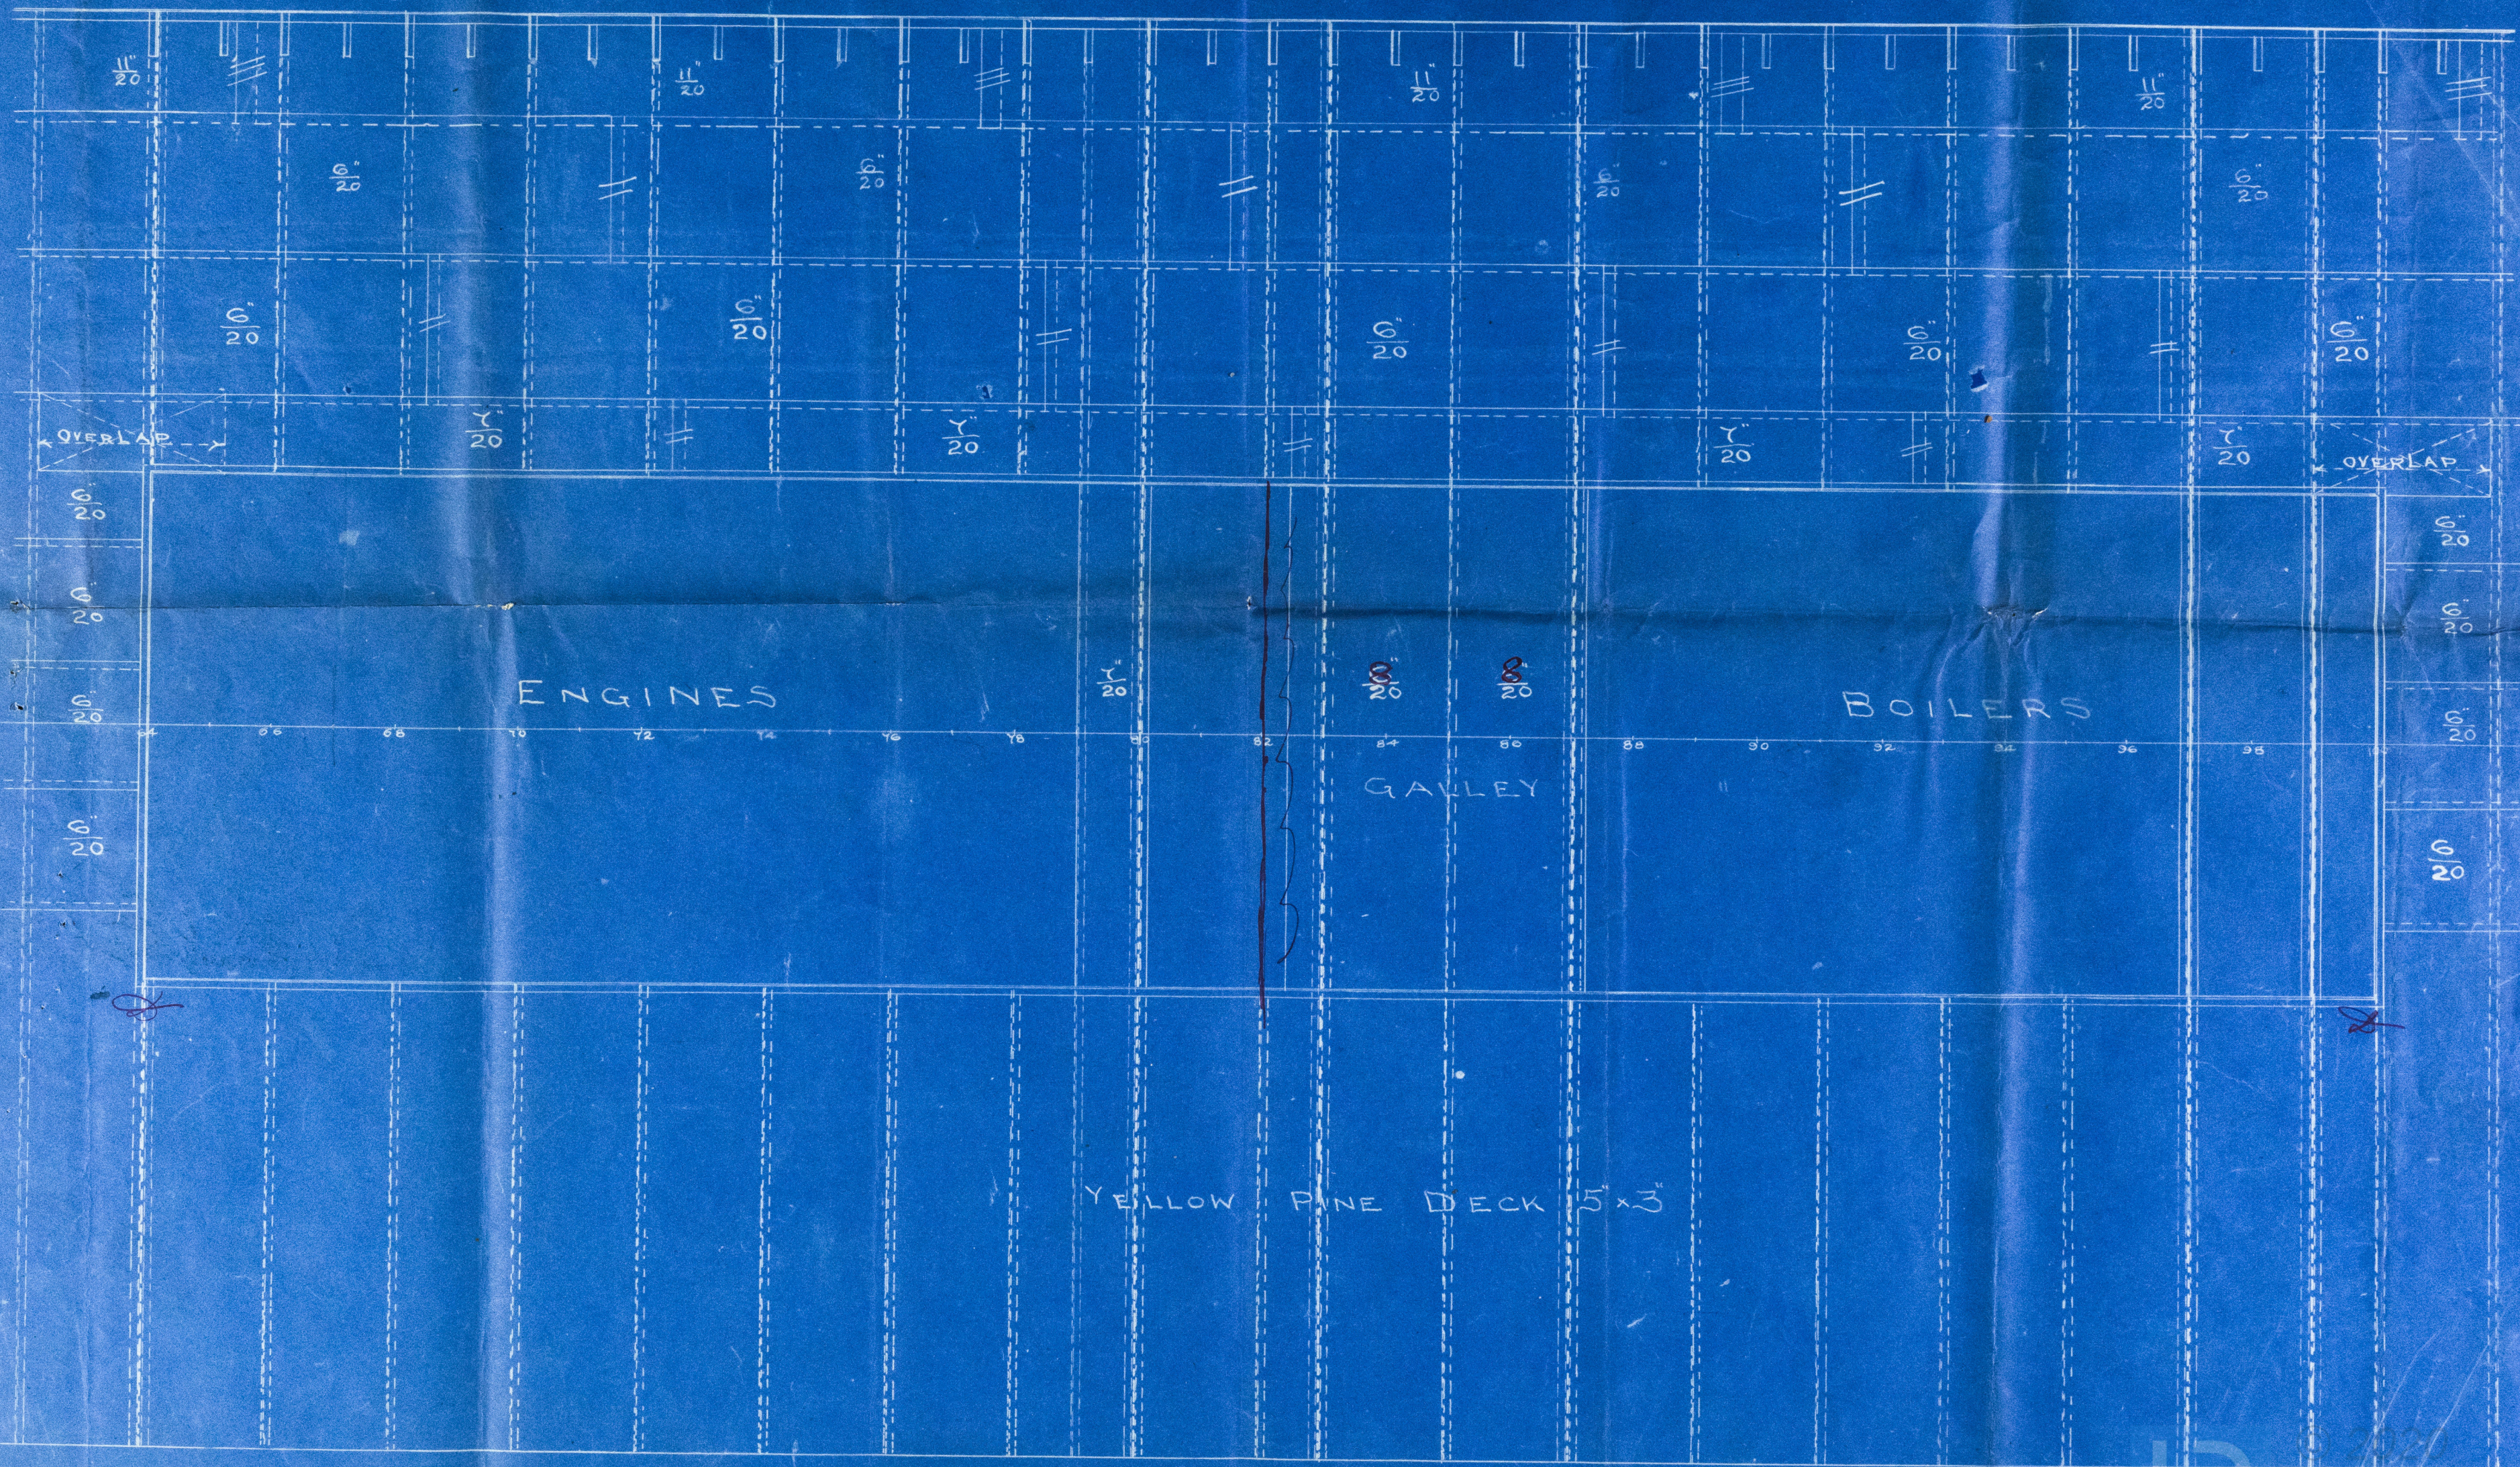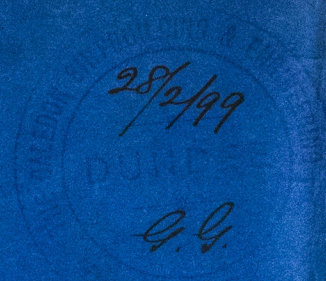

Lloyd's Register  
Foundation  
DUN 30-007




Cross-tie Plating  
Shelter Deck

Caledon W. Coys  
St. No 151

St. Caledonian  
Amended

Pen Rpt No 6642

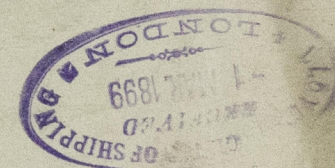

DUN130-0017



© 2020  
Lloyd's Register  
Foundation