




3.3.99  
21.3.99  
W.T. BULK  
BELOW

S S N<sup>o</sup> 151


UPPER DECK

SCALE  $\frac{1}{4}$  = ONE FOOT

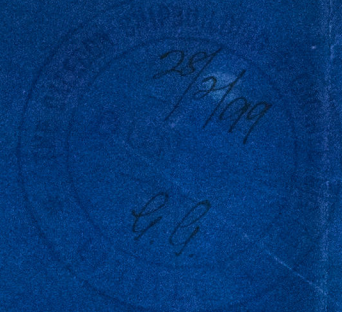

W.T. BULK  
BELOW

*Comings and hatches to all openings on this deck as for weather deck*

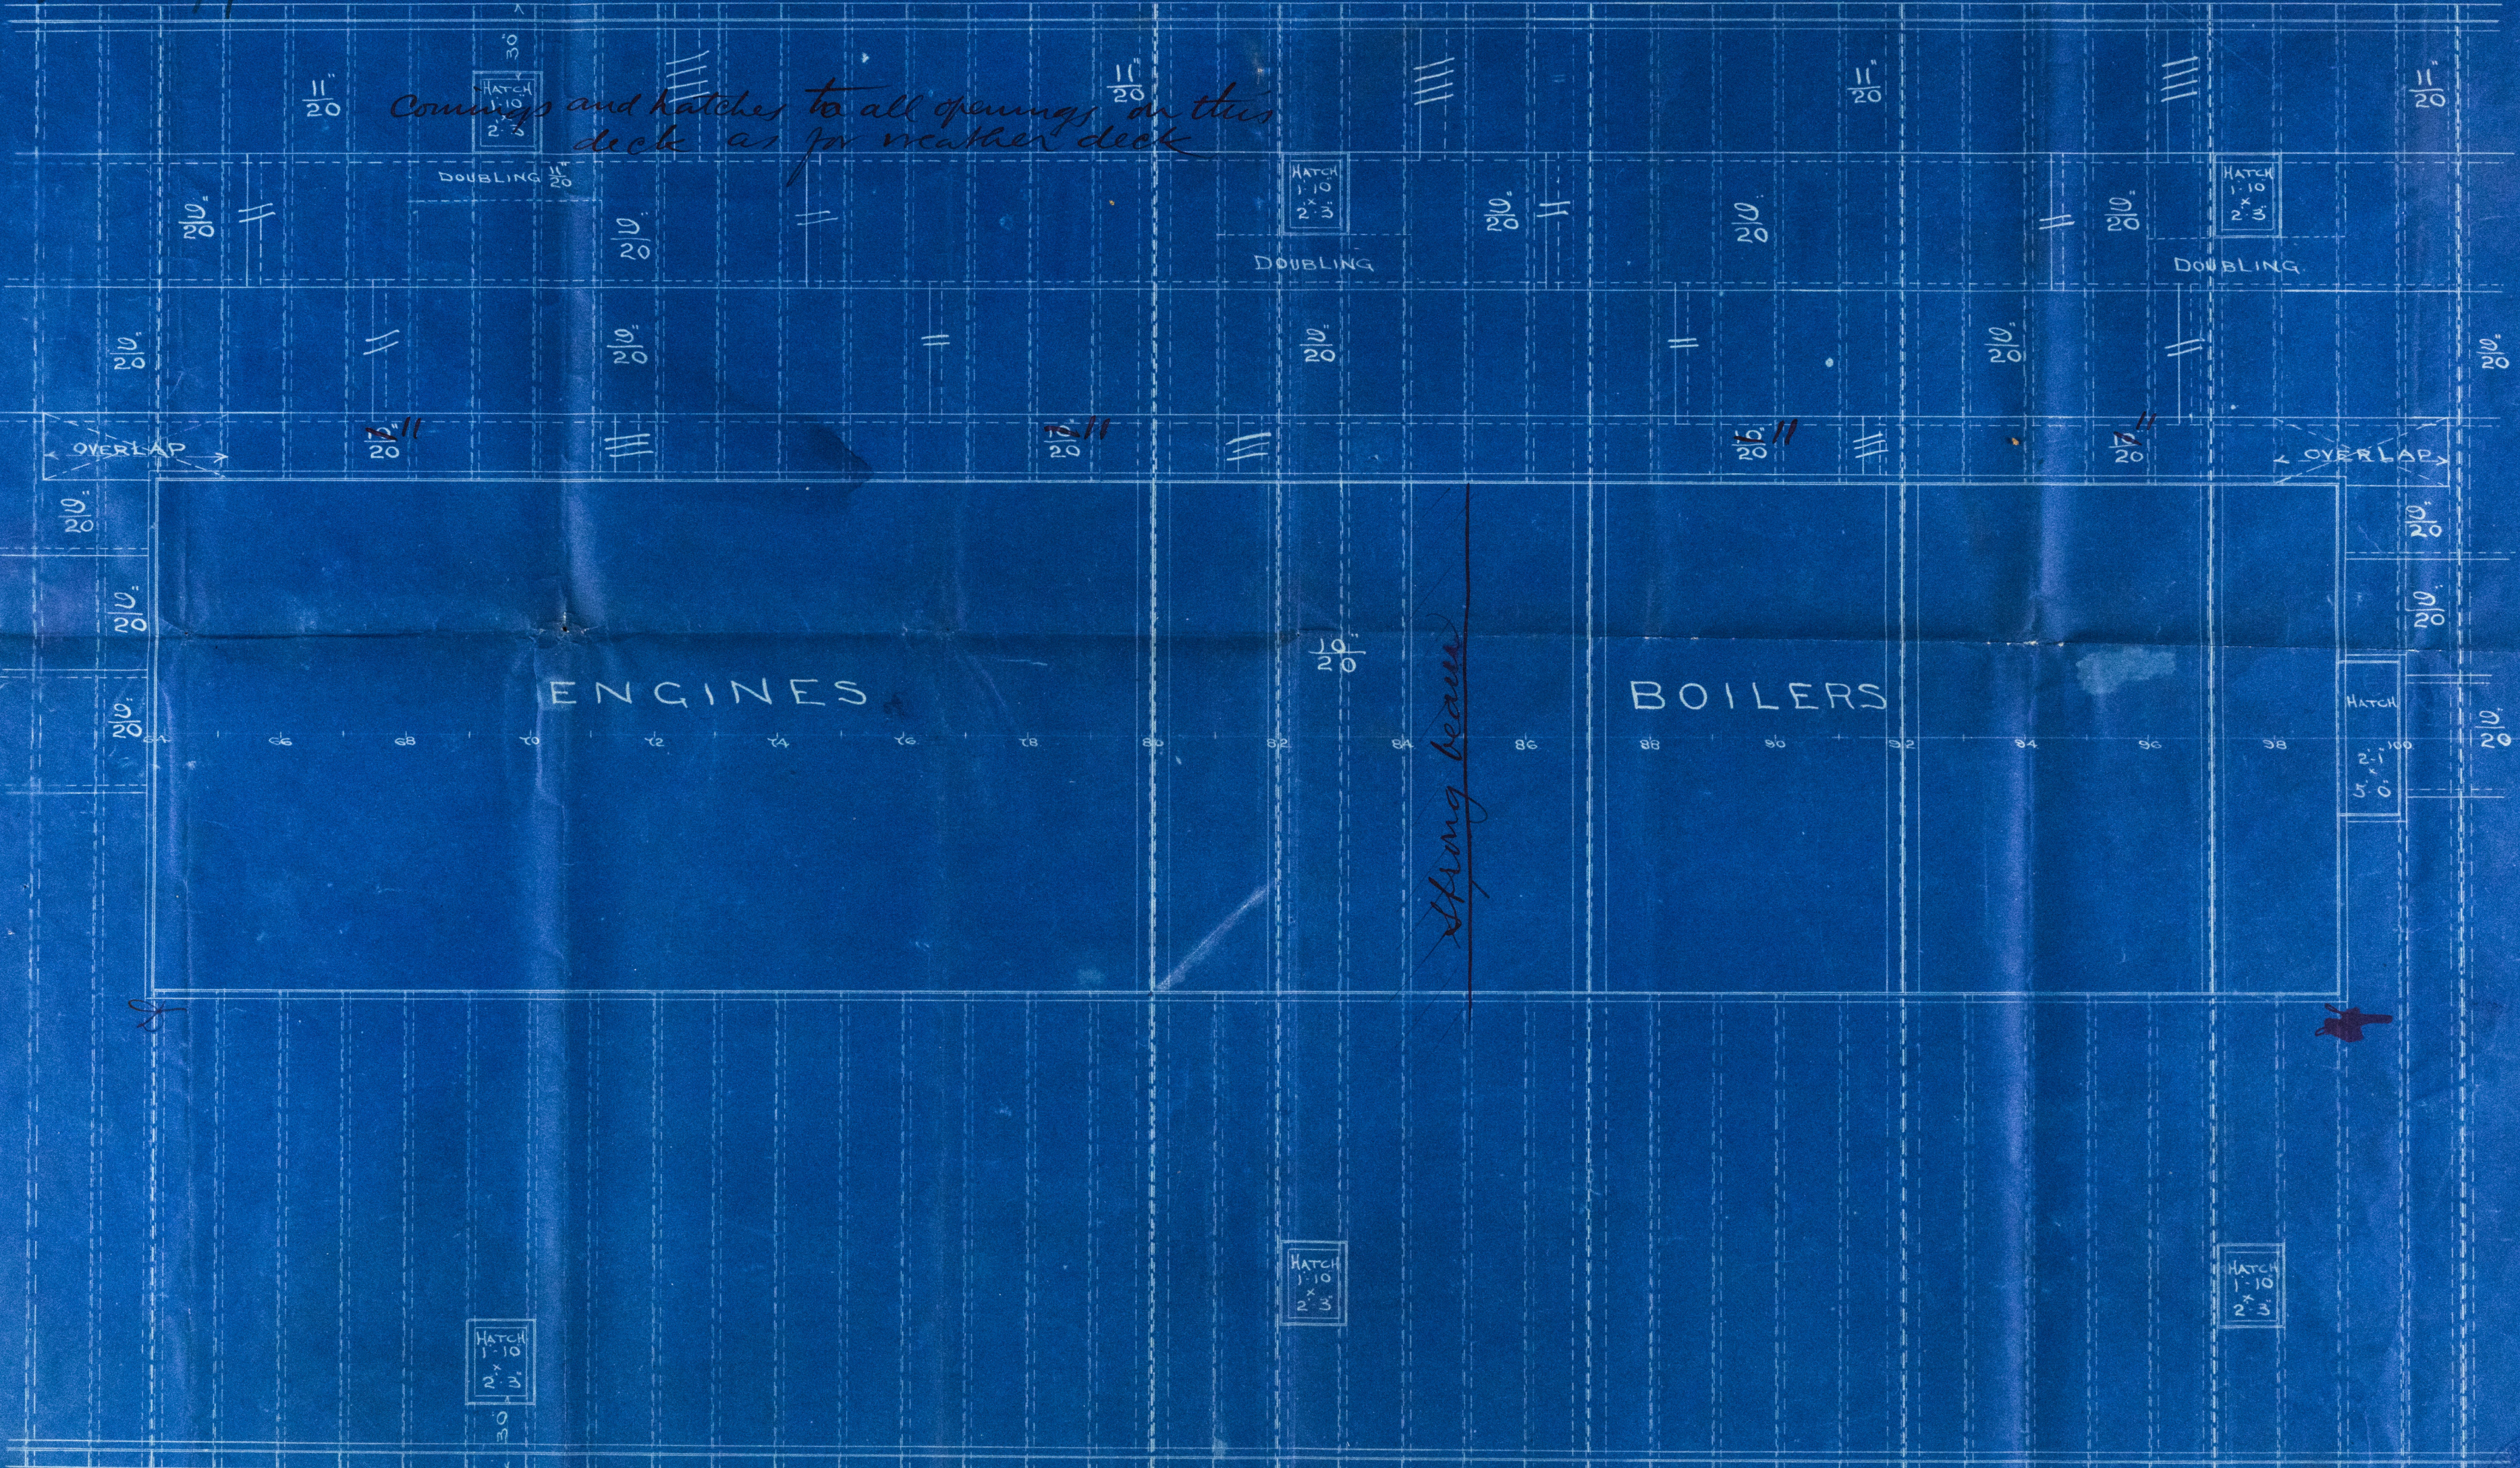


Lloyd's Register  
28.2.99  
DUNDEE-0012



Cross tie Plating  
Upper Deck

Calidon H. Coys  
SS No 151

SS Calcedonian  
Amended  
Dun Rho No 6642

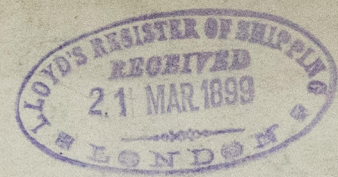

DUN130-0018



© 2020

Lloyd's Register  
Foundation