


Donkey Boiler in
4 Mot. Pk. "Sindia"

Boiler built
by Messrs
Dunlop Bell & Co
Liverpool in
1887

One Spring
Safety Valve
3" Diam


Vertical
Beam of Shell
13" drilled holes
2 3/4" pitch
Double riveted
lap 4" wide

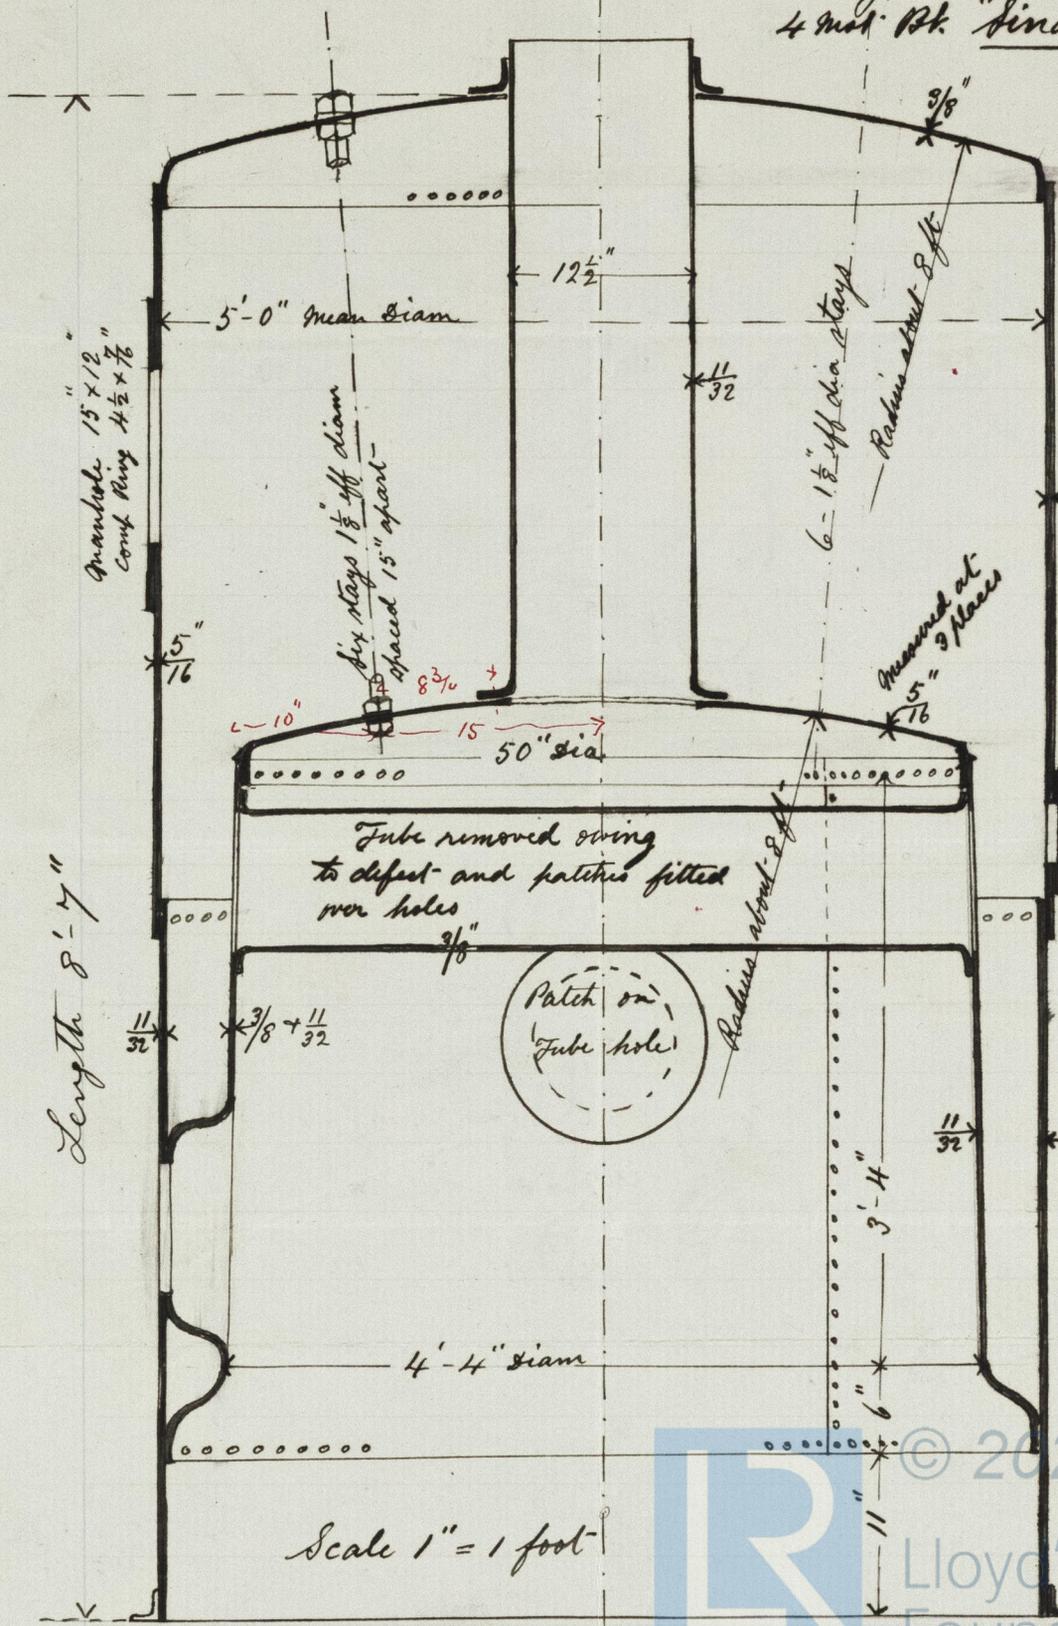

Manhole 15" x 12"
Cont. Ring 4 1/2" x 7/16"

Length 8'-7"

Scale 1" = 1 foot

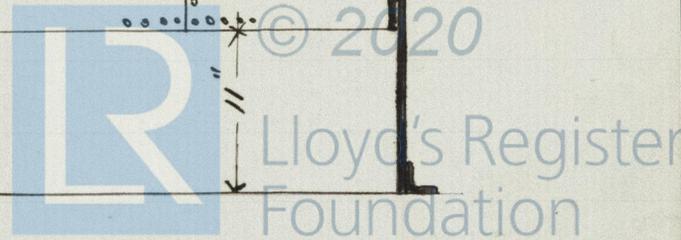

DUN130-0131