


Report No. 2019

Half Midship Section of a Wood Vessel of about 175 tons, proposed to be built by Mr. William Stibbly at Padstow, Cornwall, for Classification 12th. -
 Dimensions: Length (as per Sec: 39) 106 ft. Breadth 25 $\frac{1}{2}$ ft. & Depth 12 $\frac{2}{3}$ ft.
 No. 2

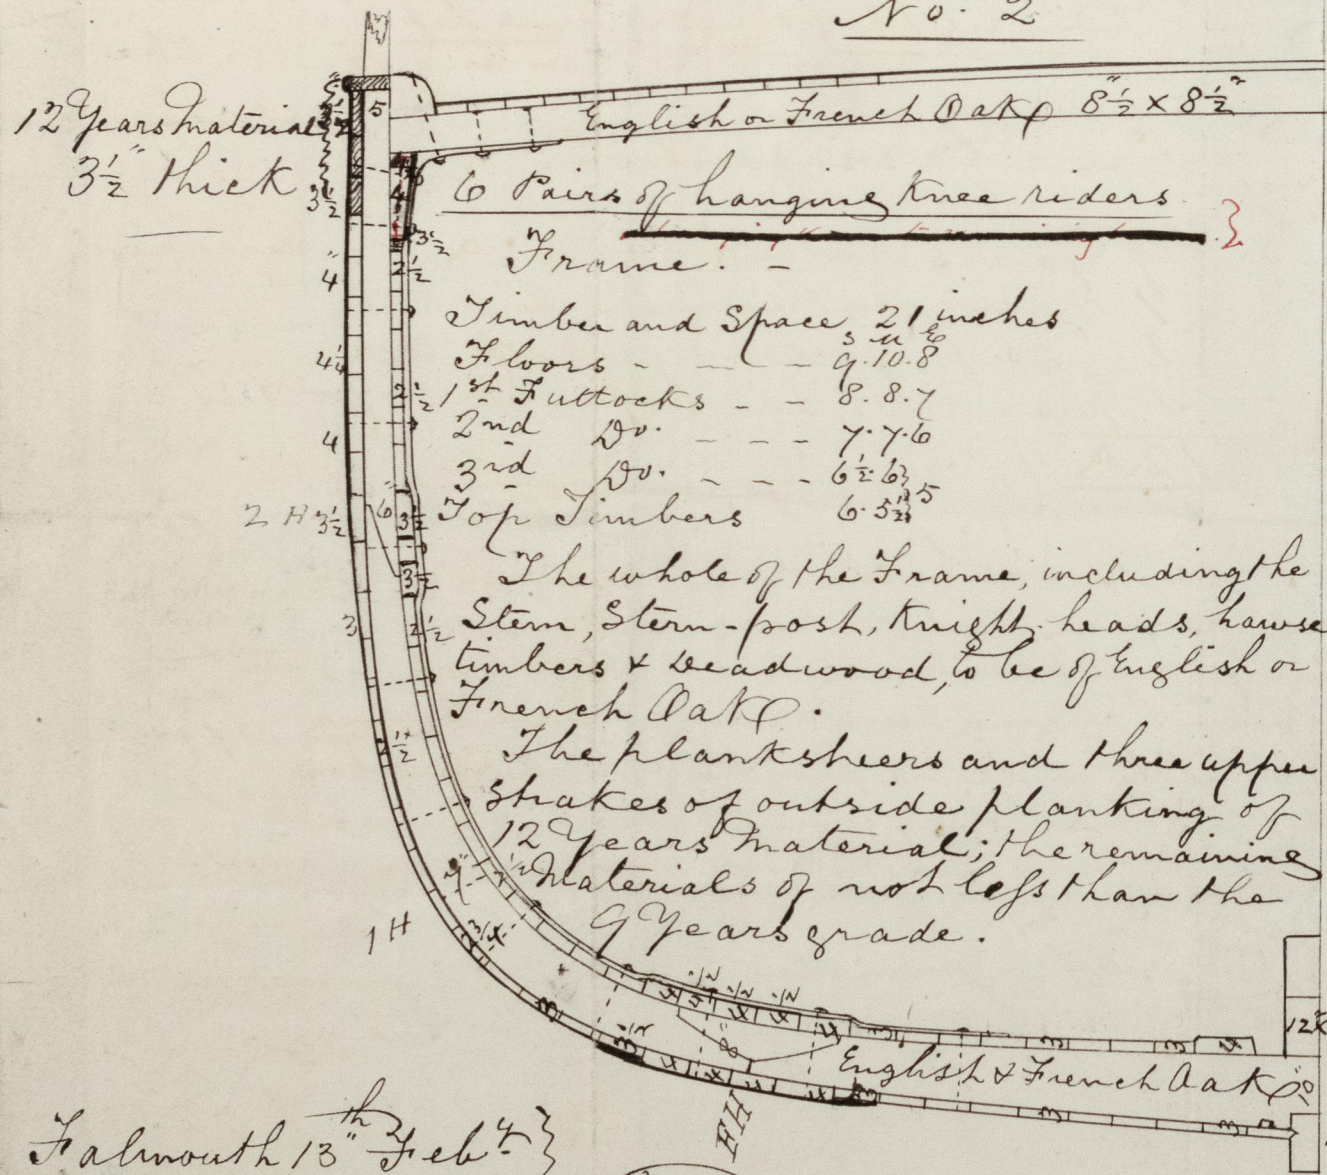

Over eight & under nine depths in length
 Rec 14/2/77

Per Classification. -

Viz. 9 Years under Table A.
 1 Year under the Mixed Material Rule.
 1 do. for Yellow Metal, as per Sec: 46.
 1 Year for Salt, as per Sec: 37.
 12 A (9 & 12 Years Material)
 Salted cf.

It is submitted, for the Committee's consideration and approval, that the extra thickness in the Clamps and planking - together with 6 pairs of Iron hanging knee riders fitted as shown on Sketch, will be found sufficient compensation for the omission of iron plates on frames, or rather to render their introduction unnecessary.

Falmouth 13th Feb 4th 1877. }
 (W.B.)

15/2/77
 Lloyd's Register Foundation