

2 STEEL BOILERS MARKED H

SCALE 1 INCH TO THE FOOT

DATE SEPTEMBER 1888

PLATES OF SIEMENS-MARTIN
MILD STEEL RIVETS OF STEEL

ALL MAN & HANDHOLES TO HAVE

STRENGTHENING RINGS AROUND THEM



ALL RIVET HOLES DRILLED IN PLACE AND
THE BURR REMOVED WHEN PLATES ARE TAKEN APART

WORKING PRESSURE 150 LBS



TESTING PRESSURE 300 LBS

To Pass Board of Trade & LLOYD'S

BOILER SHELL RIVETING
SCALE 3 INCH TO THE FOOT

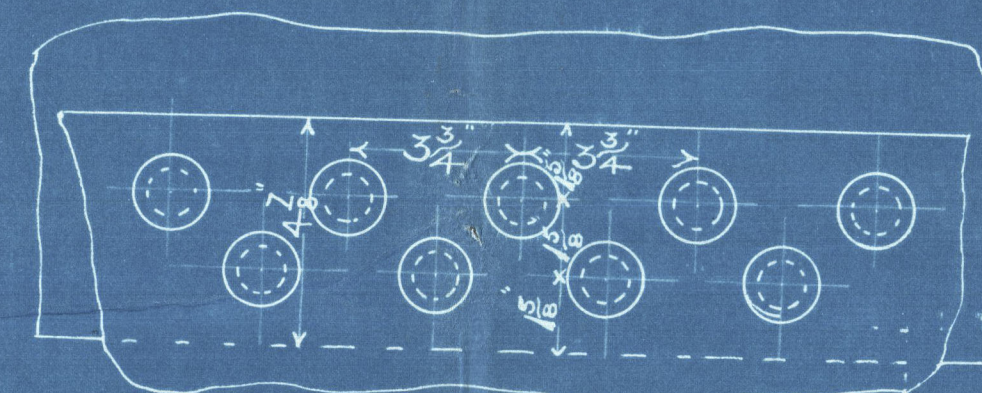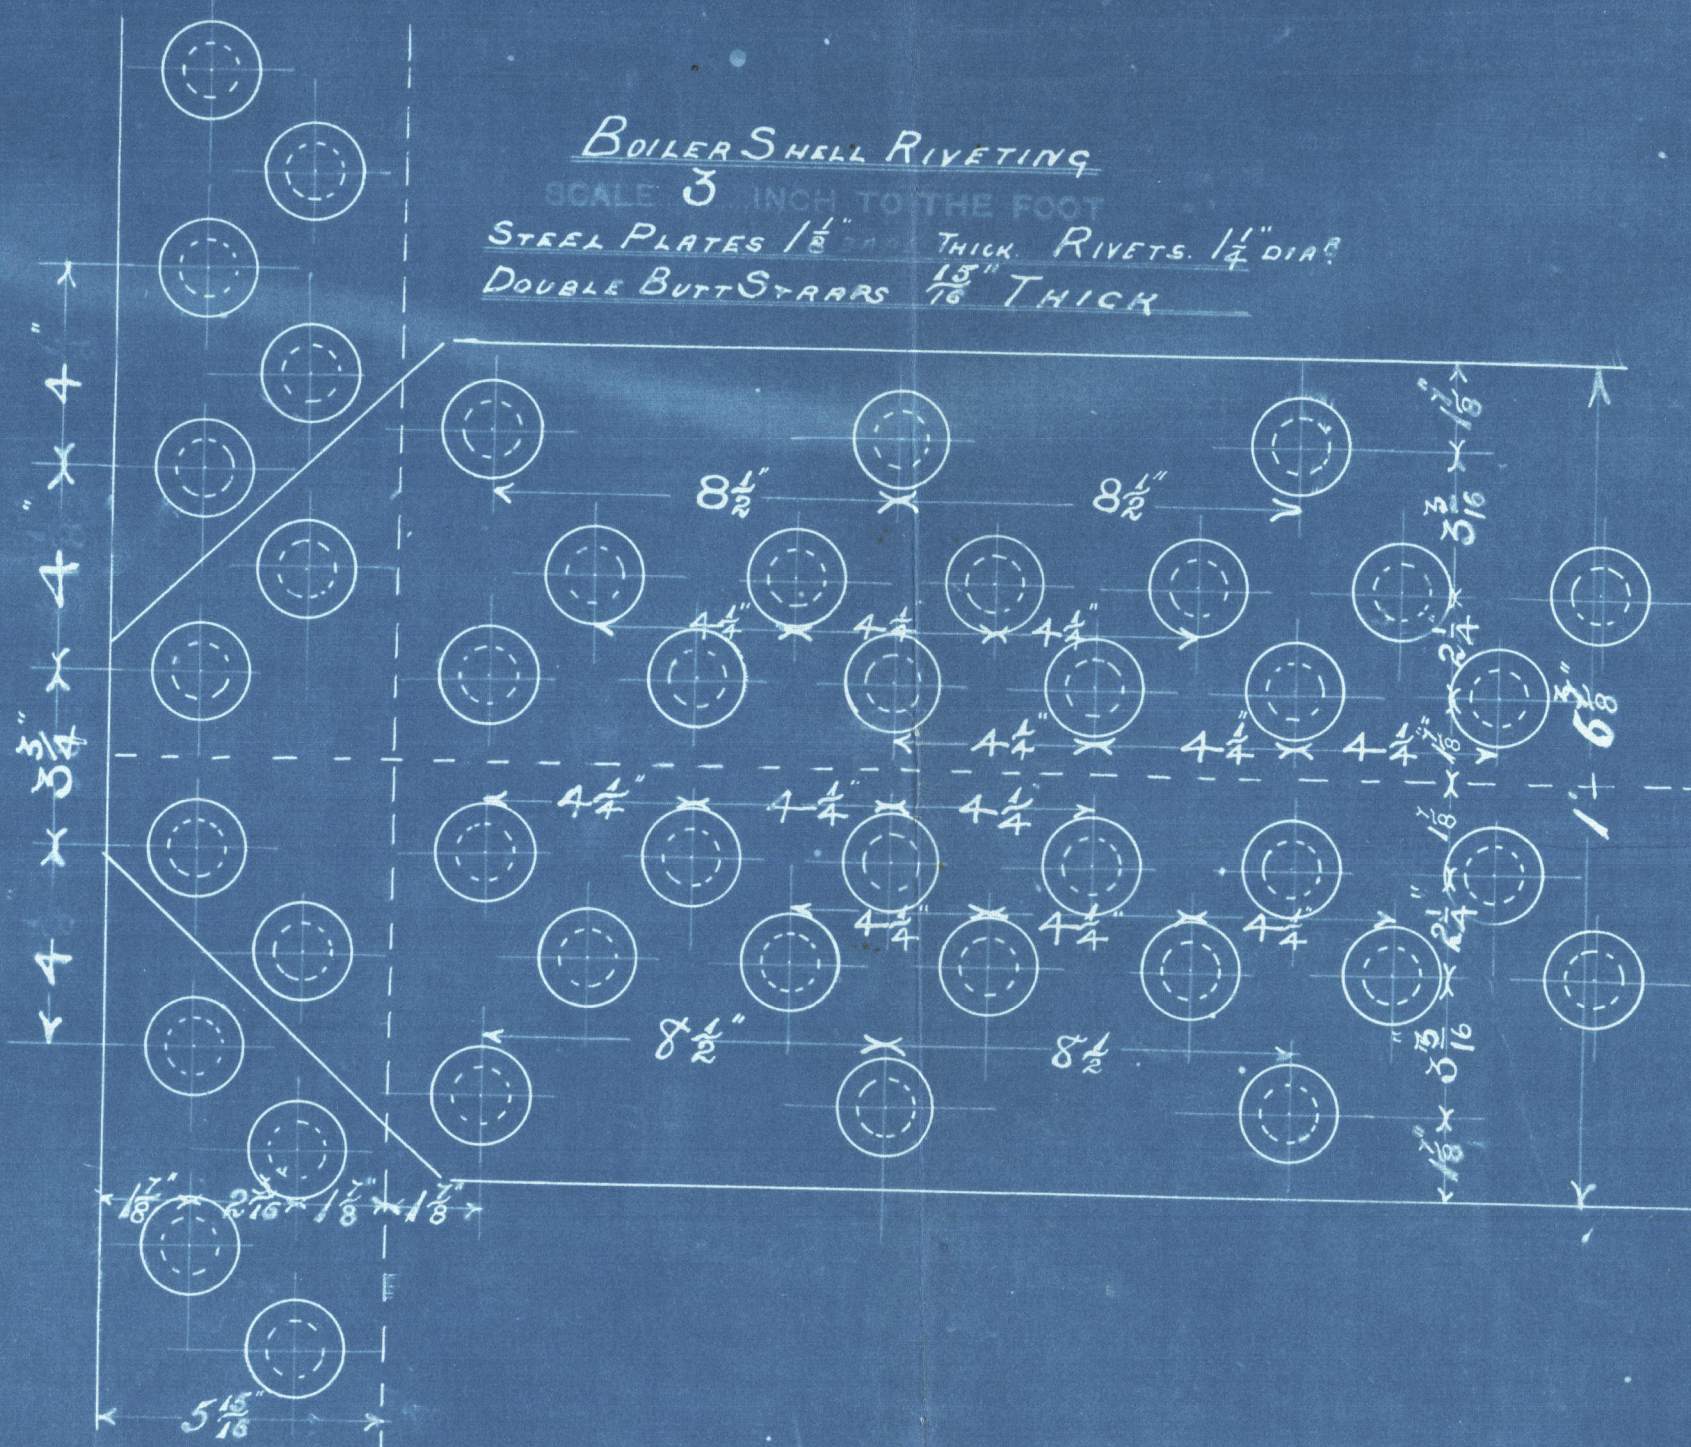

DOUBLE-RIVETED LAP-JOINTS OF FRONTS & BACKS
SCALE 3 INCH TO THE FOOT

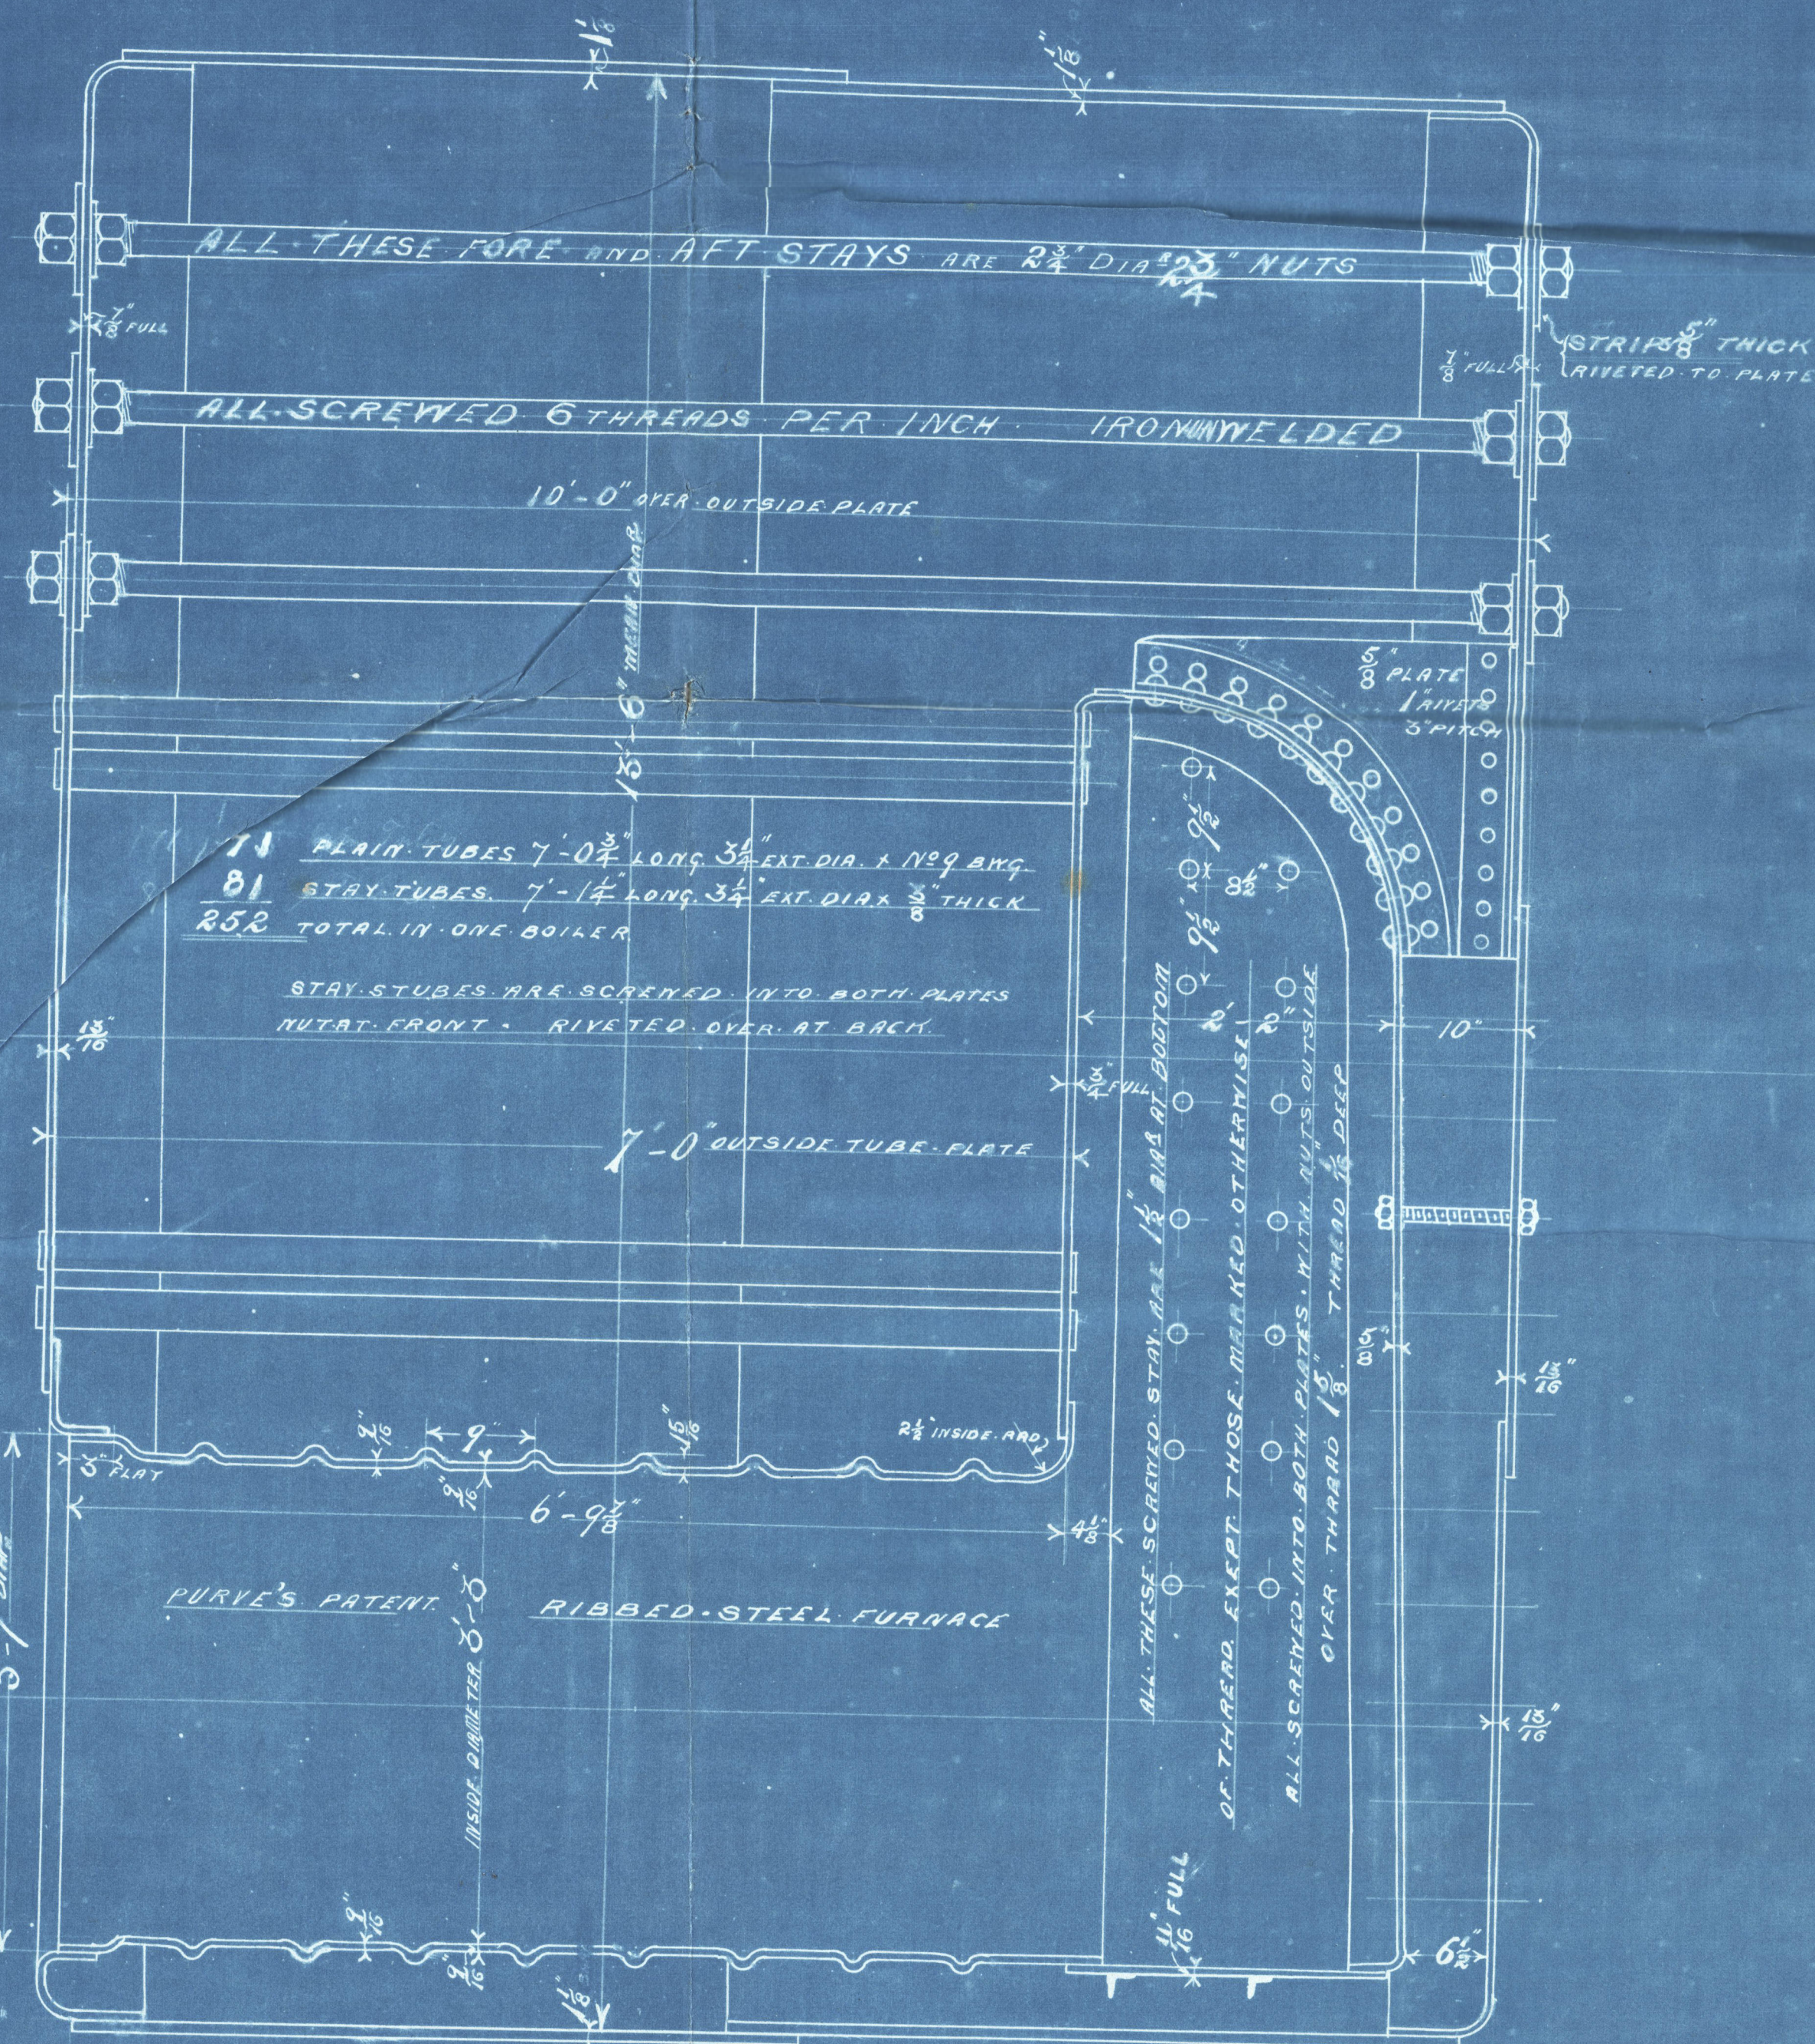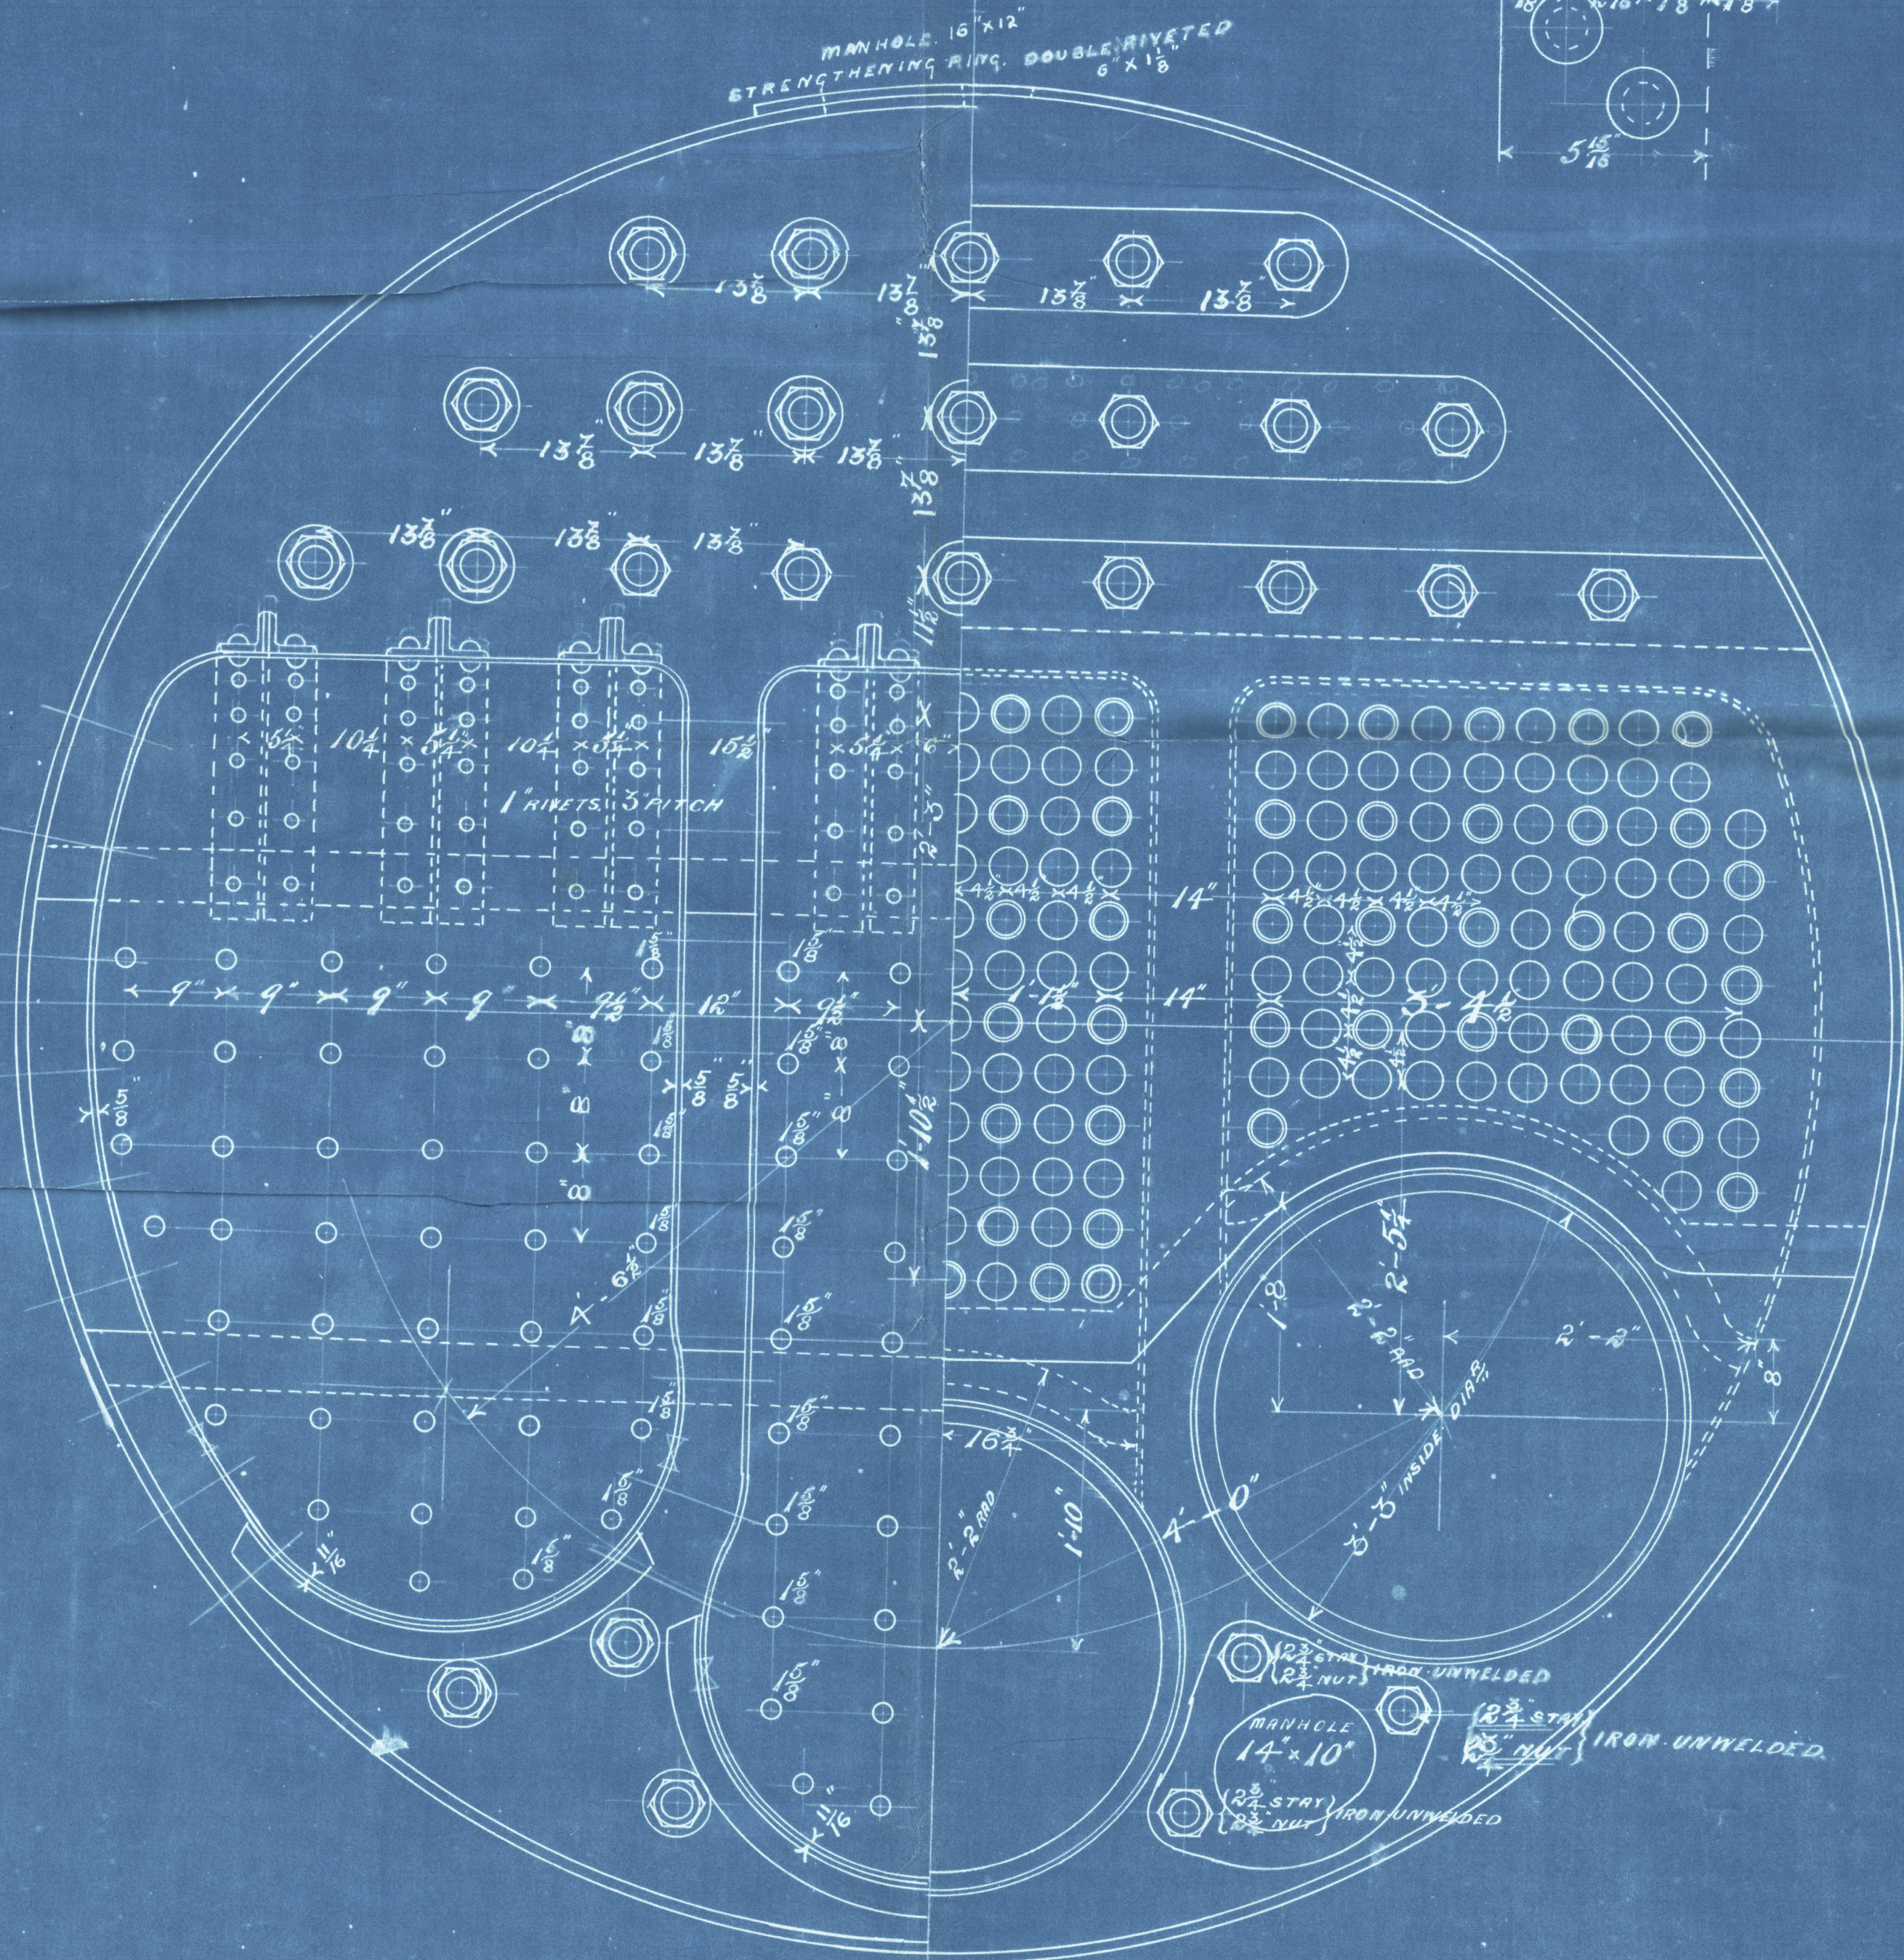

Thos. Hawley & Co 8/8 No 45
Altered plan of
holder to meet B of I
requirements.



FAL135-0005



© 2020

Lloyd's Register
Foundation