

THU 15 NOV 83  
TUE 20 NOV 83



FOR DOZ  
50 NOV 83  
BRIDGE STREET LEAMING


Scale 1/4" = one foot.

Sal - 3221

M. Sandoz

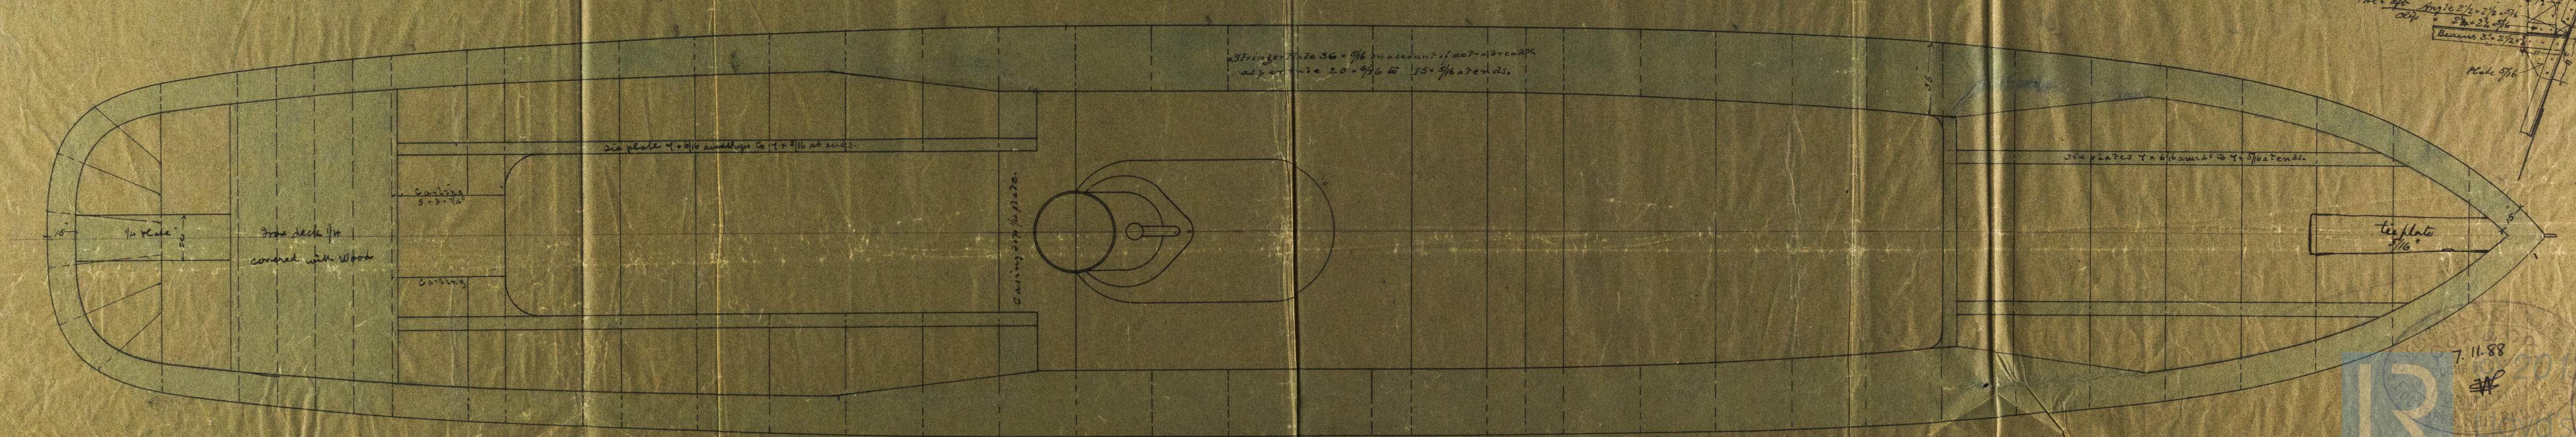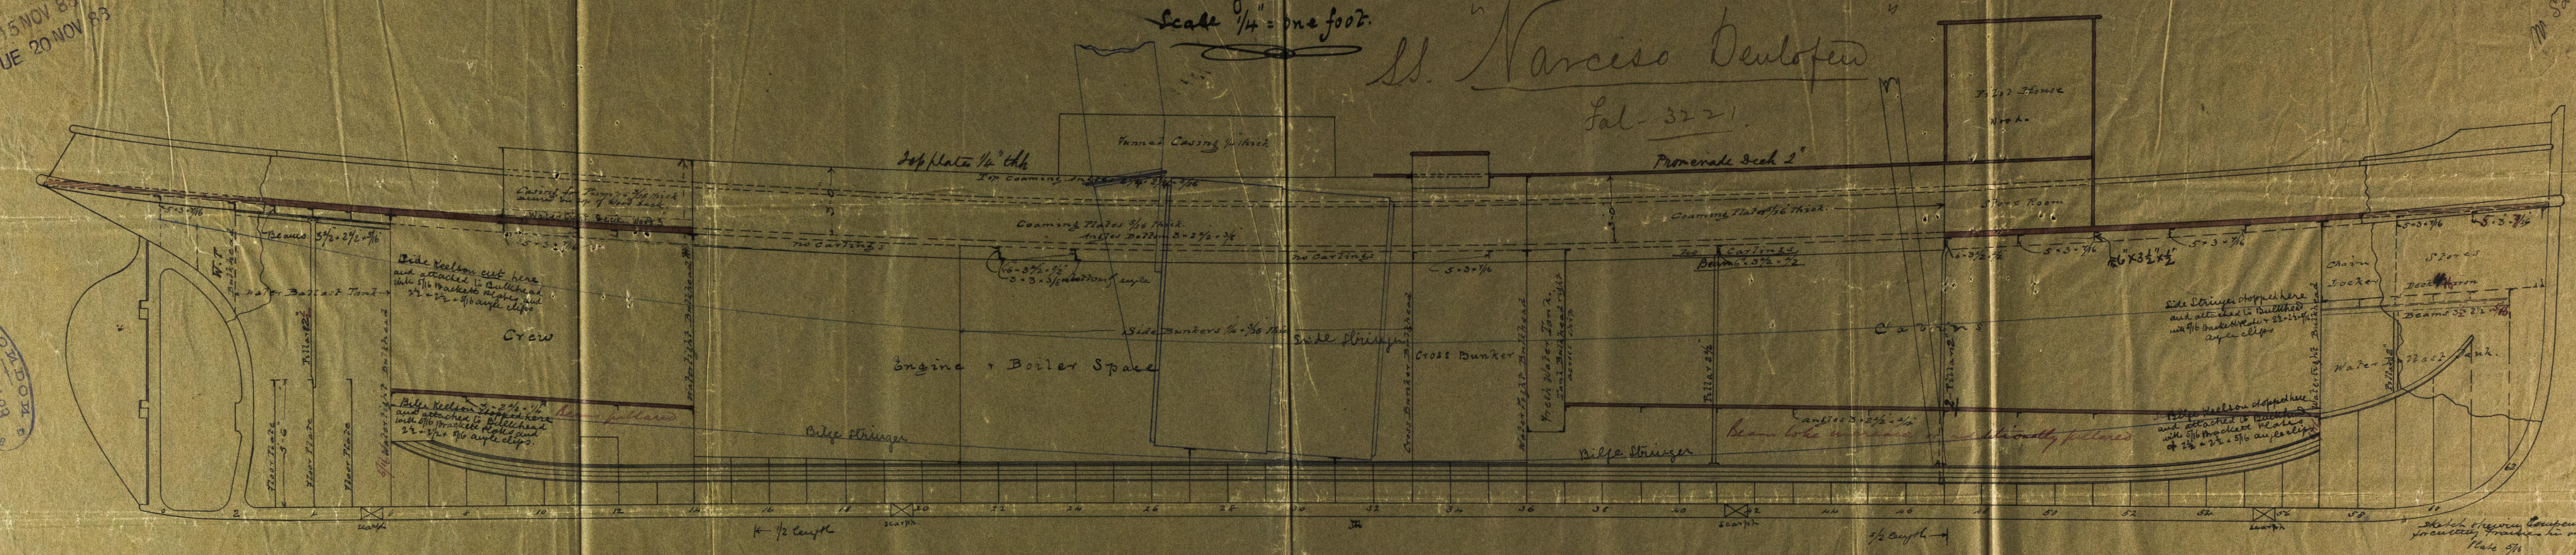

7. 11. 88  
Lloyd's Register  
FAL 35-0038