
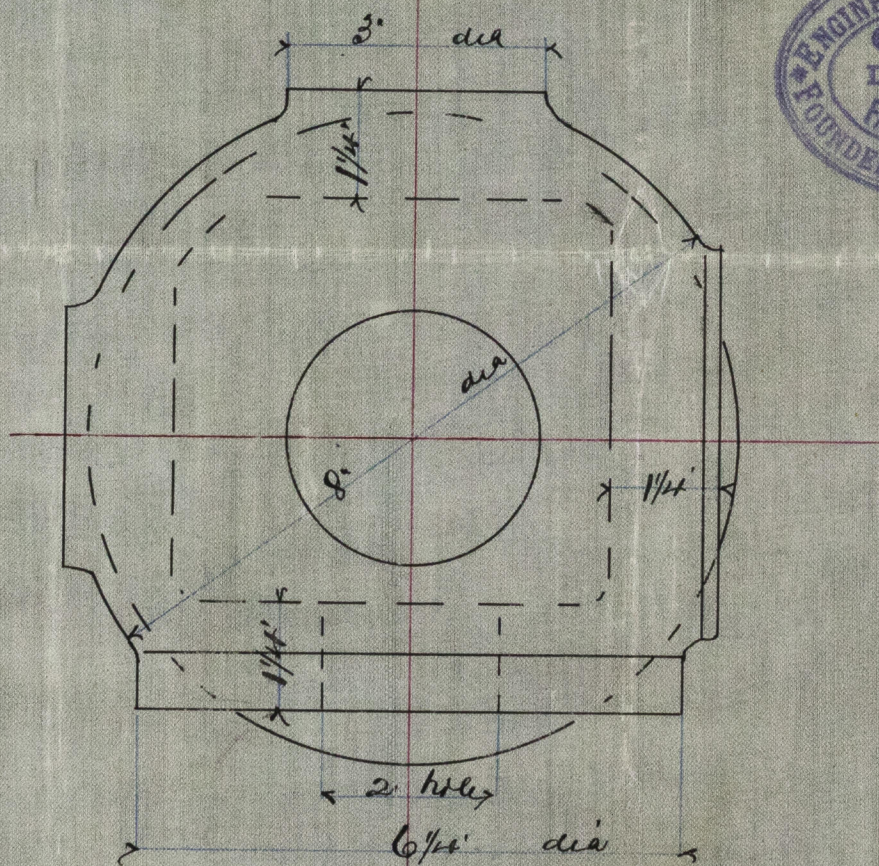


Let 12. 4. 89 No 3221

Cast Iron Chest for Boiler Mountings

N.P. 150 lbs.

for Boiler for Eng. No. 39.

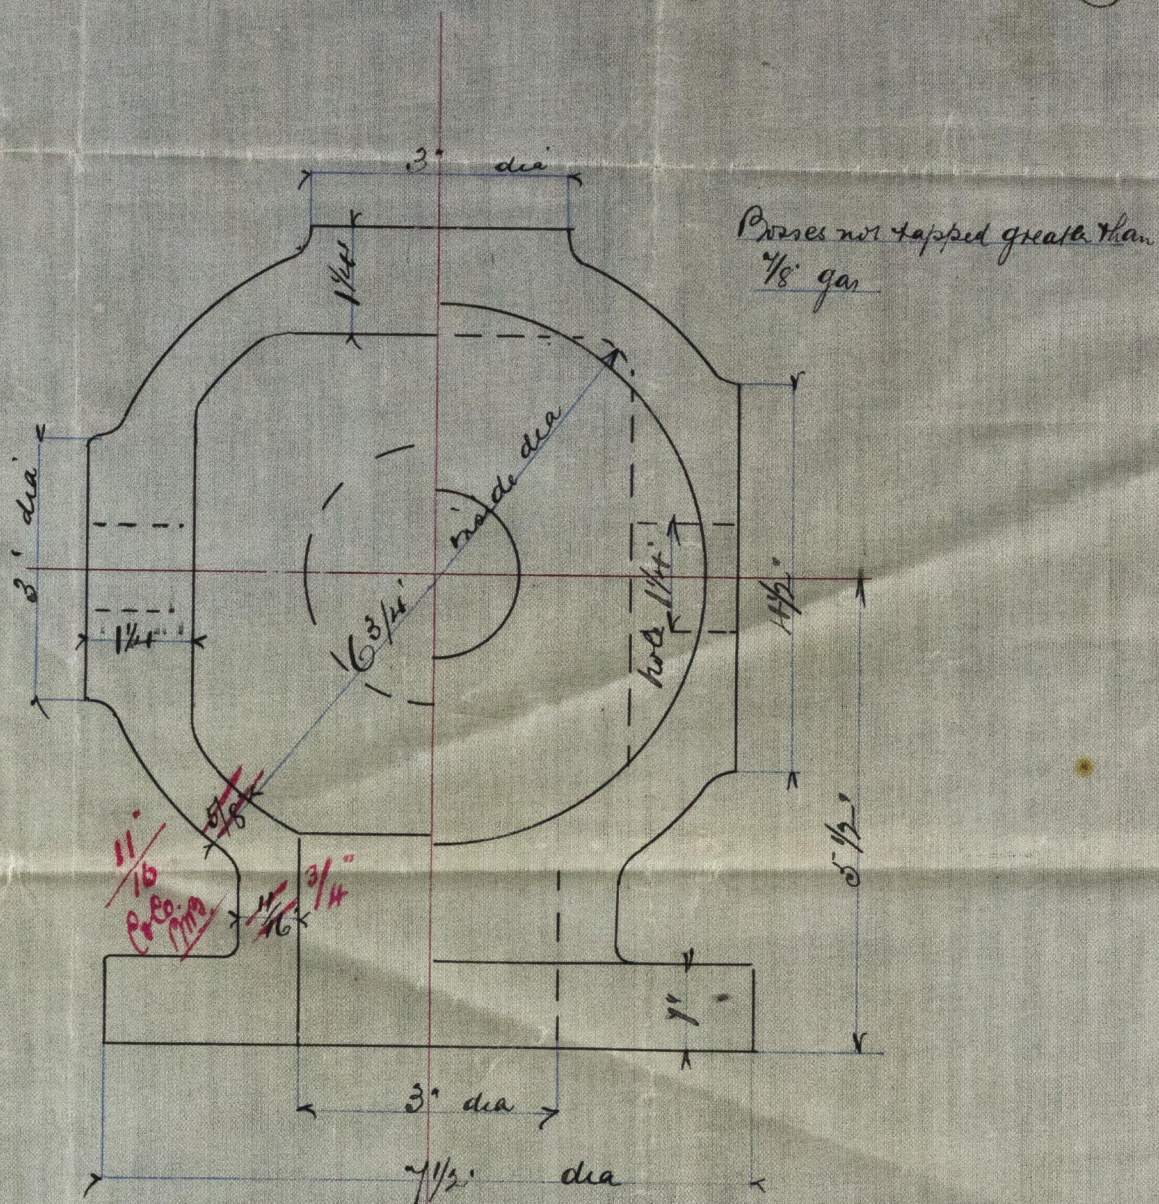

Let 12. 4. 89



© 2019
Lloyd's Register
FALMOUTH, ENGLAND

FALMOUTH, ENGLAND