



Ltr. 6/5/89

Stay 2 1/2" screw

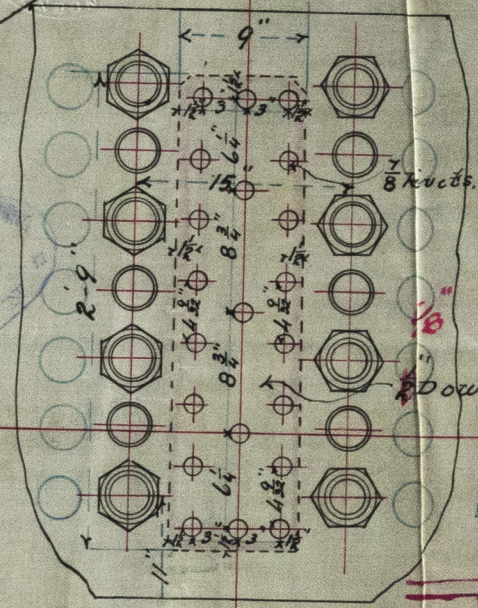


Dowling Plate

Stay 2 1/2" screw

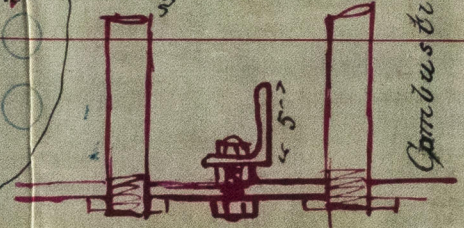

Combustion Chamber

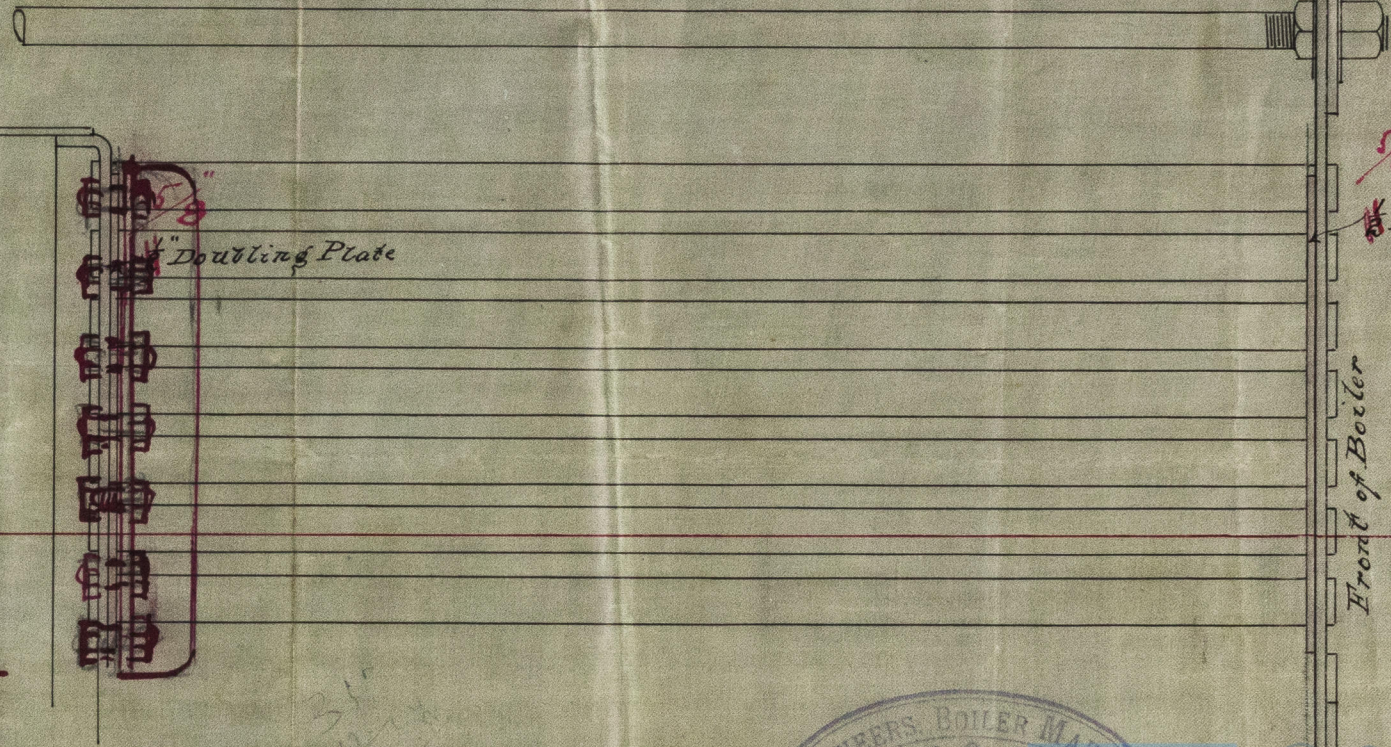

Dowling Plate

Front of Boiler

No 3221


Correspondence
P. 6th May 89

Boiler for Engines No 39

Tracing Shewing Proposed Stiffening of Tube Plates

—Scale 1" = one foot.—

N.A.
4.5.89

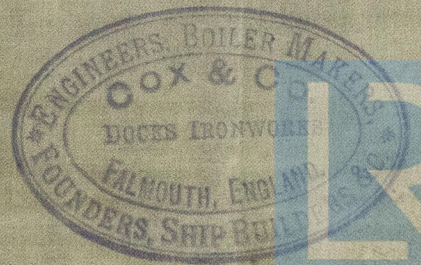

© 2019

Lloyd's Register
Foundation

FA4135-0041