


'Tongshan'

Fal 3257.

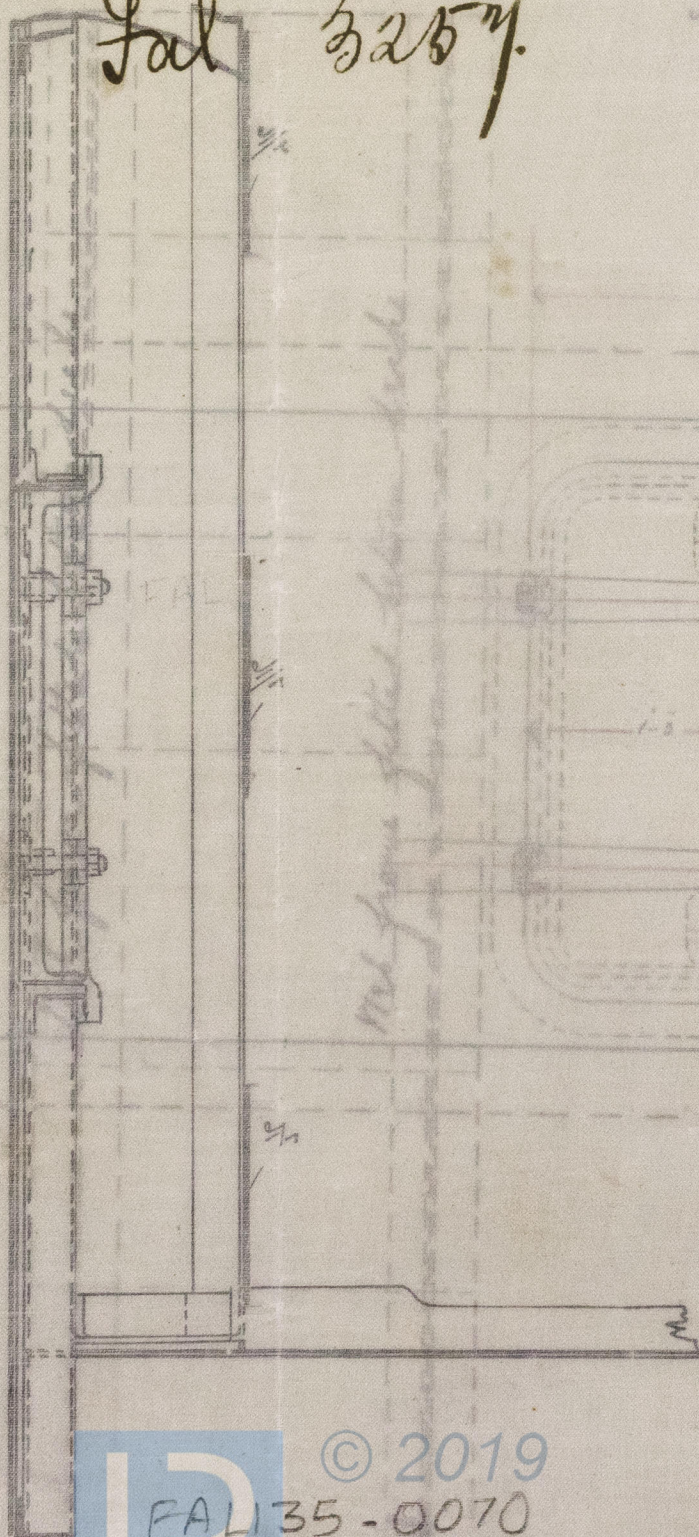

© 2019

FAL35-0070

Lloyd's Register  
Foundation






MON 16 SEP 89

# Watertight doors for cargo Ports

Scale 1 to one foot

Sept 13<sup>th</sup> / 89


LL No 47

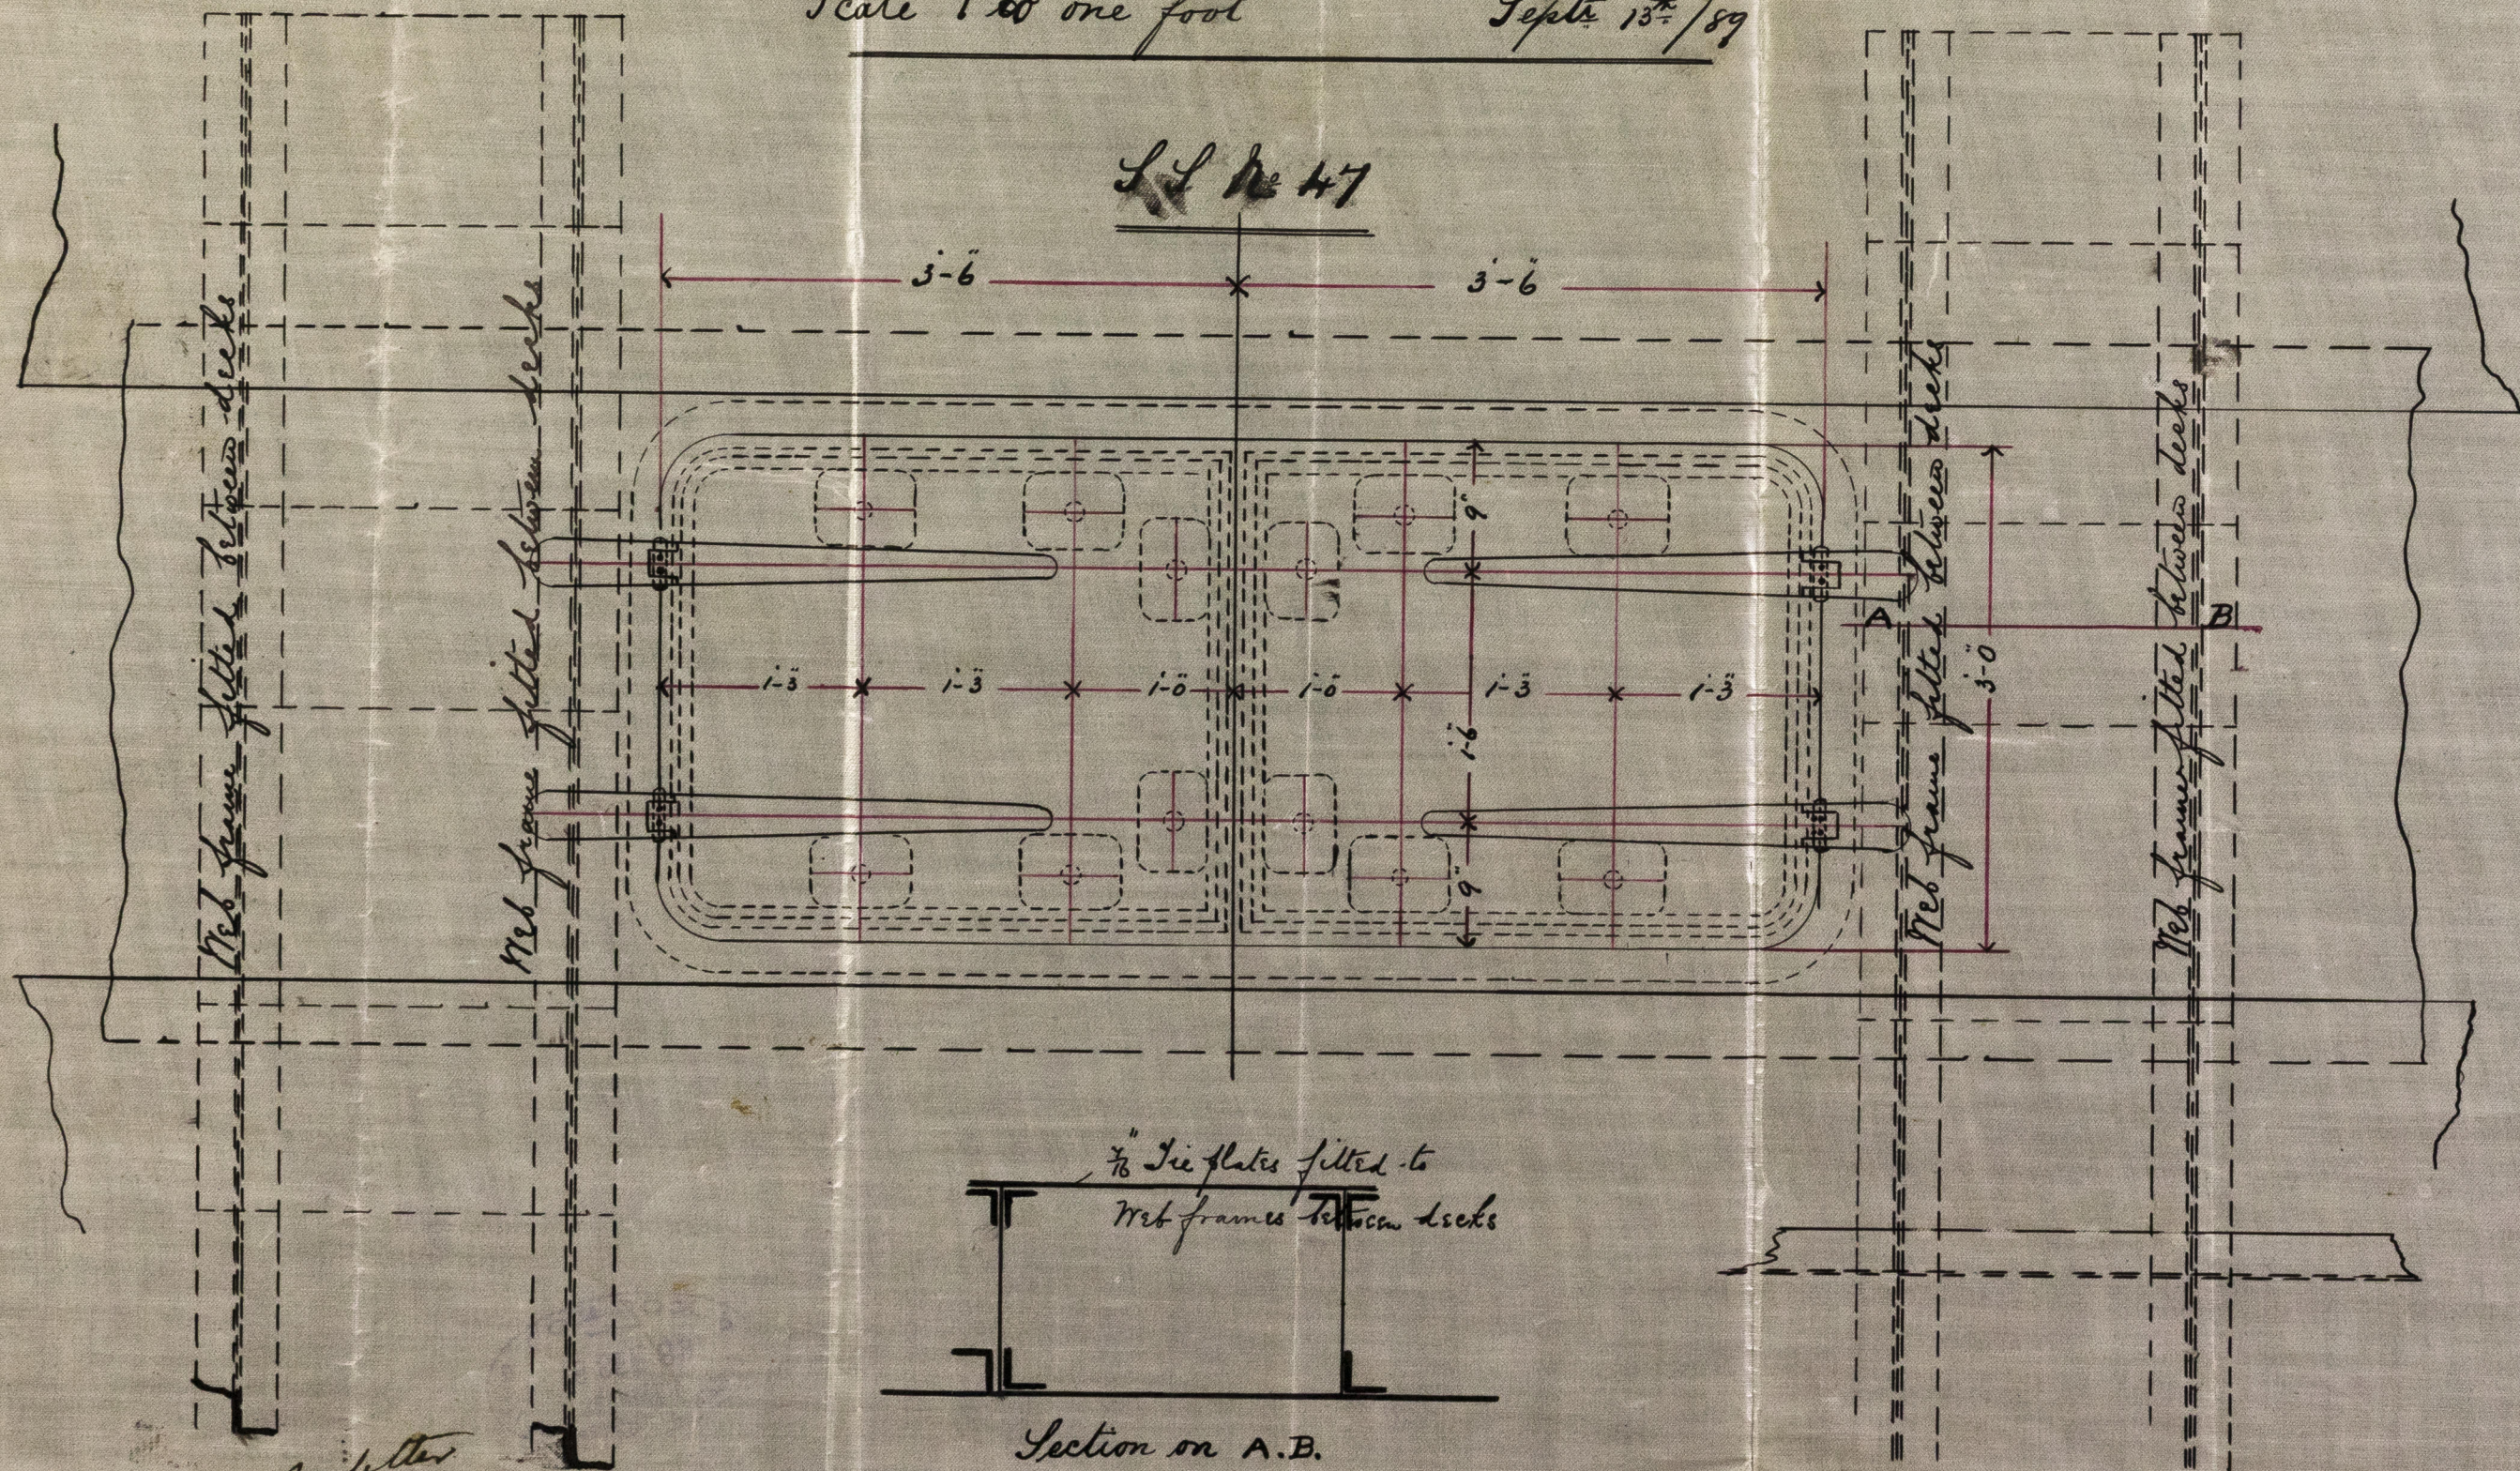

7/8" Tie plates fitted to  
web frames between decks

Section on A.B.

See letter  
16/9/89  
D.B.

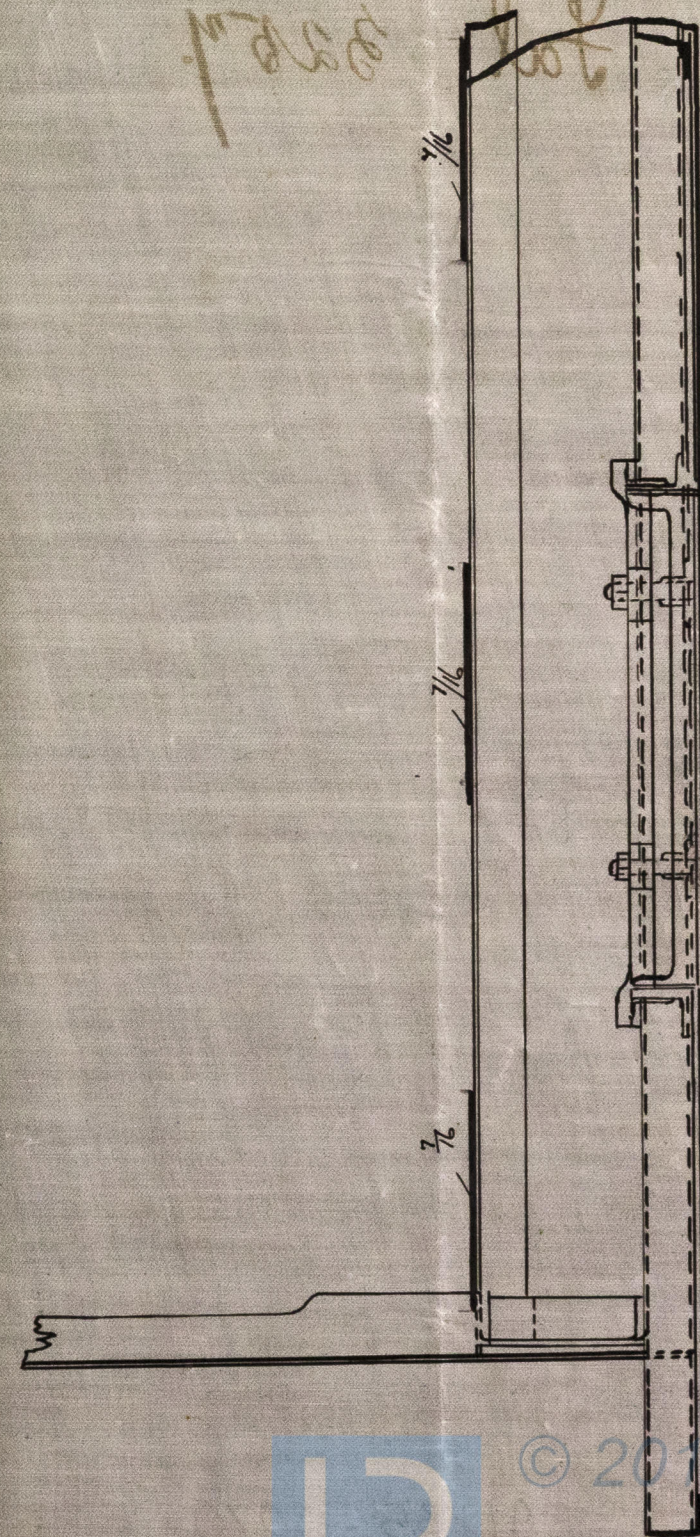

© 2019

Lloyd's Register  
Foundation

FAL135-0070