

18-1-50

“Tongshan”


Fal-3257.

NAHAN

op #22 pinal

2MOOR.B+3 HCU
leaf a at 1/2 slab

FAL135-0080

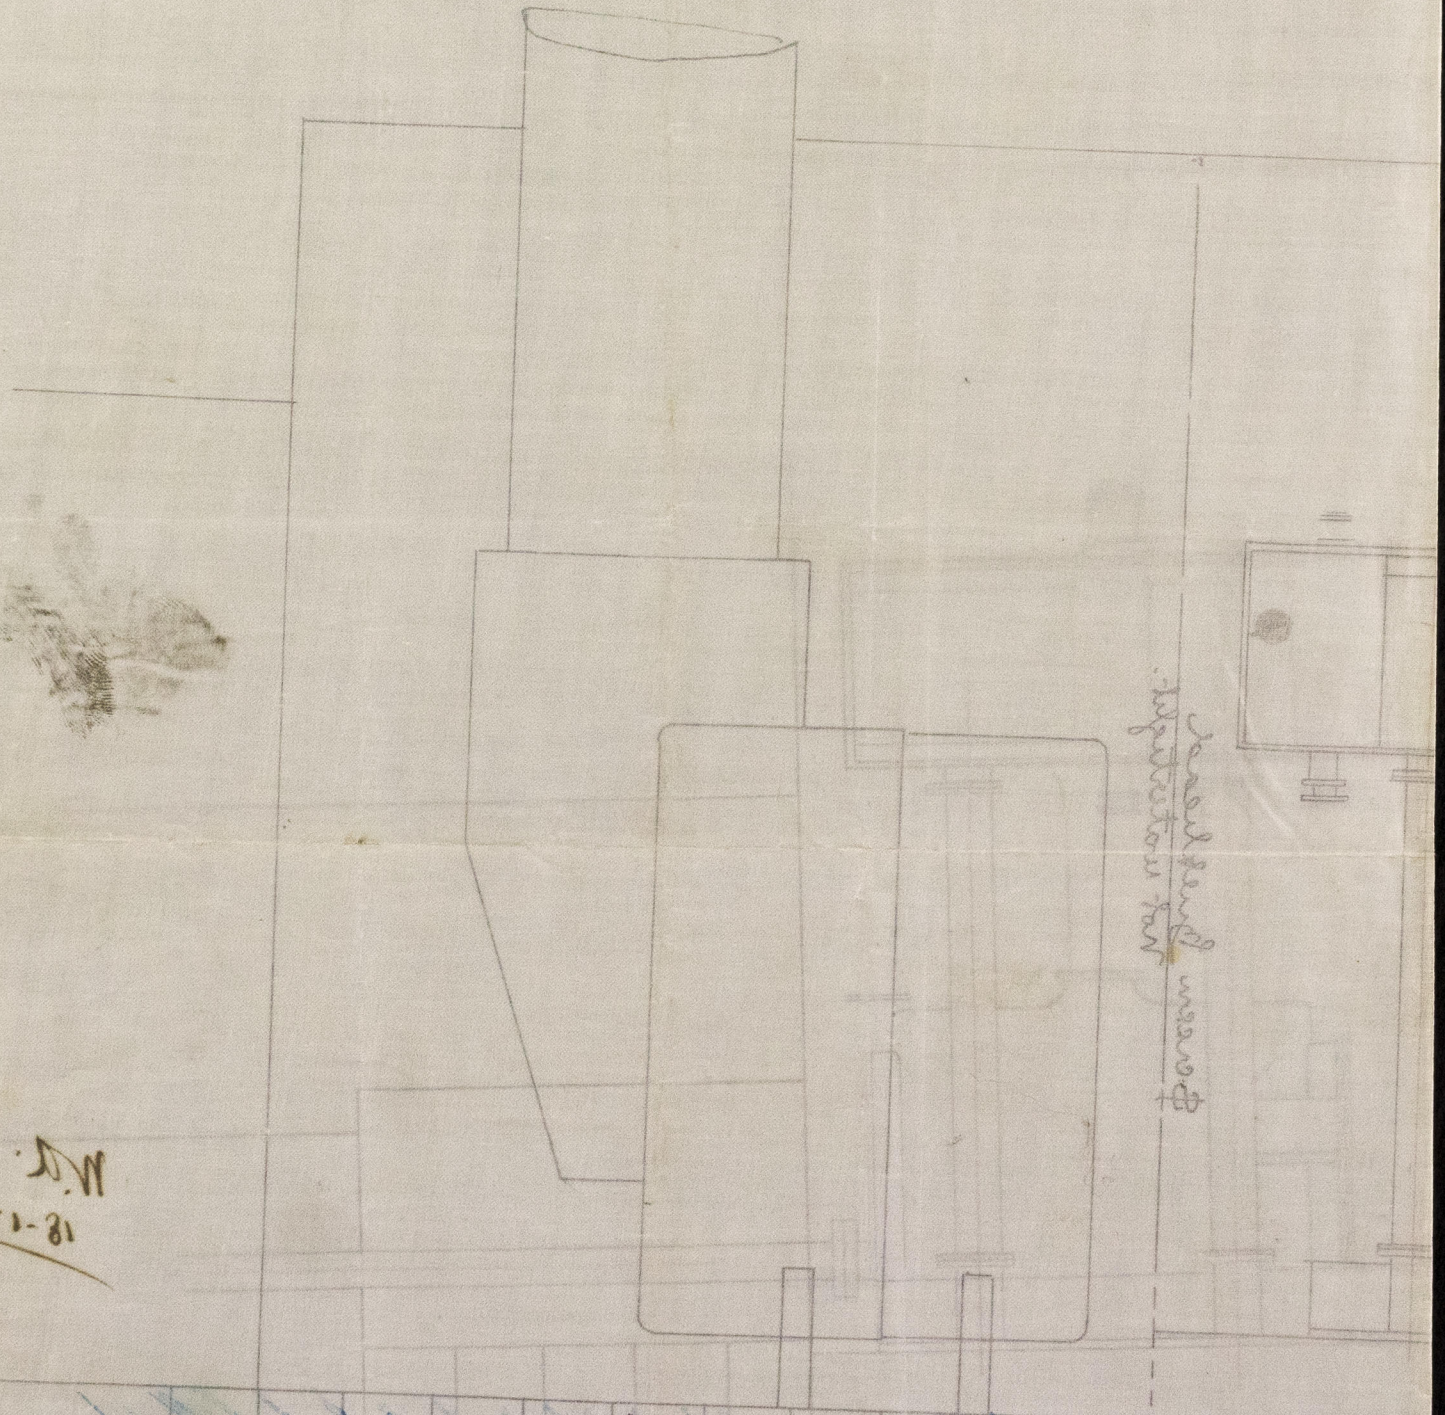

leaf a at 1/2 slab

18-1-50
M.Y.

© 2019 Lloyd's Register



Lloyd's Register
Foundation

FAL135-0080

Dec. 18. 1. 90

CF 31-90

No 3257


S.S. TONGSHAN

SECTION THROUGH E.T.B. ROOMS

Scale 1/4" to a foot

"unreported" \$1.8
\$1.25 - lot

Jan 15th 90

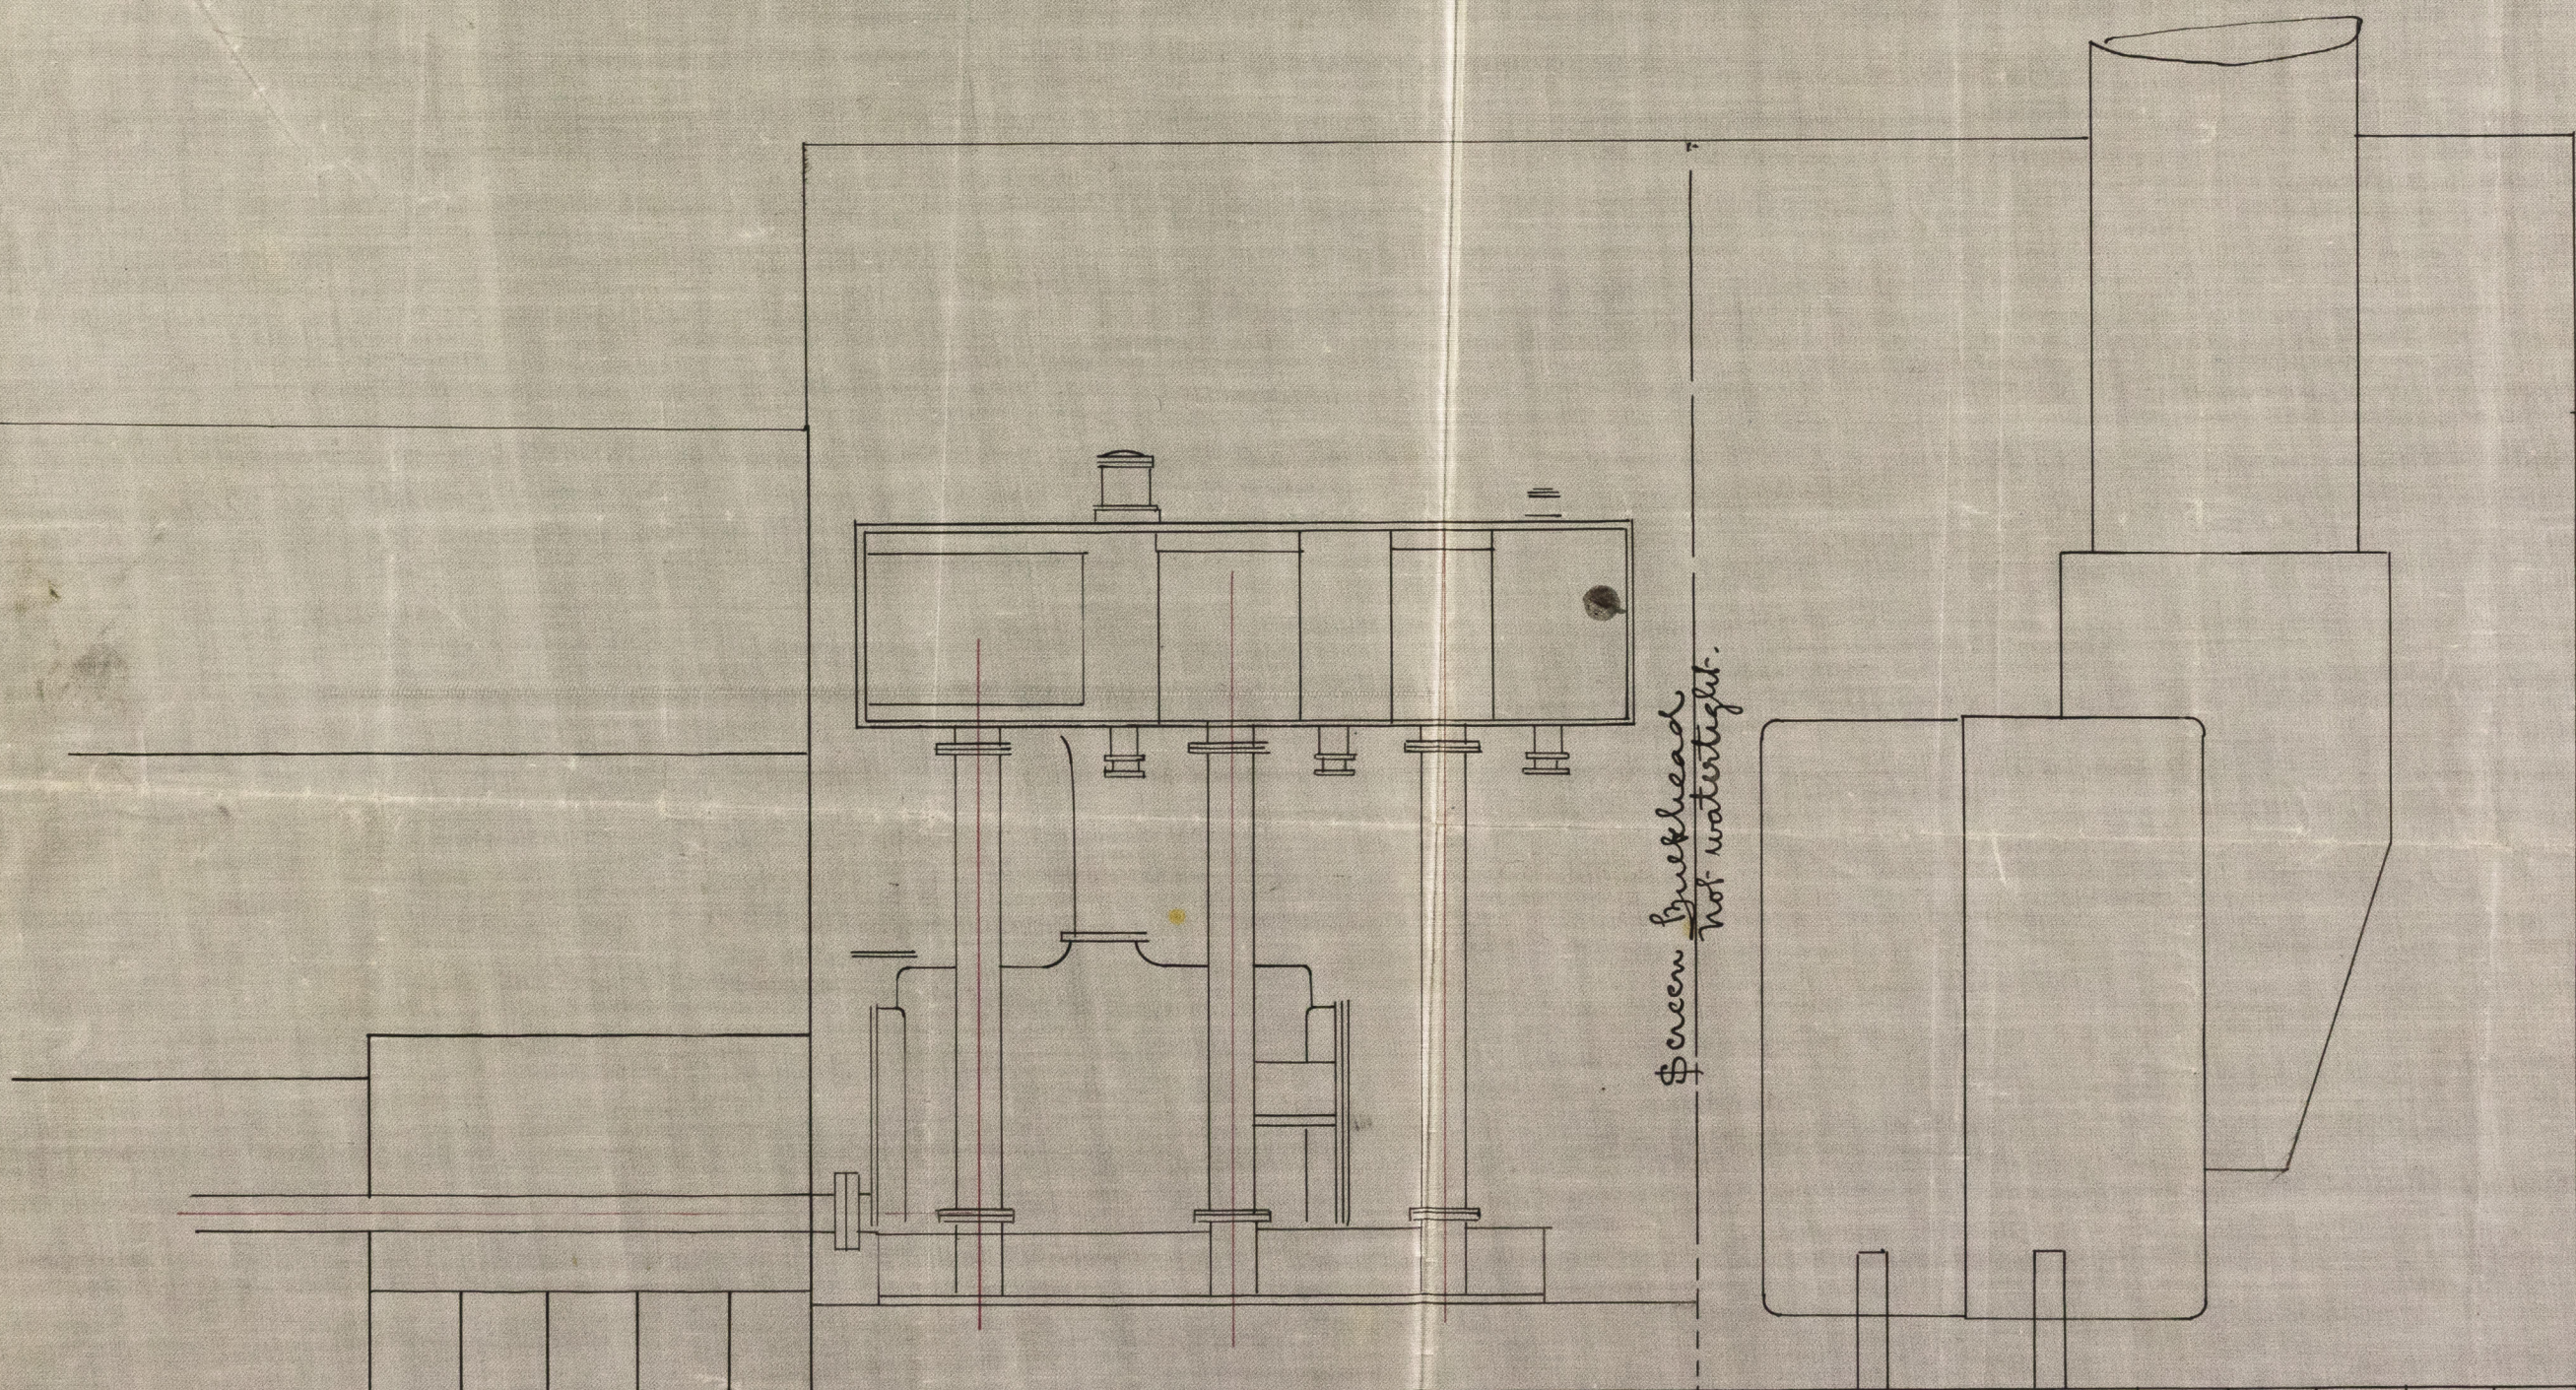

Screen Bulkhead
not watertight.

N.A.
18-1-90

Ballast Tank

WELL

Ballast Tank



© 2019

Lloyd's Register
Foundation