
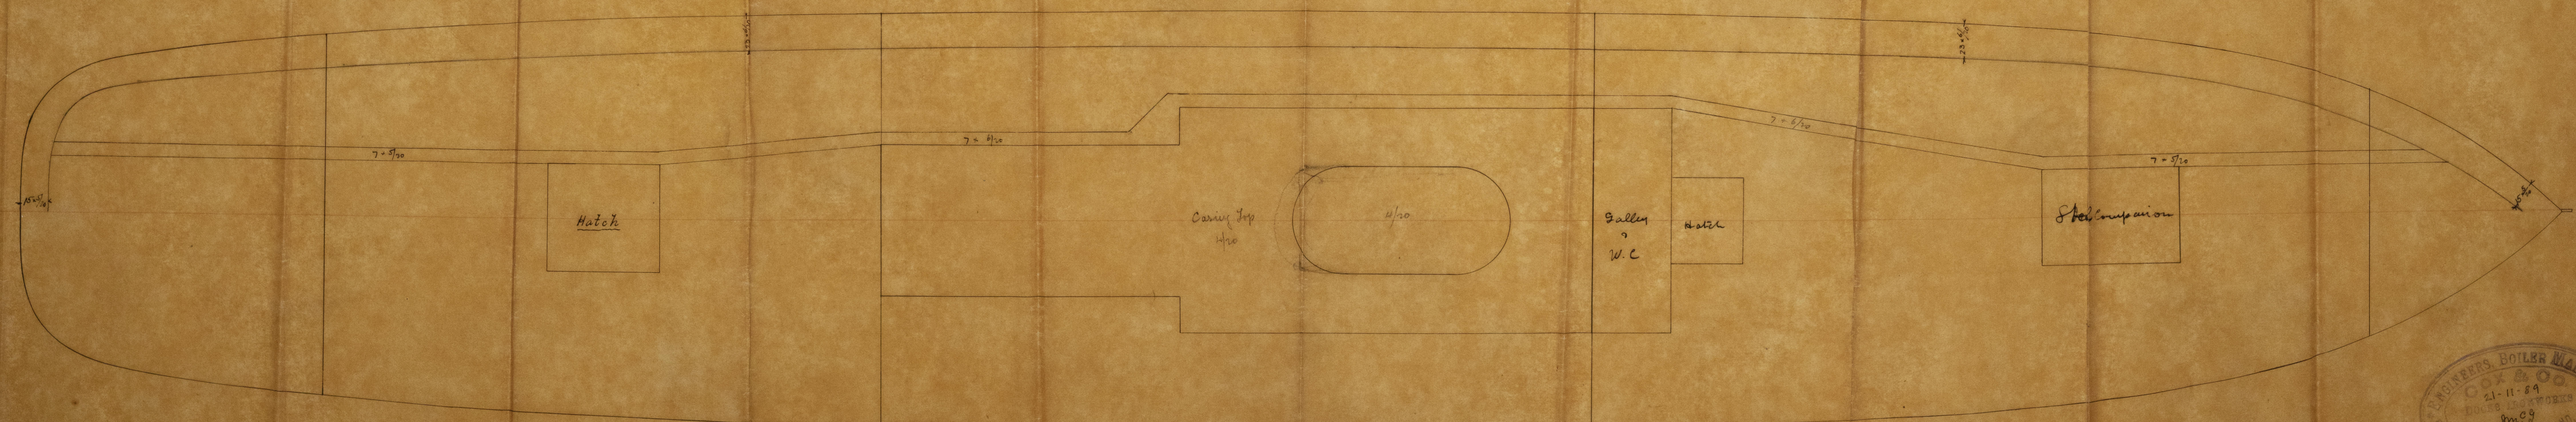


RECEIVED
25 NOV 89

LV122-0139

TUE 26 NOV 89
WED 14 DEC 89
MON 16 JAN 90

Arrangement of Ship No 33

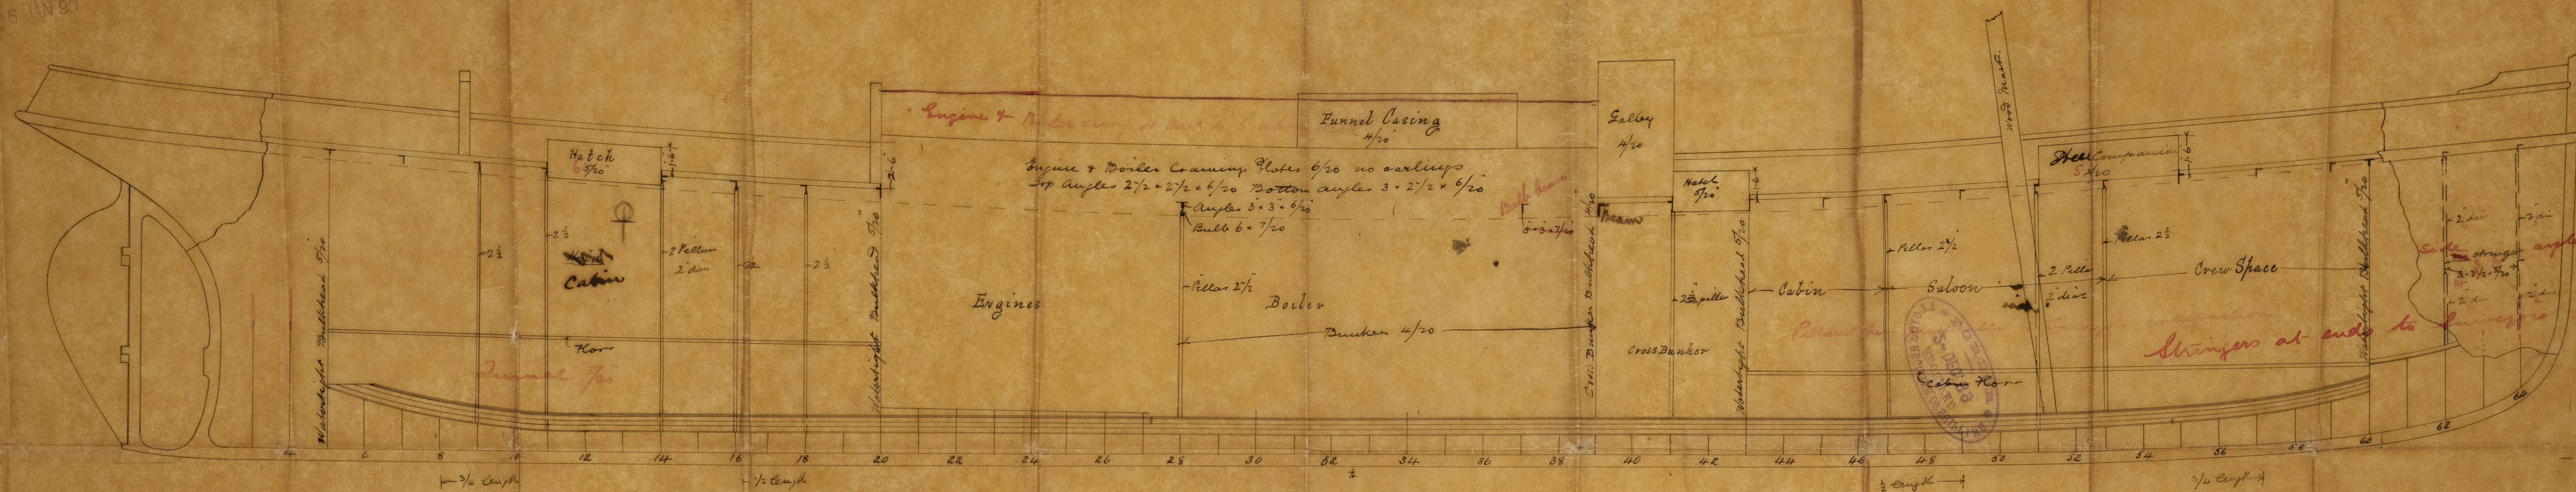


26/11/89

ENGINEERS BOILER MAKERS
COX & CO.
21-11-89
DOUGLAS WORKS
FALMOUTH, ENGLAND
FOUNDERS, SHIP BUILDERS & ETC.

FAL135-01176



© 2020
Lloyd's Register
Foundation

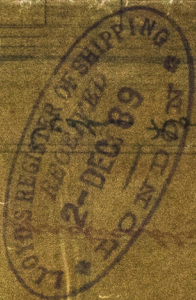

wooden

1/2" x 1/2"

Franklin

FAU 35080820

Lloyd's Register
Foundation