

Lloyd's Register of British and Foreign Shipping.

(Report on Vessel No. 3477 Port Falmouth)

No. 33

SHIP FORGINGS OR CASTINGS.

The words FORGINGS or CASTINGS, IRON or STEEL, should be struck out as may be required.

I have to report that the undermentioned Iron or Steel Forgings or Castings, manufactured by Messrs Coxe & Co of Falmouth for the Vessel No. 33, being built by Coxe & Co of Falmouth have been inspected by me as set forth below, and found to be, so far as can be seen, in a good sound condition


Mark on Forgings.

Lloyd's
No. 515-
T.H.S.

J. A. Audrey
Falmouth.

	STERN FRAME.	RUDDER FRAME.	STEM.
Material* - - - -	Scrap Iron	Scrap Iron	Scrap Iron
How made - - - -	Forged	Forged	rolled
Dimensions - - - -	6 - 2 1/2	3 3/4 x 2 1/4	6 x 1 1/4
Progress on Inspection -			
Dates when Inspected			

SKETCHES OF FRAMES SHEWING POSITION AND DESCRIPTION OF WELDS OF FORGINGS, OR PARTICULARS OF TESTS APPLIED TO CASTINGS.

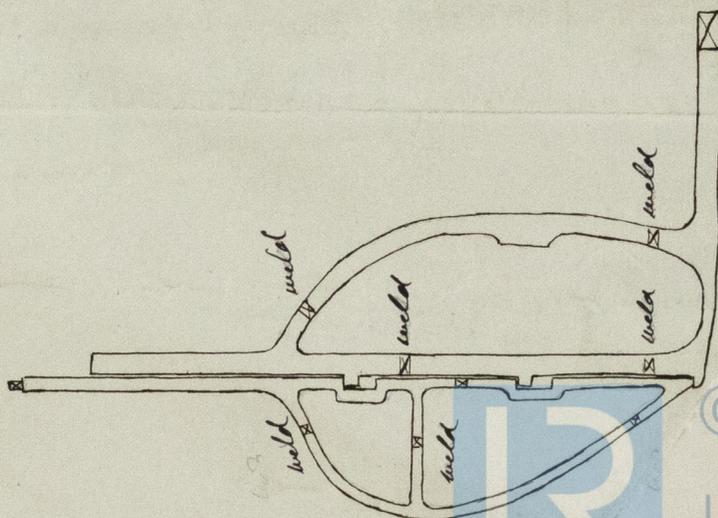

Welds as shown in sketch

© 2019 Lloyd's Register Foundation

* If of Iron, state whether scrap or puddled Iron.