

Oct. 27. 11. 89




BOILER No 46.

11'-6" MEAN DIAMETER X 10'-0" LONG. WORKING PRESSURE = 150 LBS. PER SQ. IN.

To Pass LLOYD'S SURVEY

Scale 1" = one foot

DRAWING No 1272

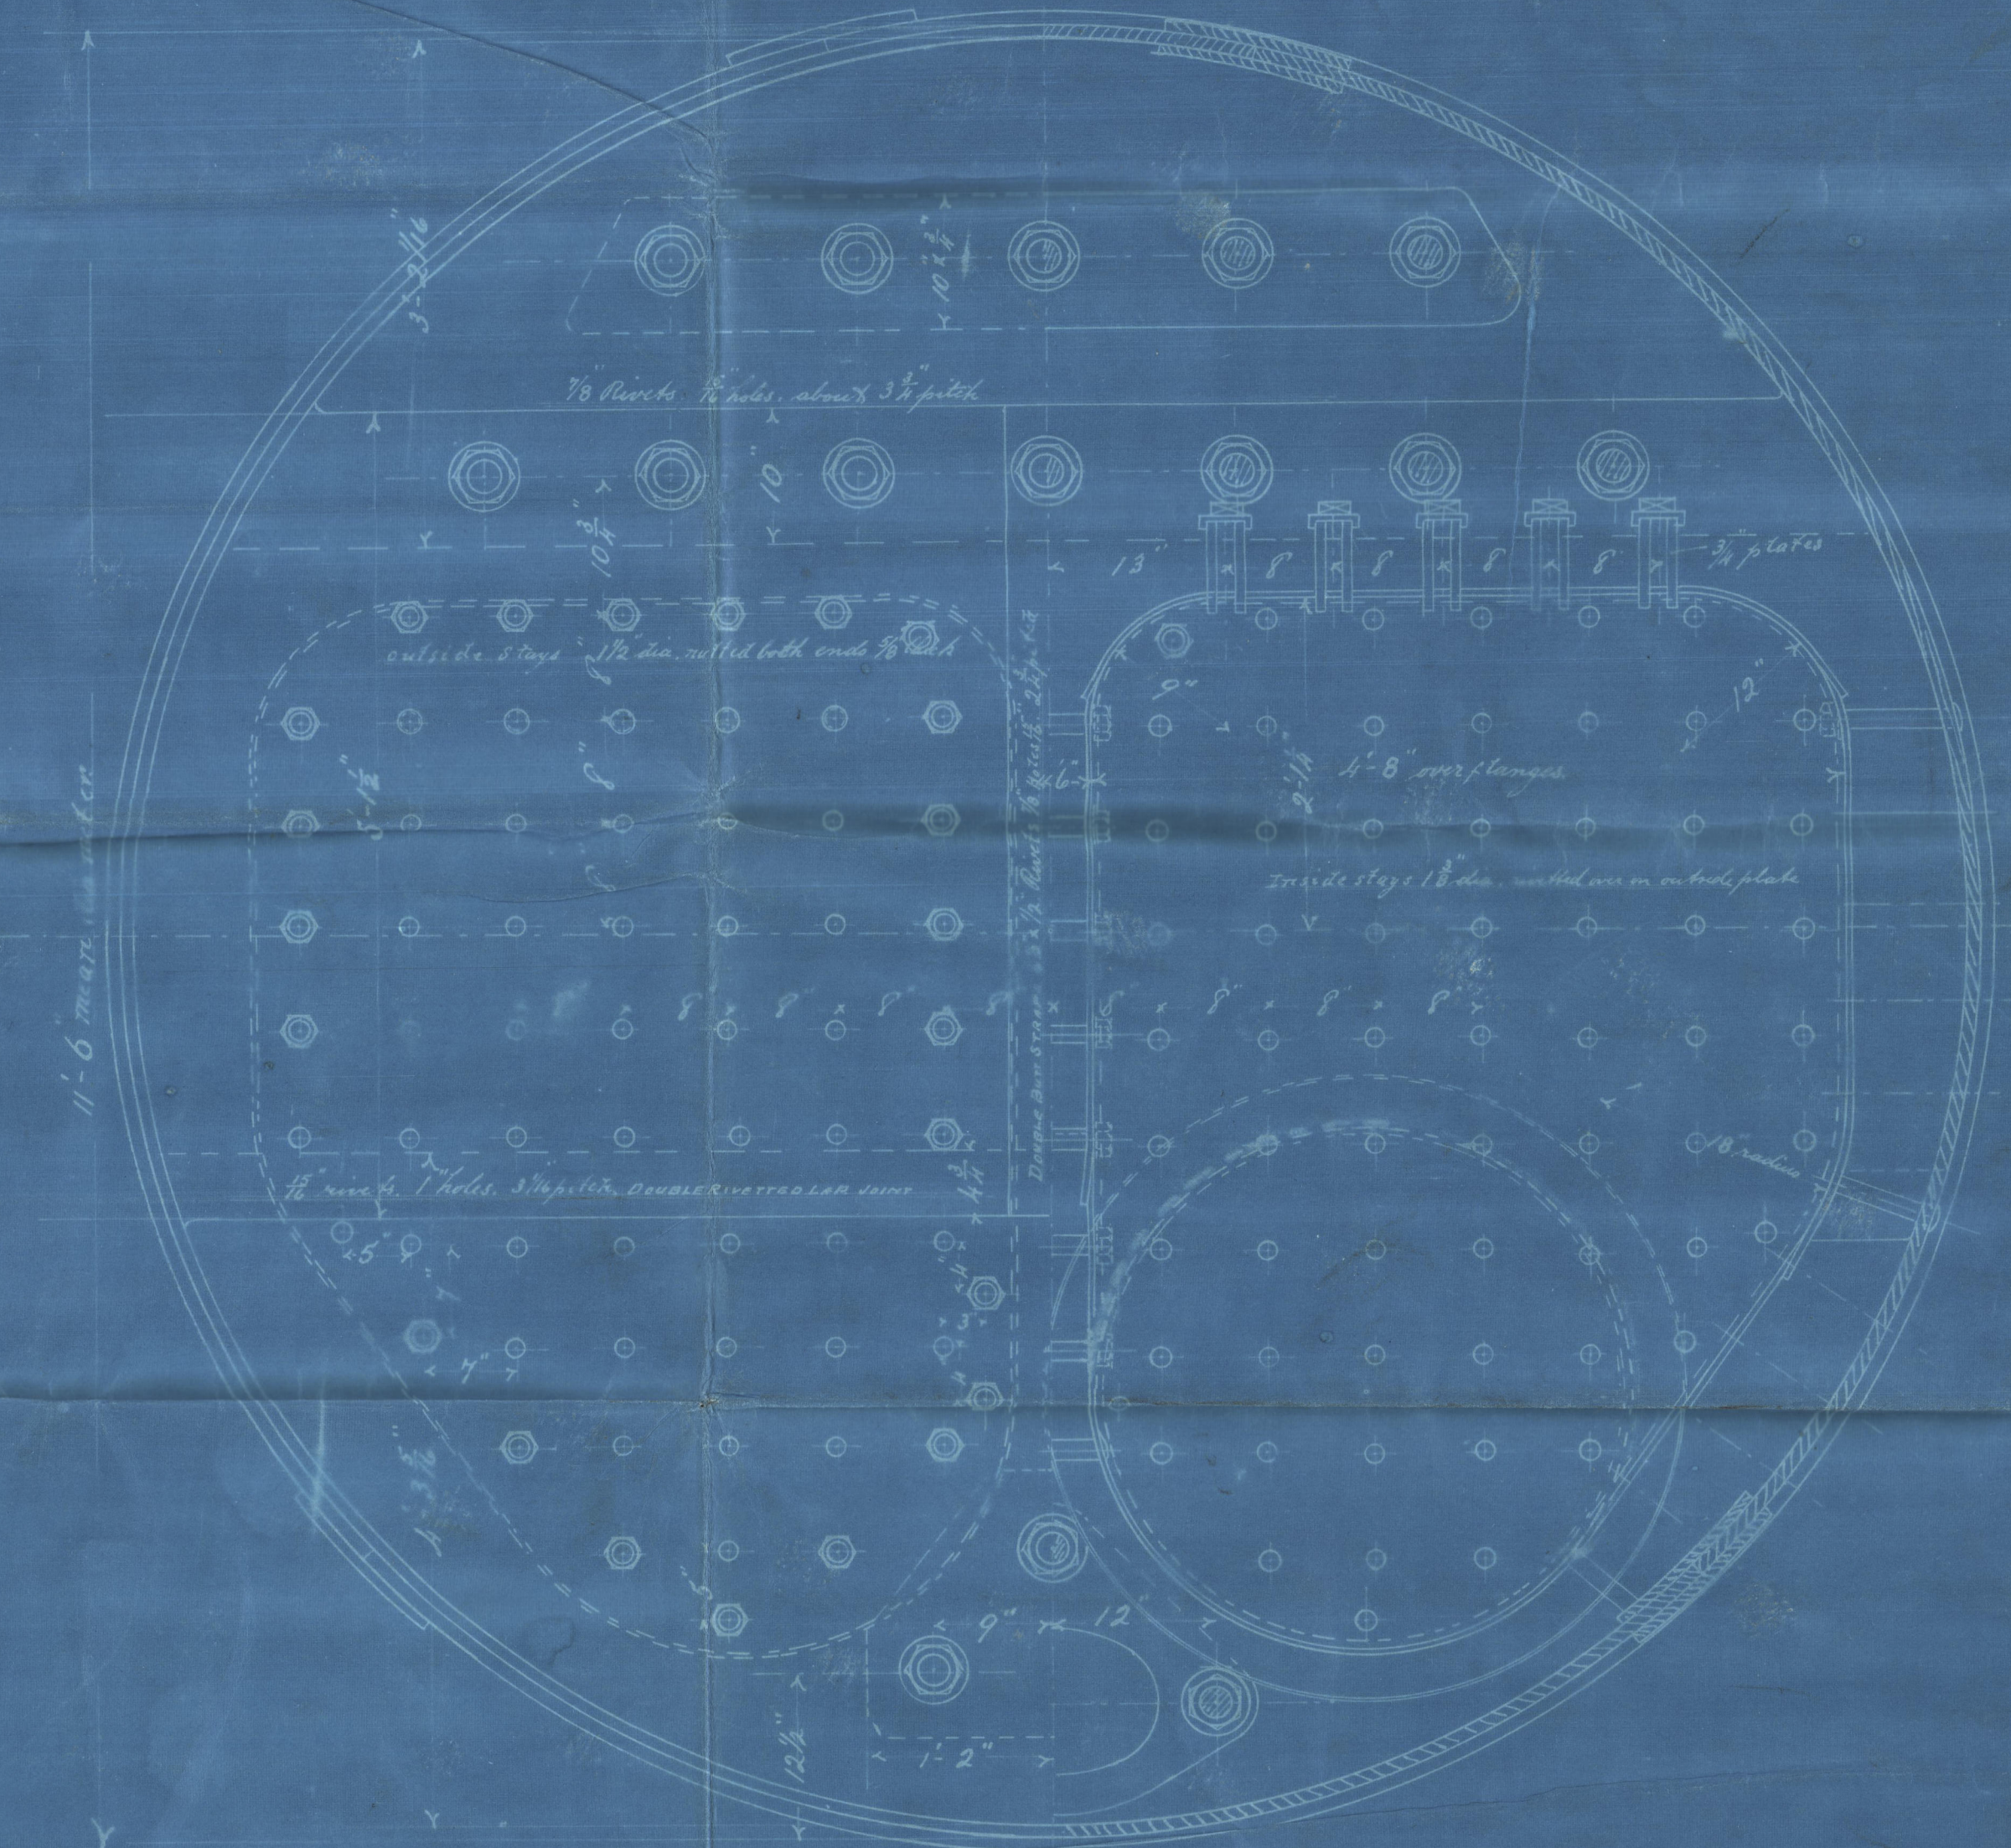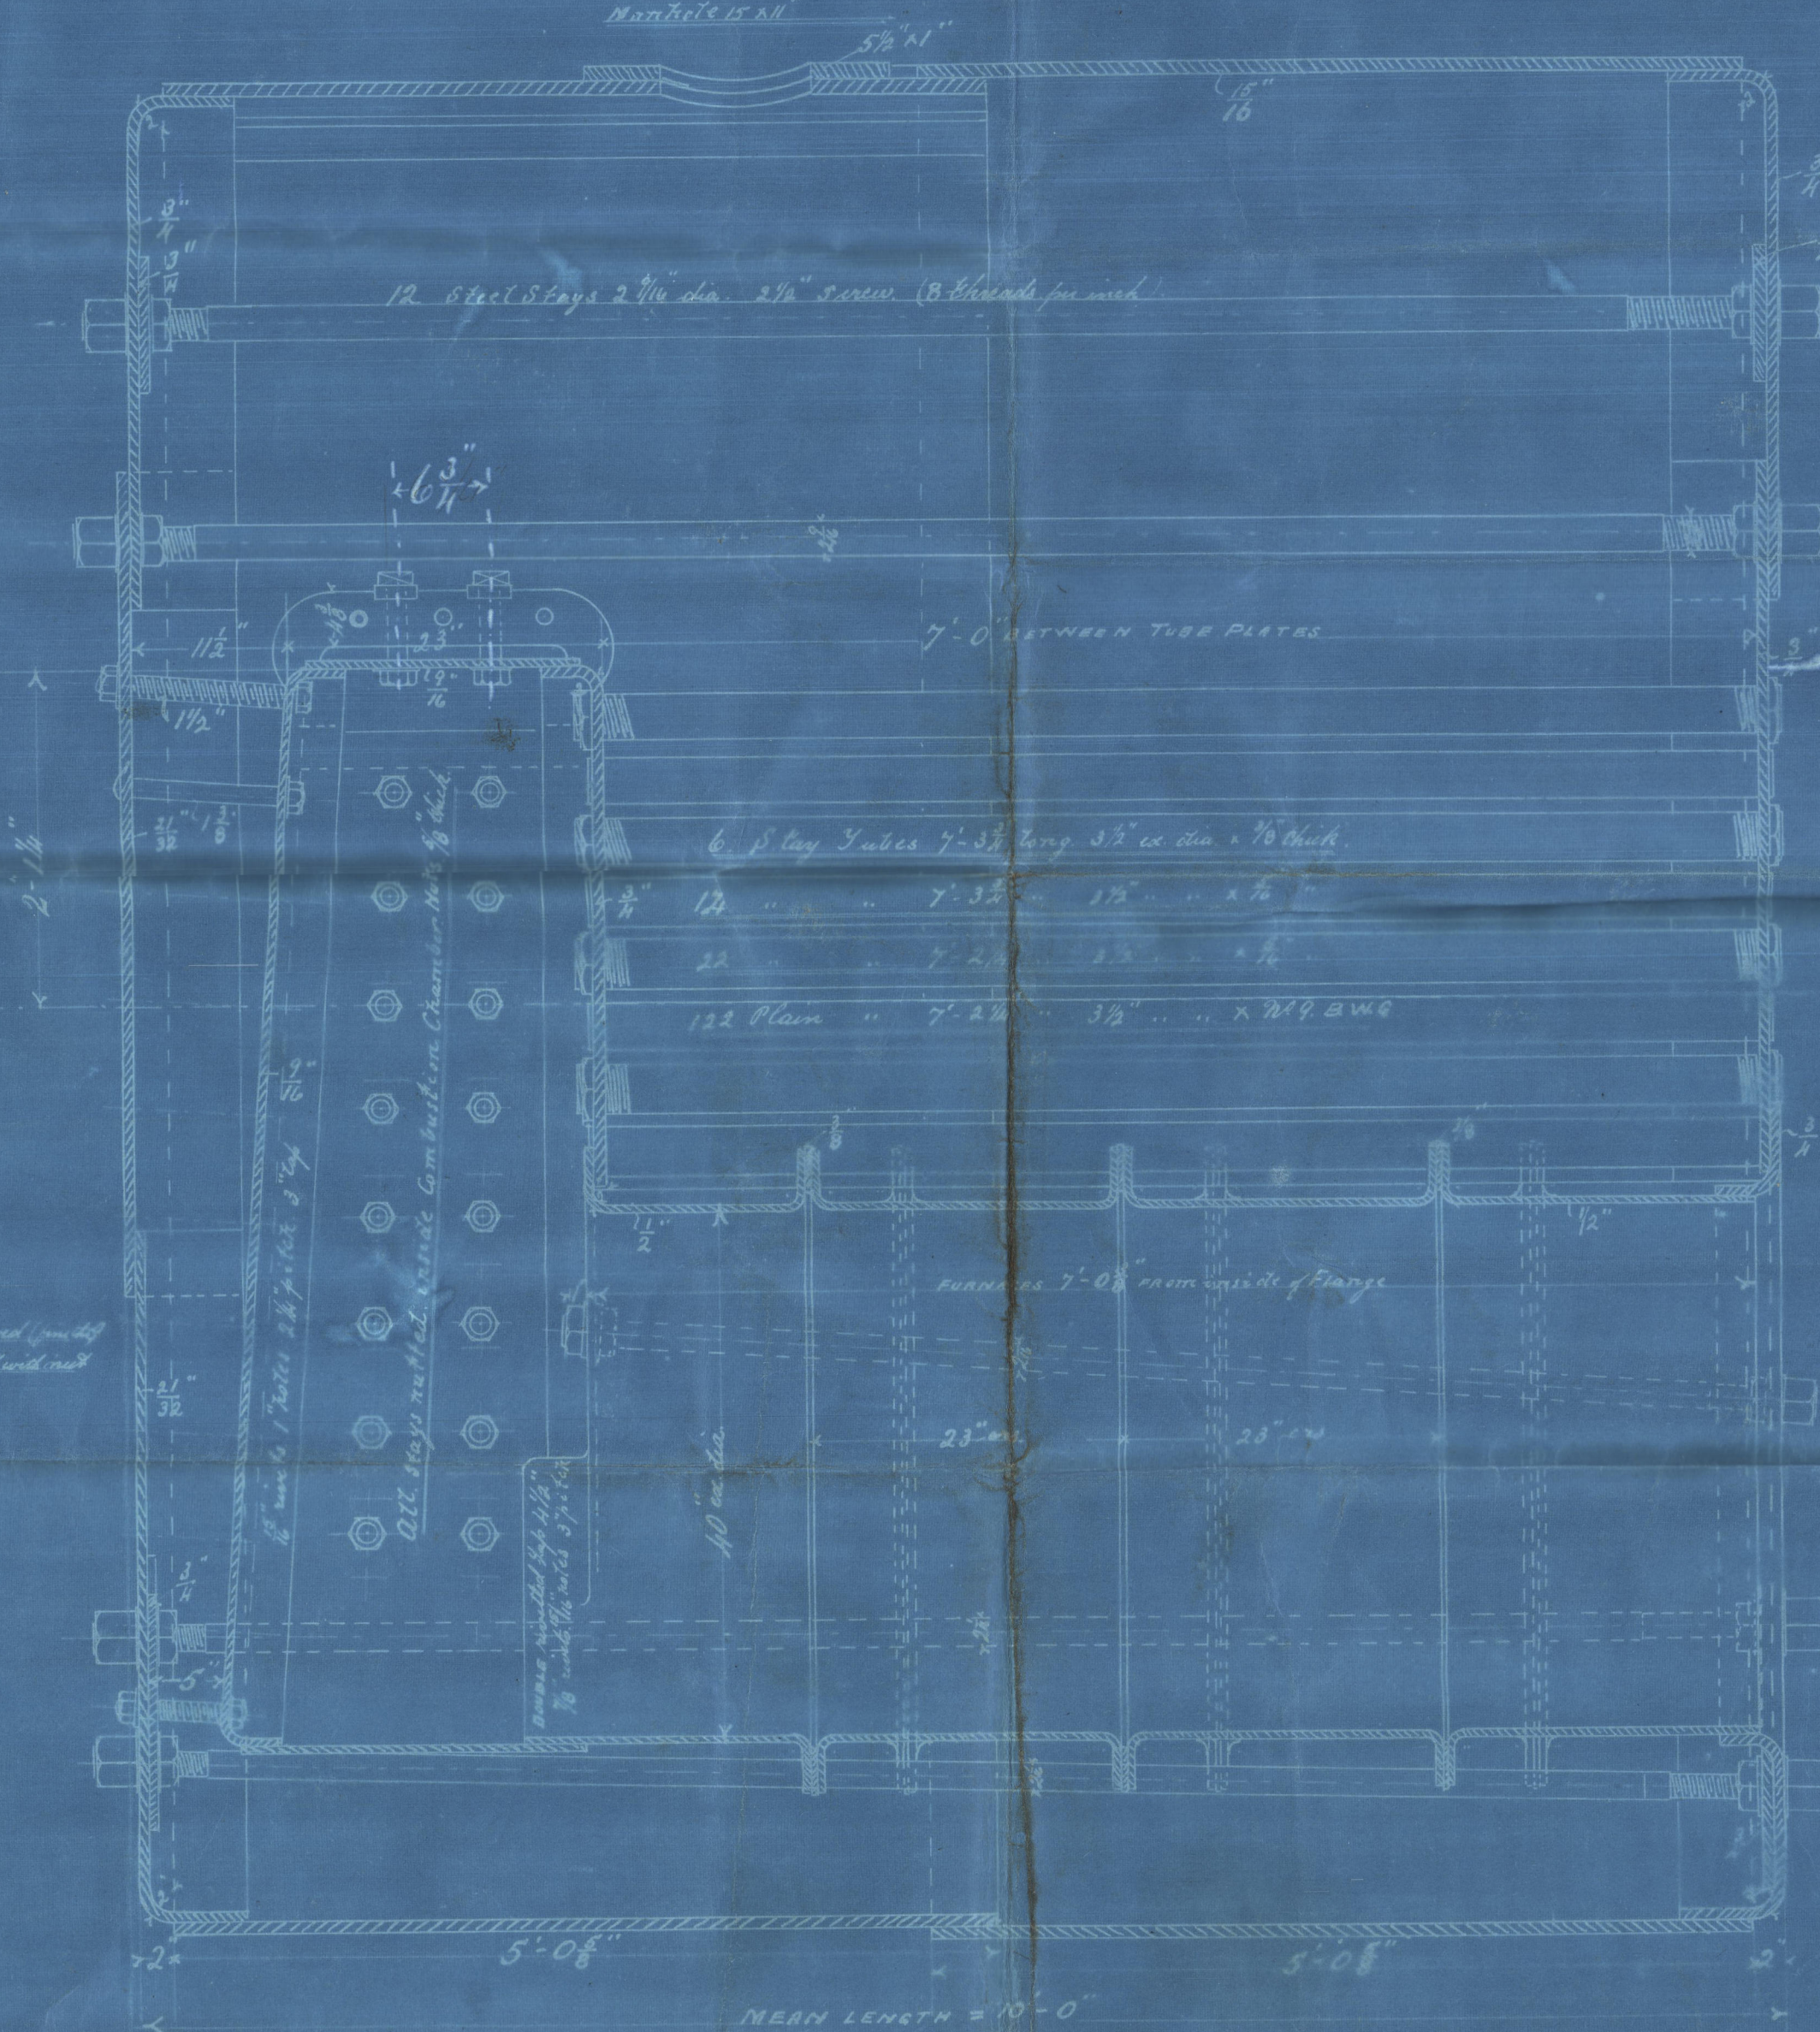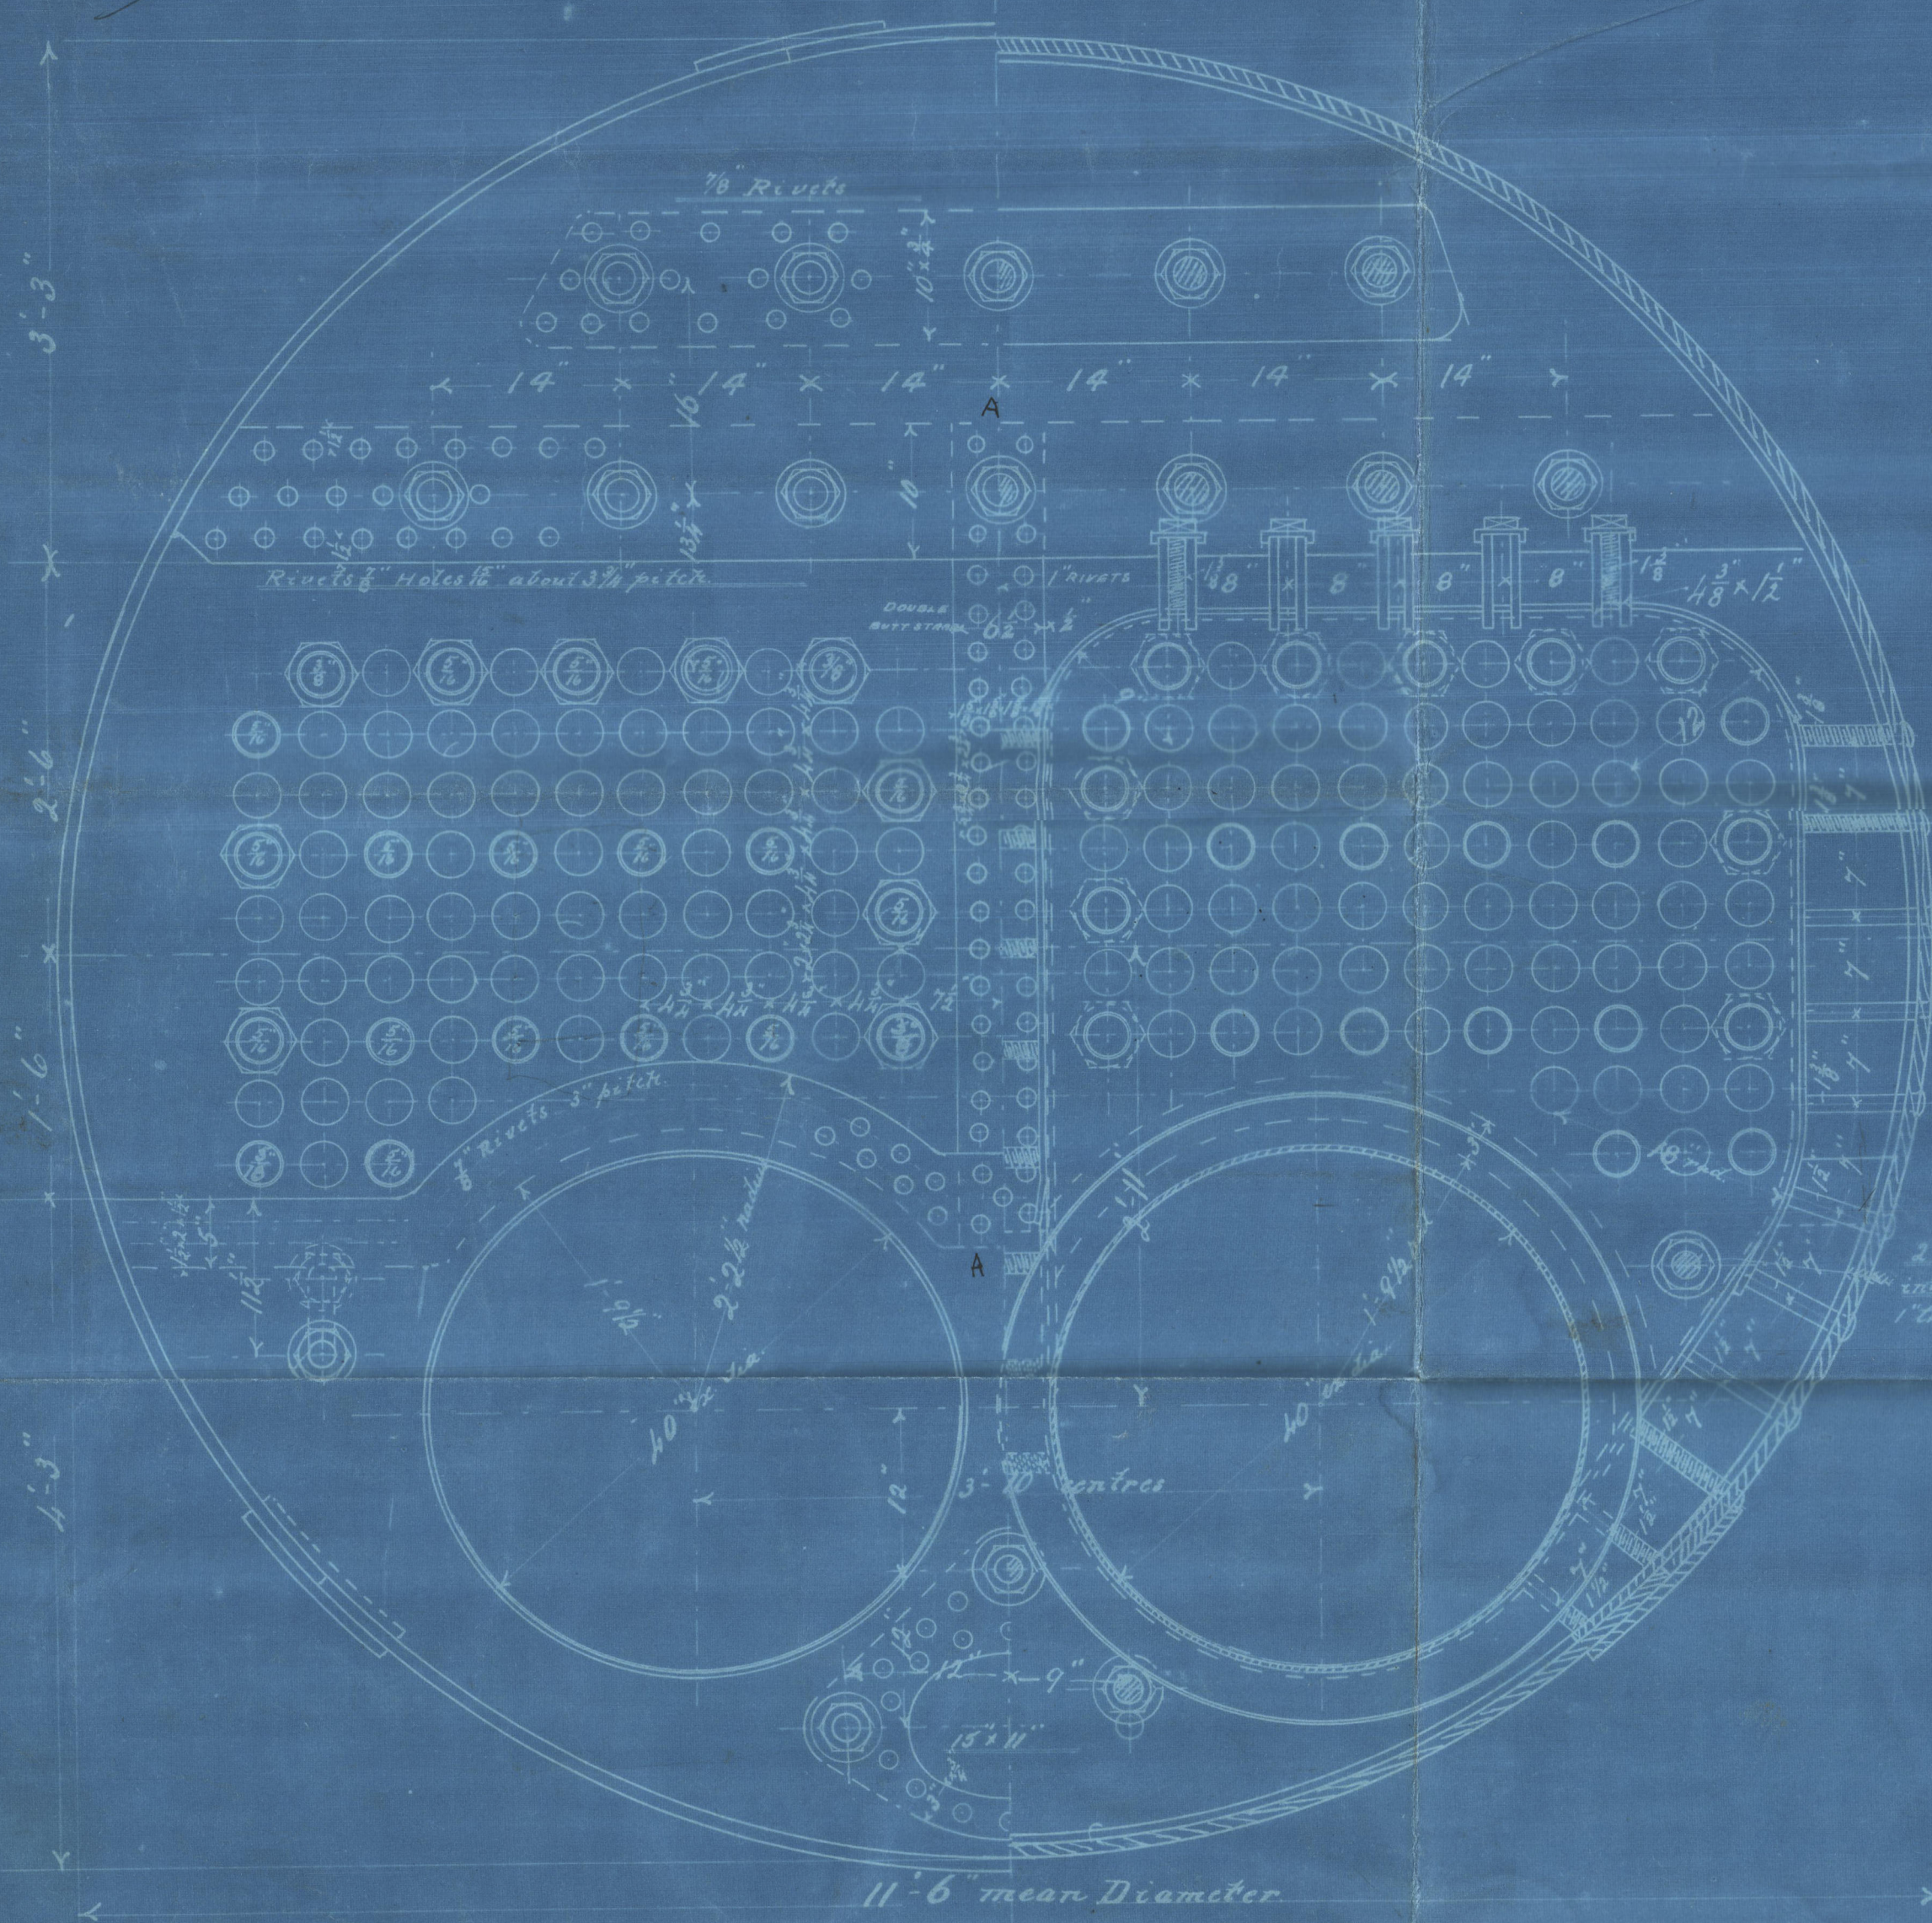

M.L.
26.11.89

Received 21.11.89
To London 23.11.89

"Hercules"

Fal Rep No 34 7/7

FAL135-0179



© 2020

Lloyd's Register
Foundation