
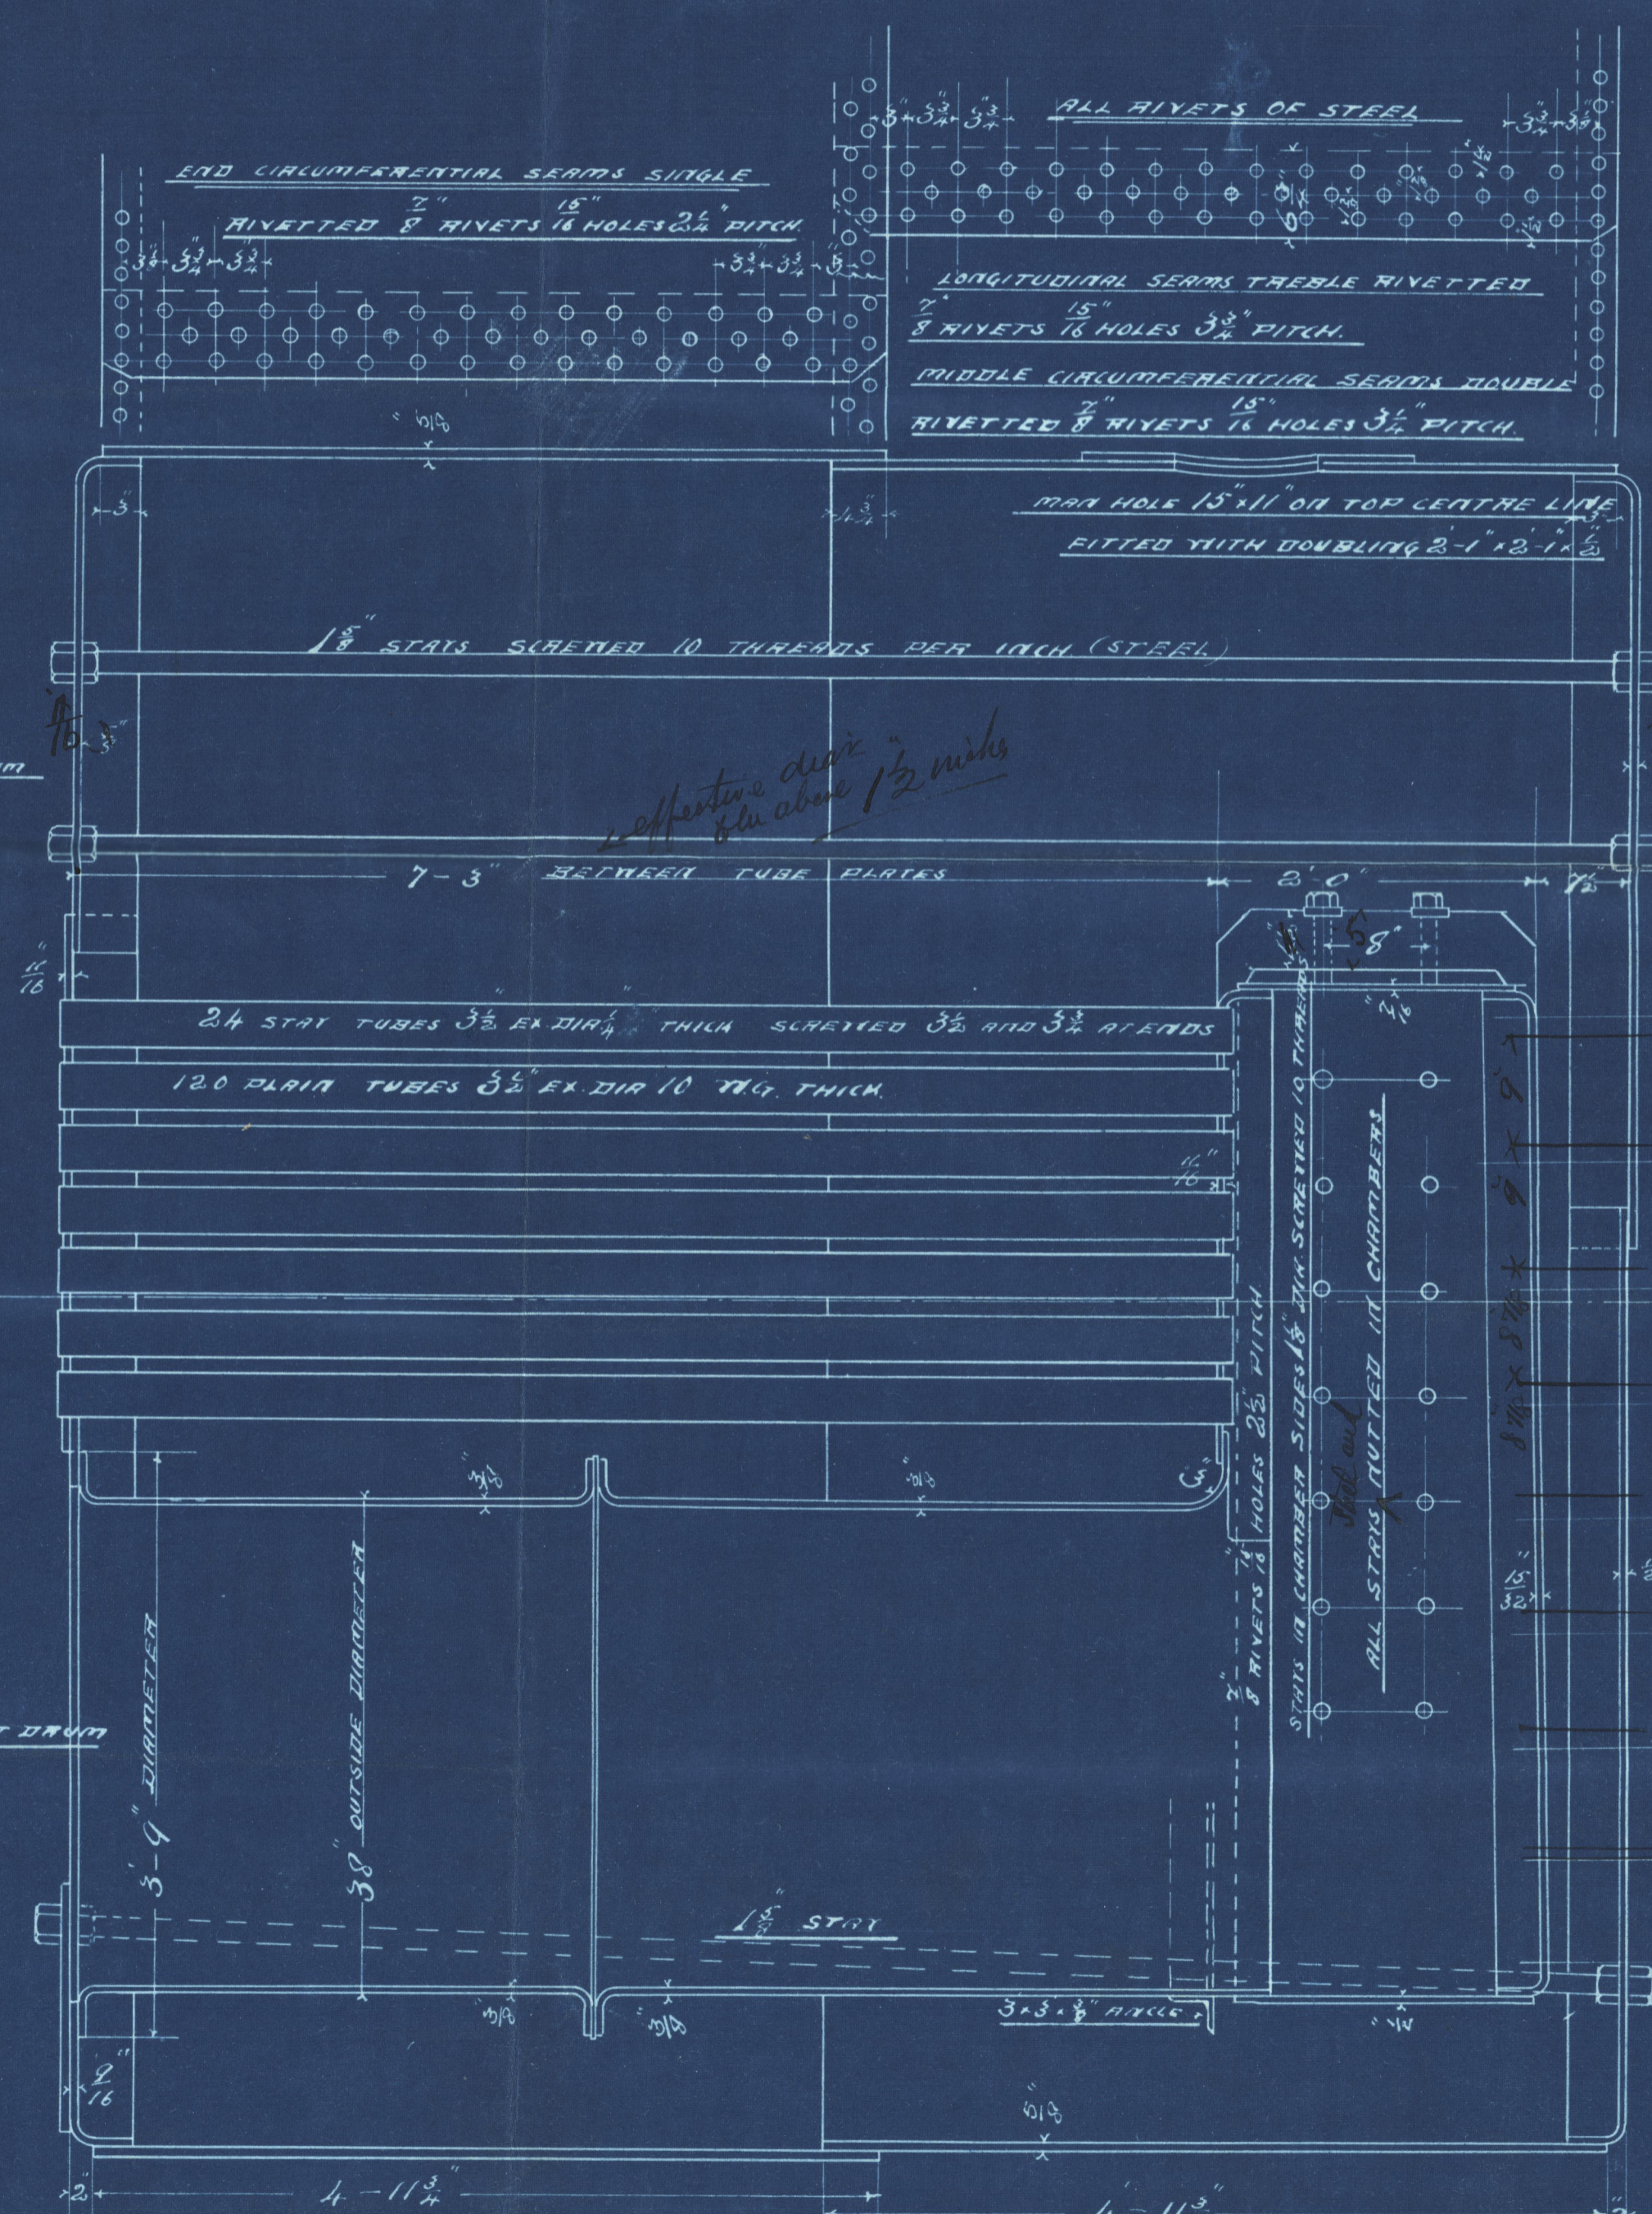


168-5-91

168-5-91

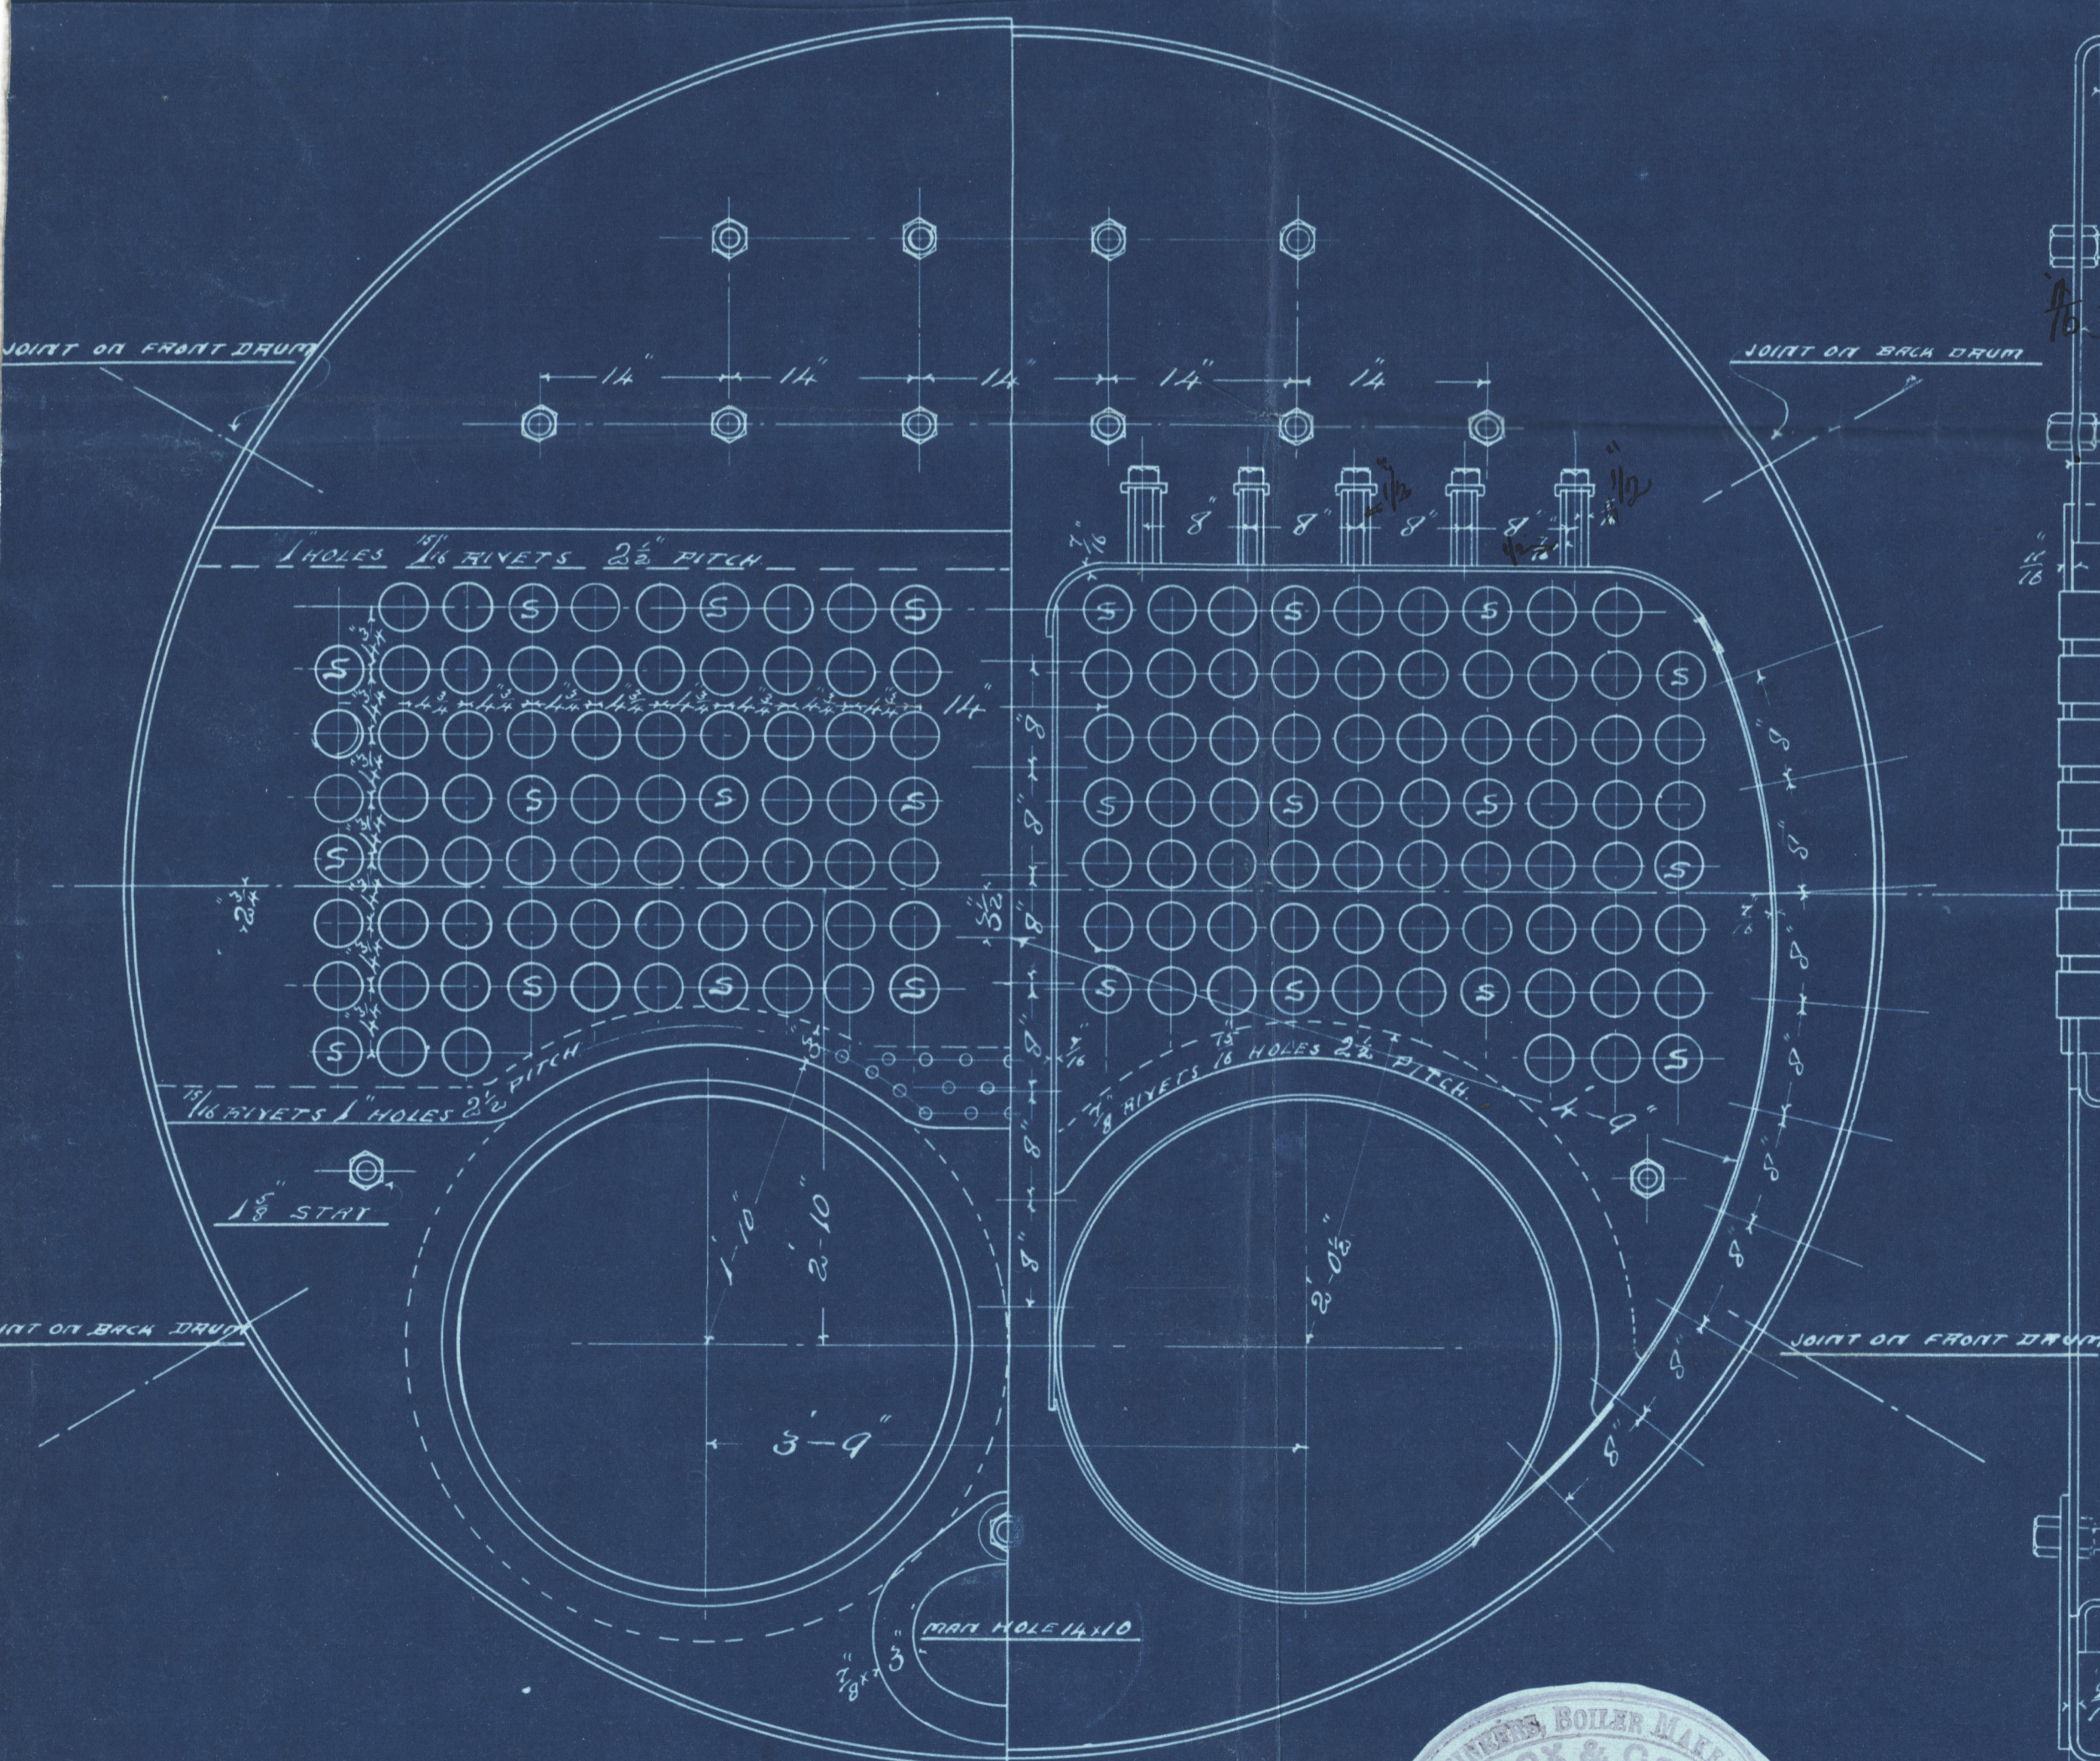

WORKING PRESSURE 80 LBS TO LLOYD'S RULES

STEEL BOILER NO 55 FOR S.S. "PLANET"  
11'-0" DIAMETER 10'-0" LONG  
SCALE 1" = 1 FOOT



Photo Tracing of Boiler  
In "S. S. Planet"  
Being built by Innes Cox & Co  
Falmouth  
23-4-91  
Report Number 3581



© 2020

Lloyd's Register  
Foundation

FAL136-0020