

Harvey No 155-
Hayle

Port of Plymouth
No 3653.
S.S. "Volney"
Stern frame



ALI 36-0063 (3/3)



© 2019

Lloyd's Register
Foundation

4. 2-92


FORGED RUDDER & STERN FRAME

S. S. 155


SCALE $\frac{1}{2}$ & 1 TO ONE FOOT

FEBRUARY 1st 1892

DRAWING N° 104-92

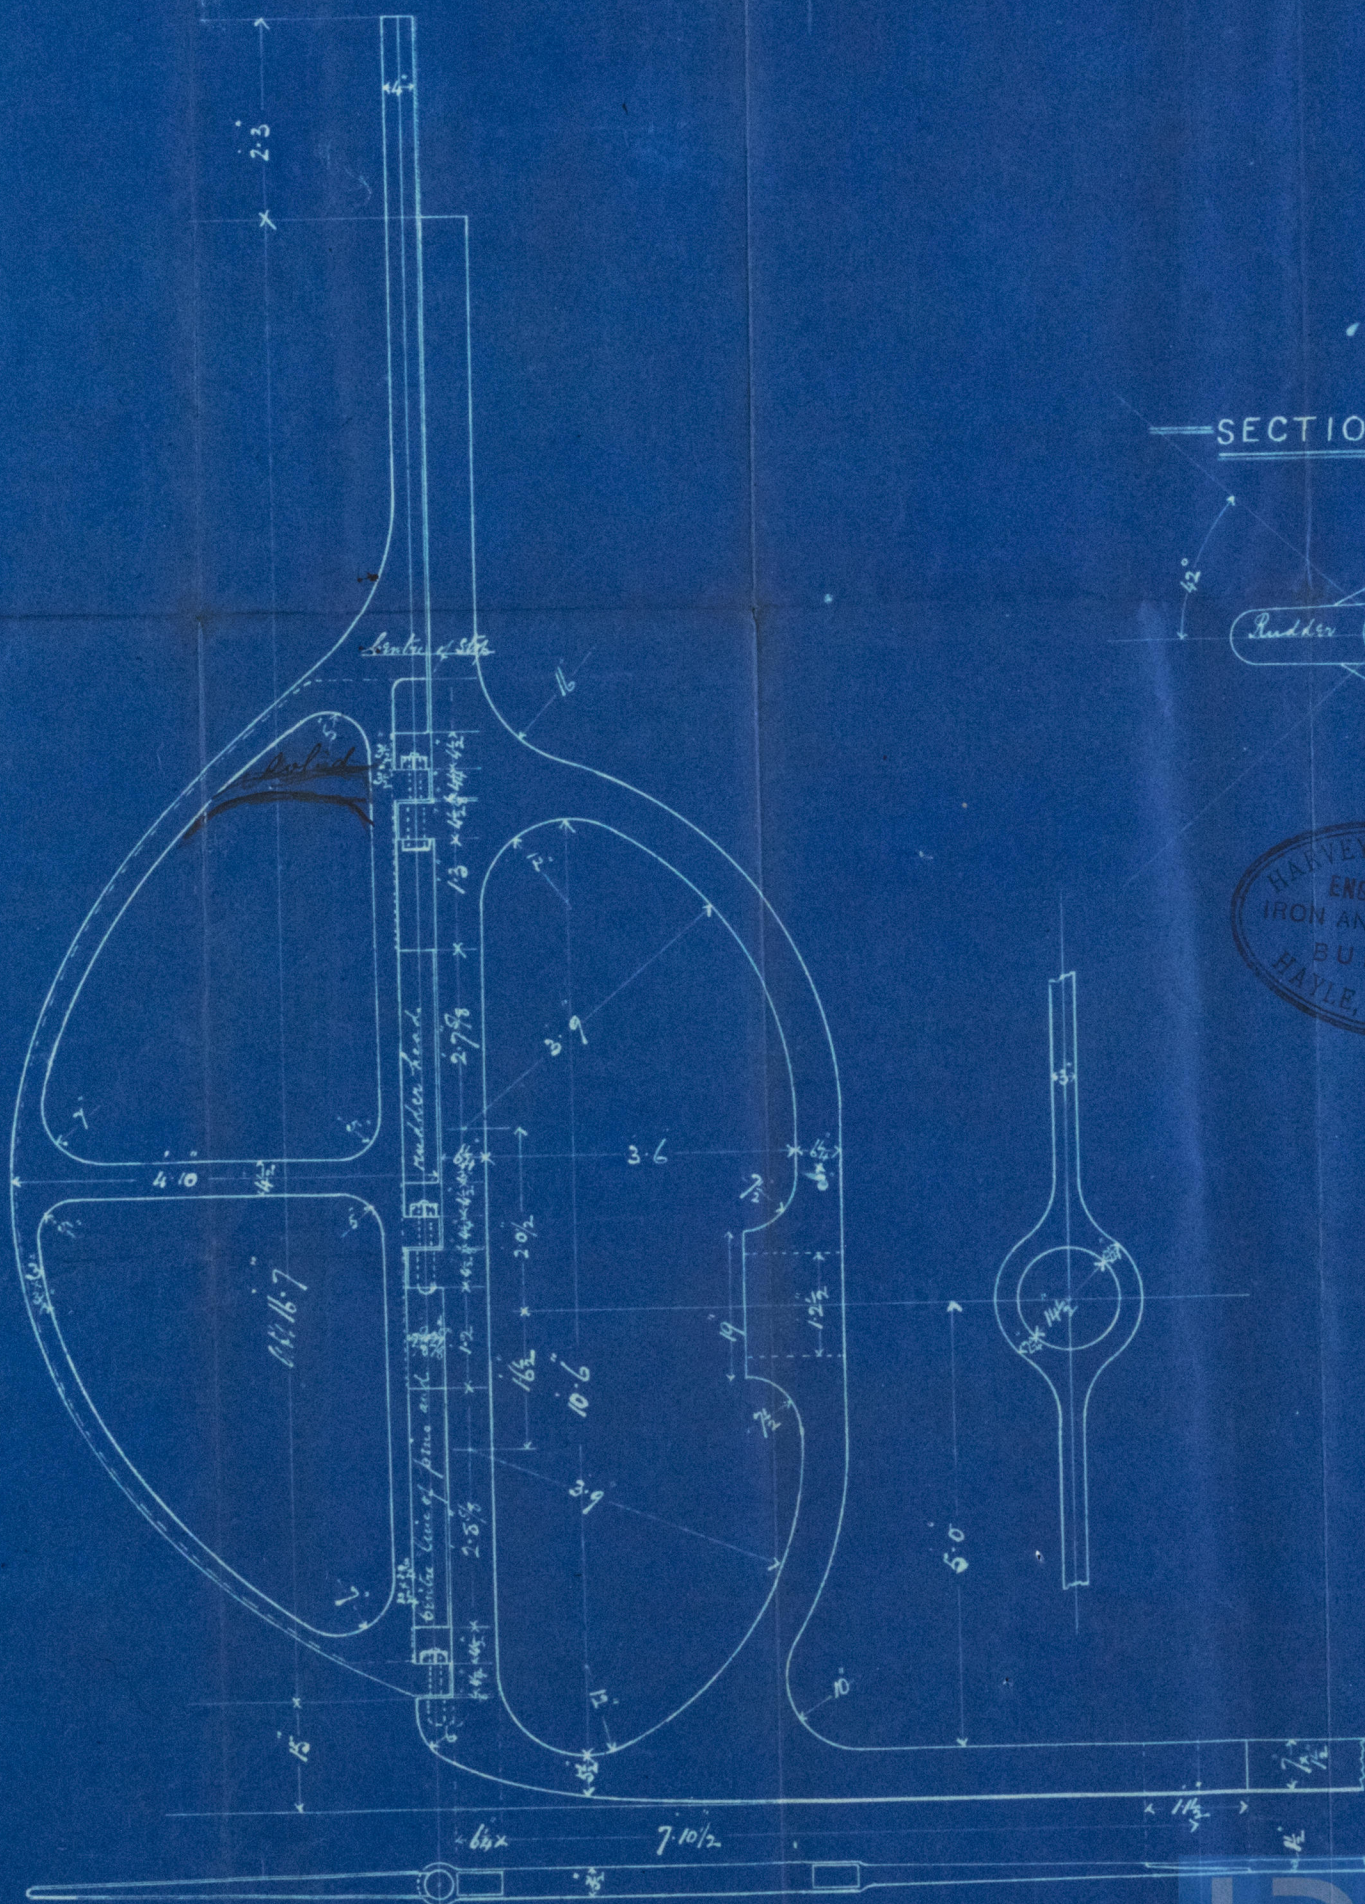

SECTION OF STOPPER

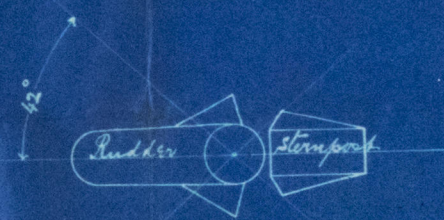

HARVEY & CO. LIMITED
ENGINEERS AND
IRON AND STEEL SHIP
BUILDERS.
HAYLE, CORNWALL.

LR