

Pumping Plan  
for S. S. No 155  
Building by  
Messrs Harvey & Co (Lim)  
Hayle  
13. 4. 92

Tolney.  
Gal 3653.



© 2019

Lloyd's Register  
Foundation

F4L136-0071




Ln: 16 H 92

# PUMPING PLAN FOR SS N<sup>o</sup> 155

SCALE  $\frac{1}{8}$  = 1 FT.

DRAWING N<sup>o</sup> 191-92 DATE APRIL 7<sup>th</sup> 92.

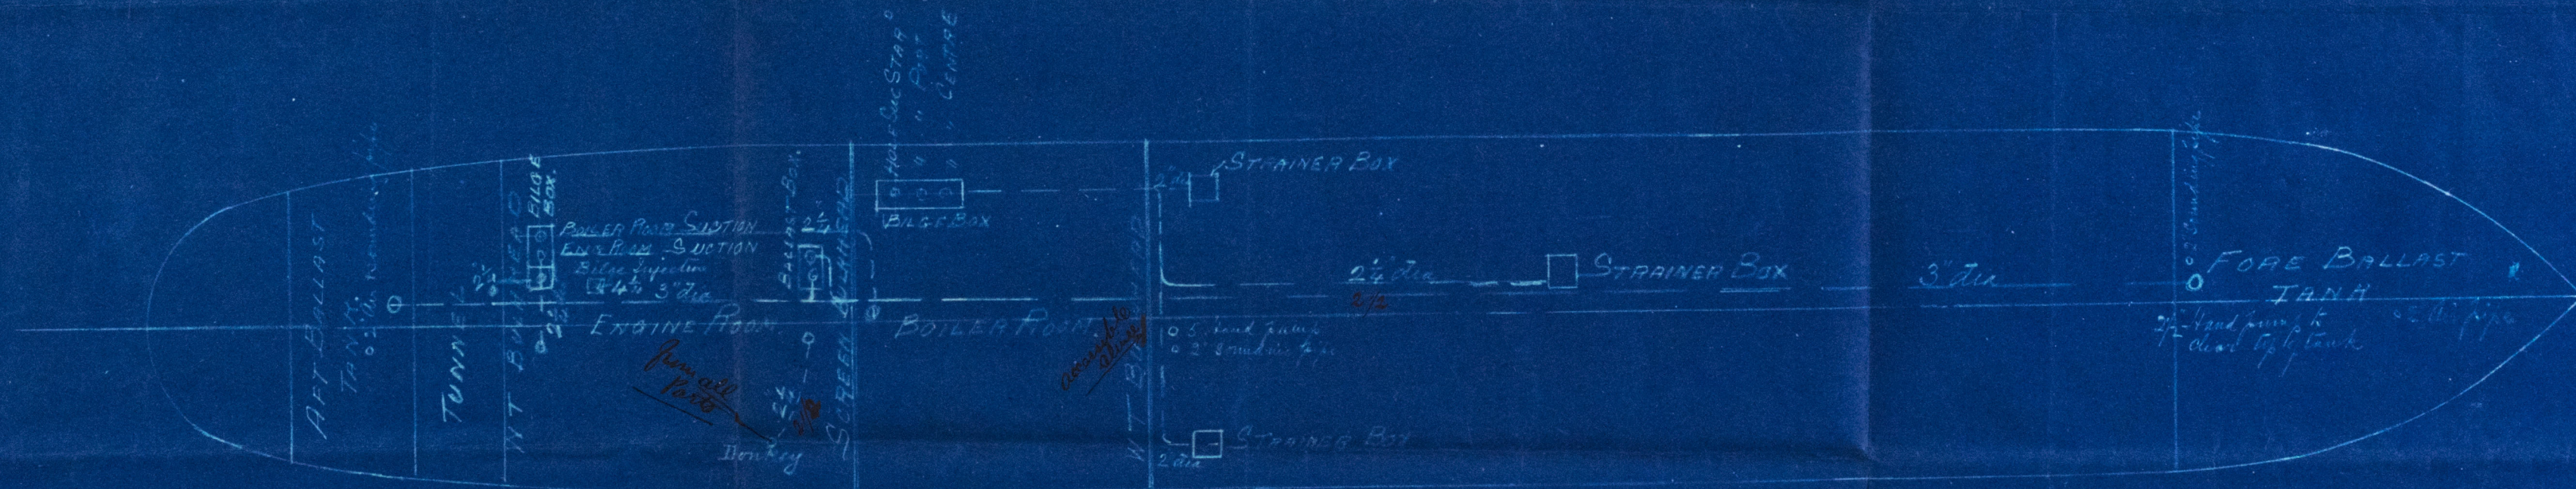

note Ballast box connected to Centrifugal  
Circulating Pump & Donkey pump  
Belge boxes connected to Engine Balge Pumps  
and Donkey pump

MA  
14-4-92



© 2019

36-007