



showing where hole is situated in stern
of S.S. John Pender

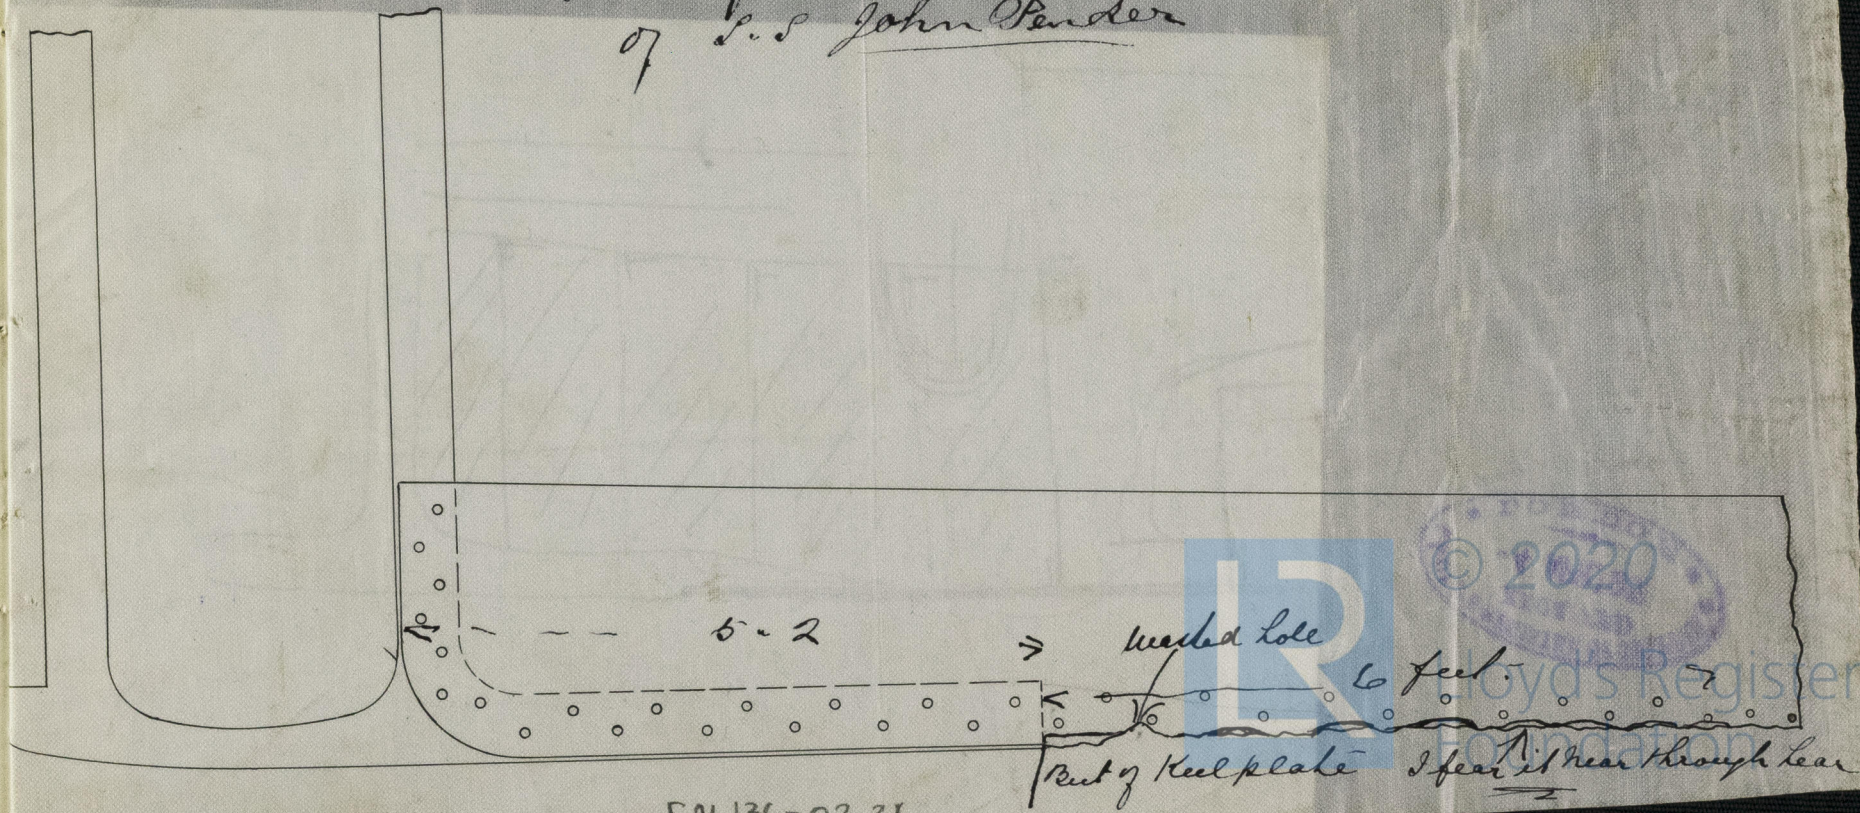

FAL36-0236

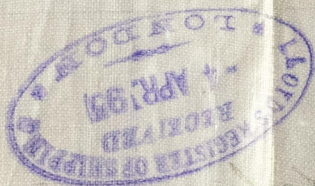

LLOYD'S REGISTER
LONDON
REC'D 4 APR 93
NAME

Feb 4/95

the company



© 2020

Lloyd's Register
Foundation