


9.5.99  
16.5.99

# Wood schooner Senhora da Gaya No 468 in the Register Book

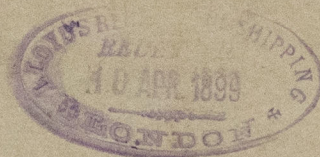

waterway 10 x 5

begins 6" x 8 moulded 9 x 12 sided and in way of the hatch and mast  
Partners 2 beams fastened together  
wood ledger knees all for aft  
5 pair of large iron knees  
spacing 3 frames 21"

ceiling 2.6 by 5 1/2 thick  
through fastened with  
1/2 bolts clamped  
inside.

Floor 11" moulded 6 sided  
double fastened together with wood treenail.

First futtock 8 1/2 moulded 6 sided

second " 7 1/2 " 6 "

top timber 7 1/2 " 6 "

The whole of the material Portuguese Oak & pine.

Dimensions Breadth deep  
86 ft long 23.3 - 8 x 8


Gross 112 tons

outside plank fastened with bolts and  
spikes no treenails.

This vessel was built Espoende in 1894

Middle fine boll. Copper and iron 1 1/8 x 1 1/4  
Keelson 16 x 16

wood platform above the floor

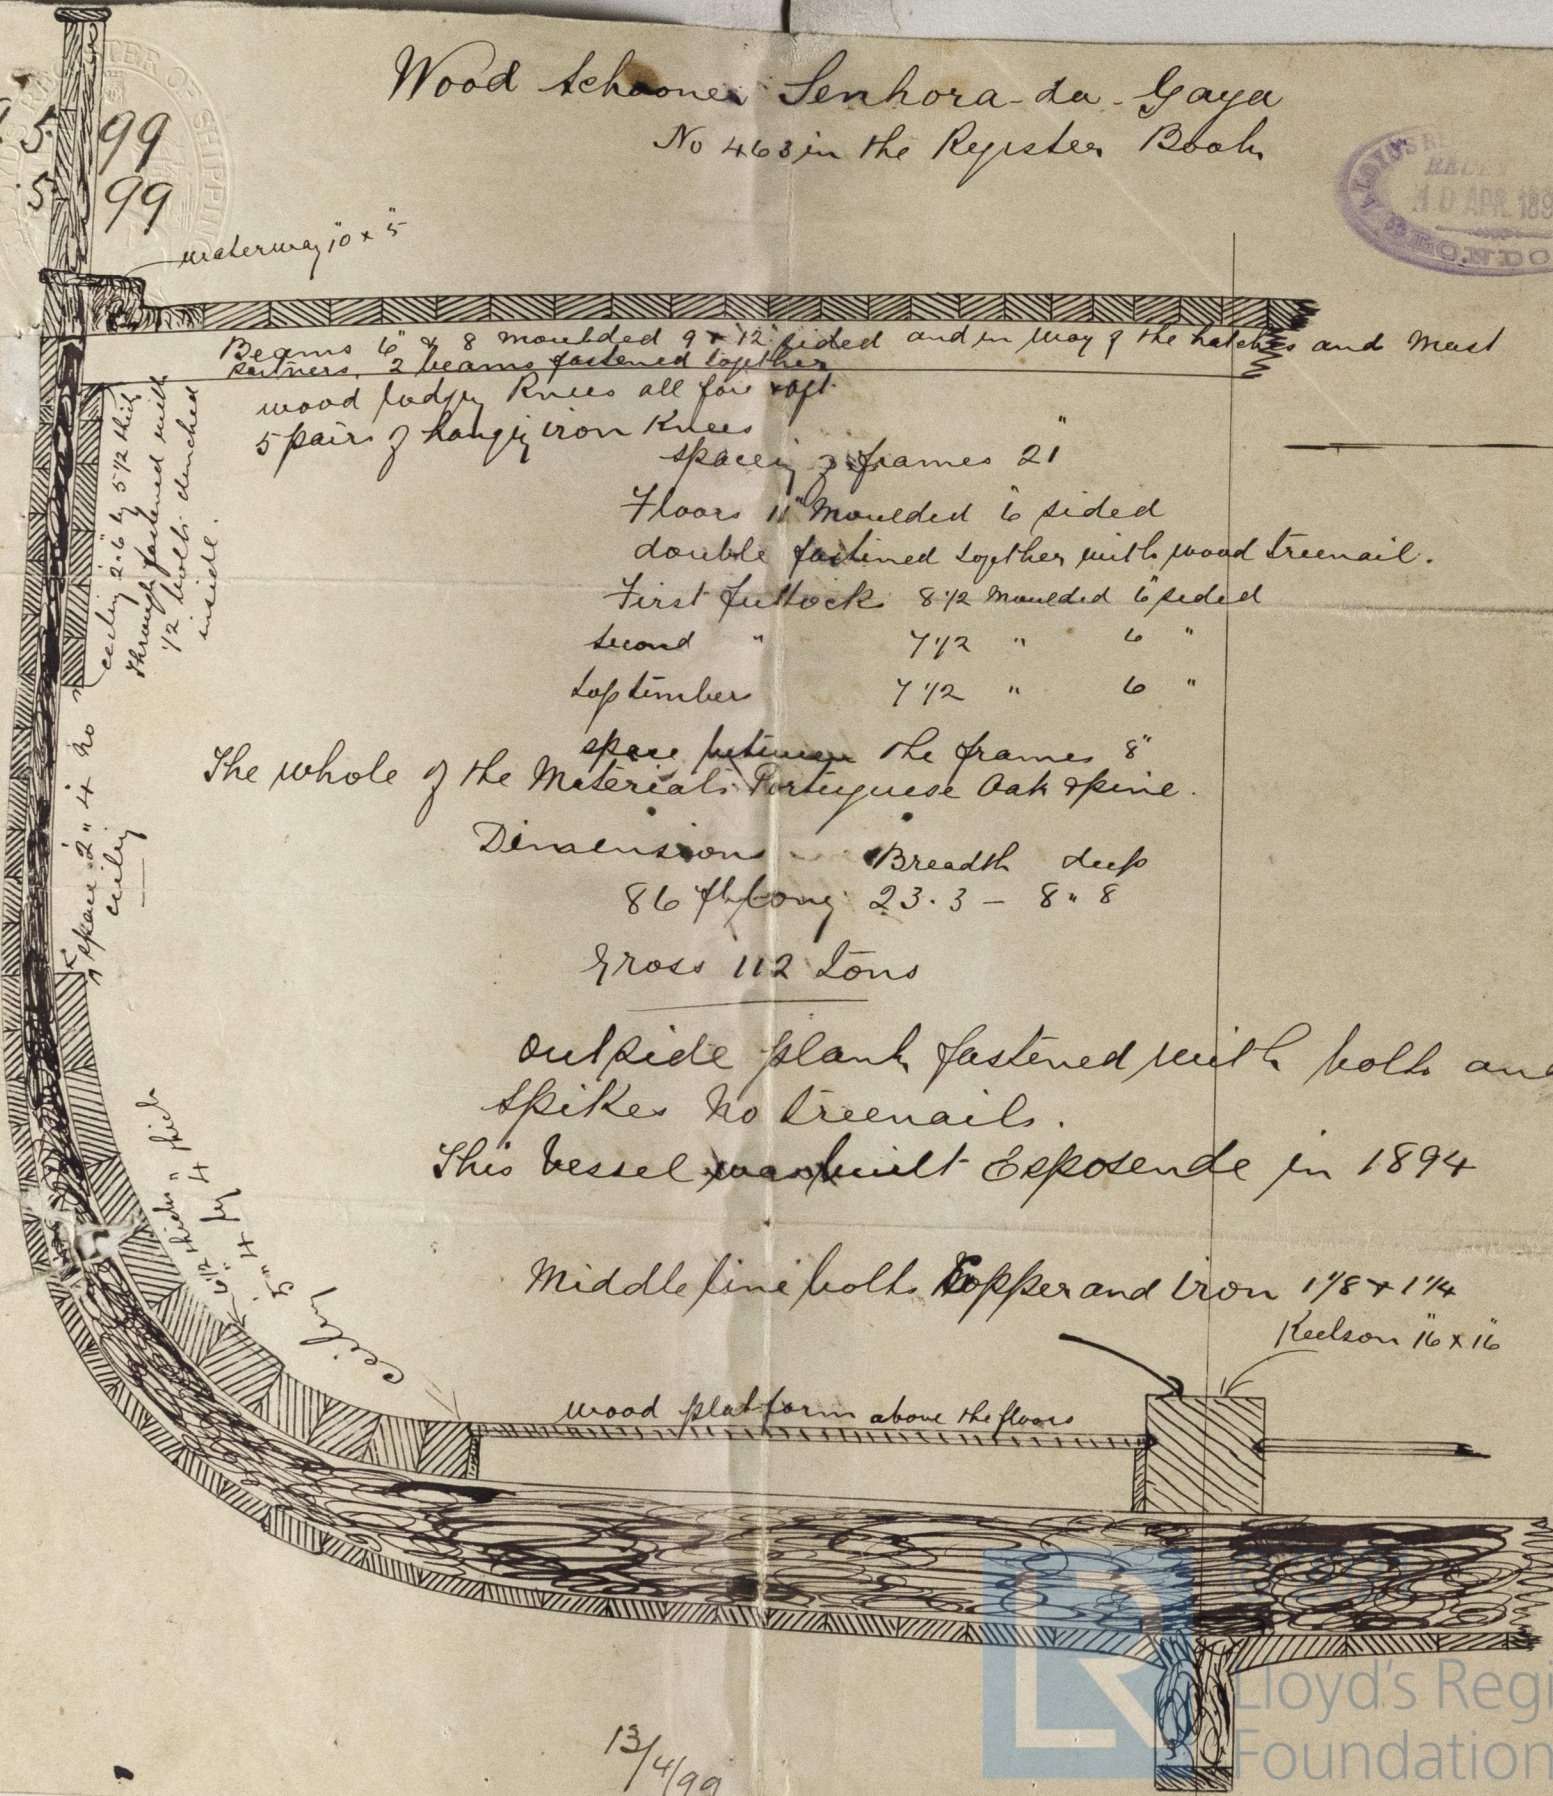

13/4/99


Fal 137 10173

such recommendations as might be necessary

same is fitted as the main  
Deck Beams



*Salmon*  
*Report No 4268.*

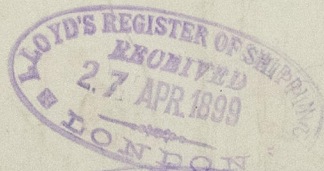

© 2021

Lloyd's Register  
Foundation