

30-11-98




sp. *Penzance*

No. 4303

© 2013
Lloyd's Register
Foundation
FAL 138-0007

12.12.98
 5:12:98
 LLOYD'S REGISTER OF SHIPPING
 LONDON

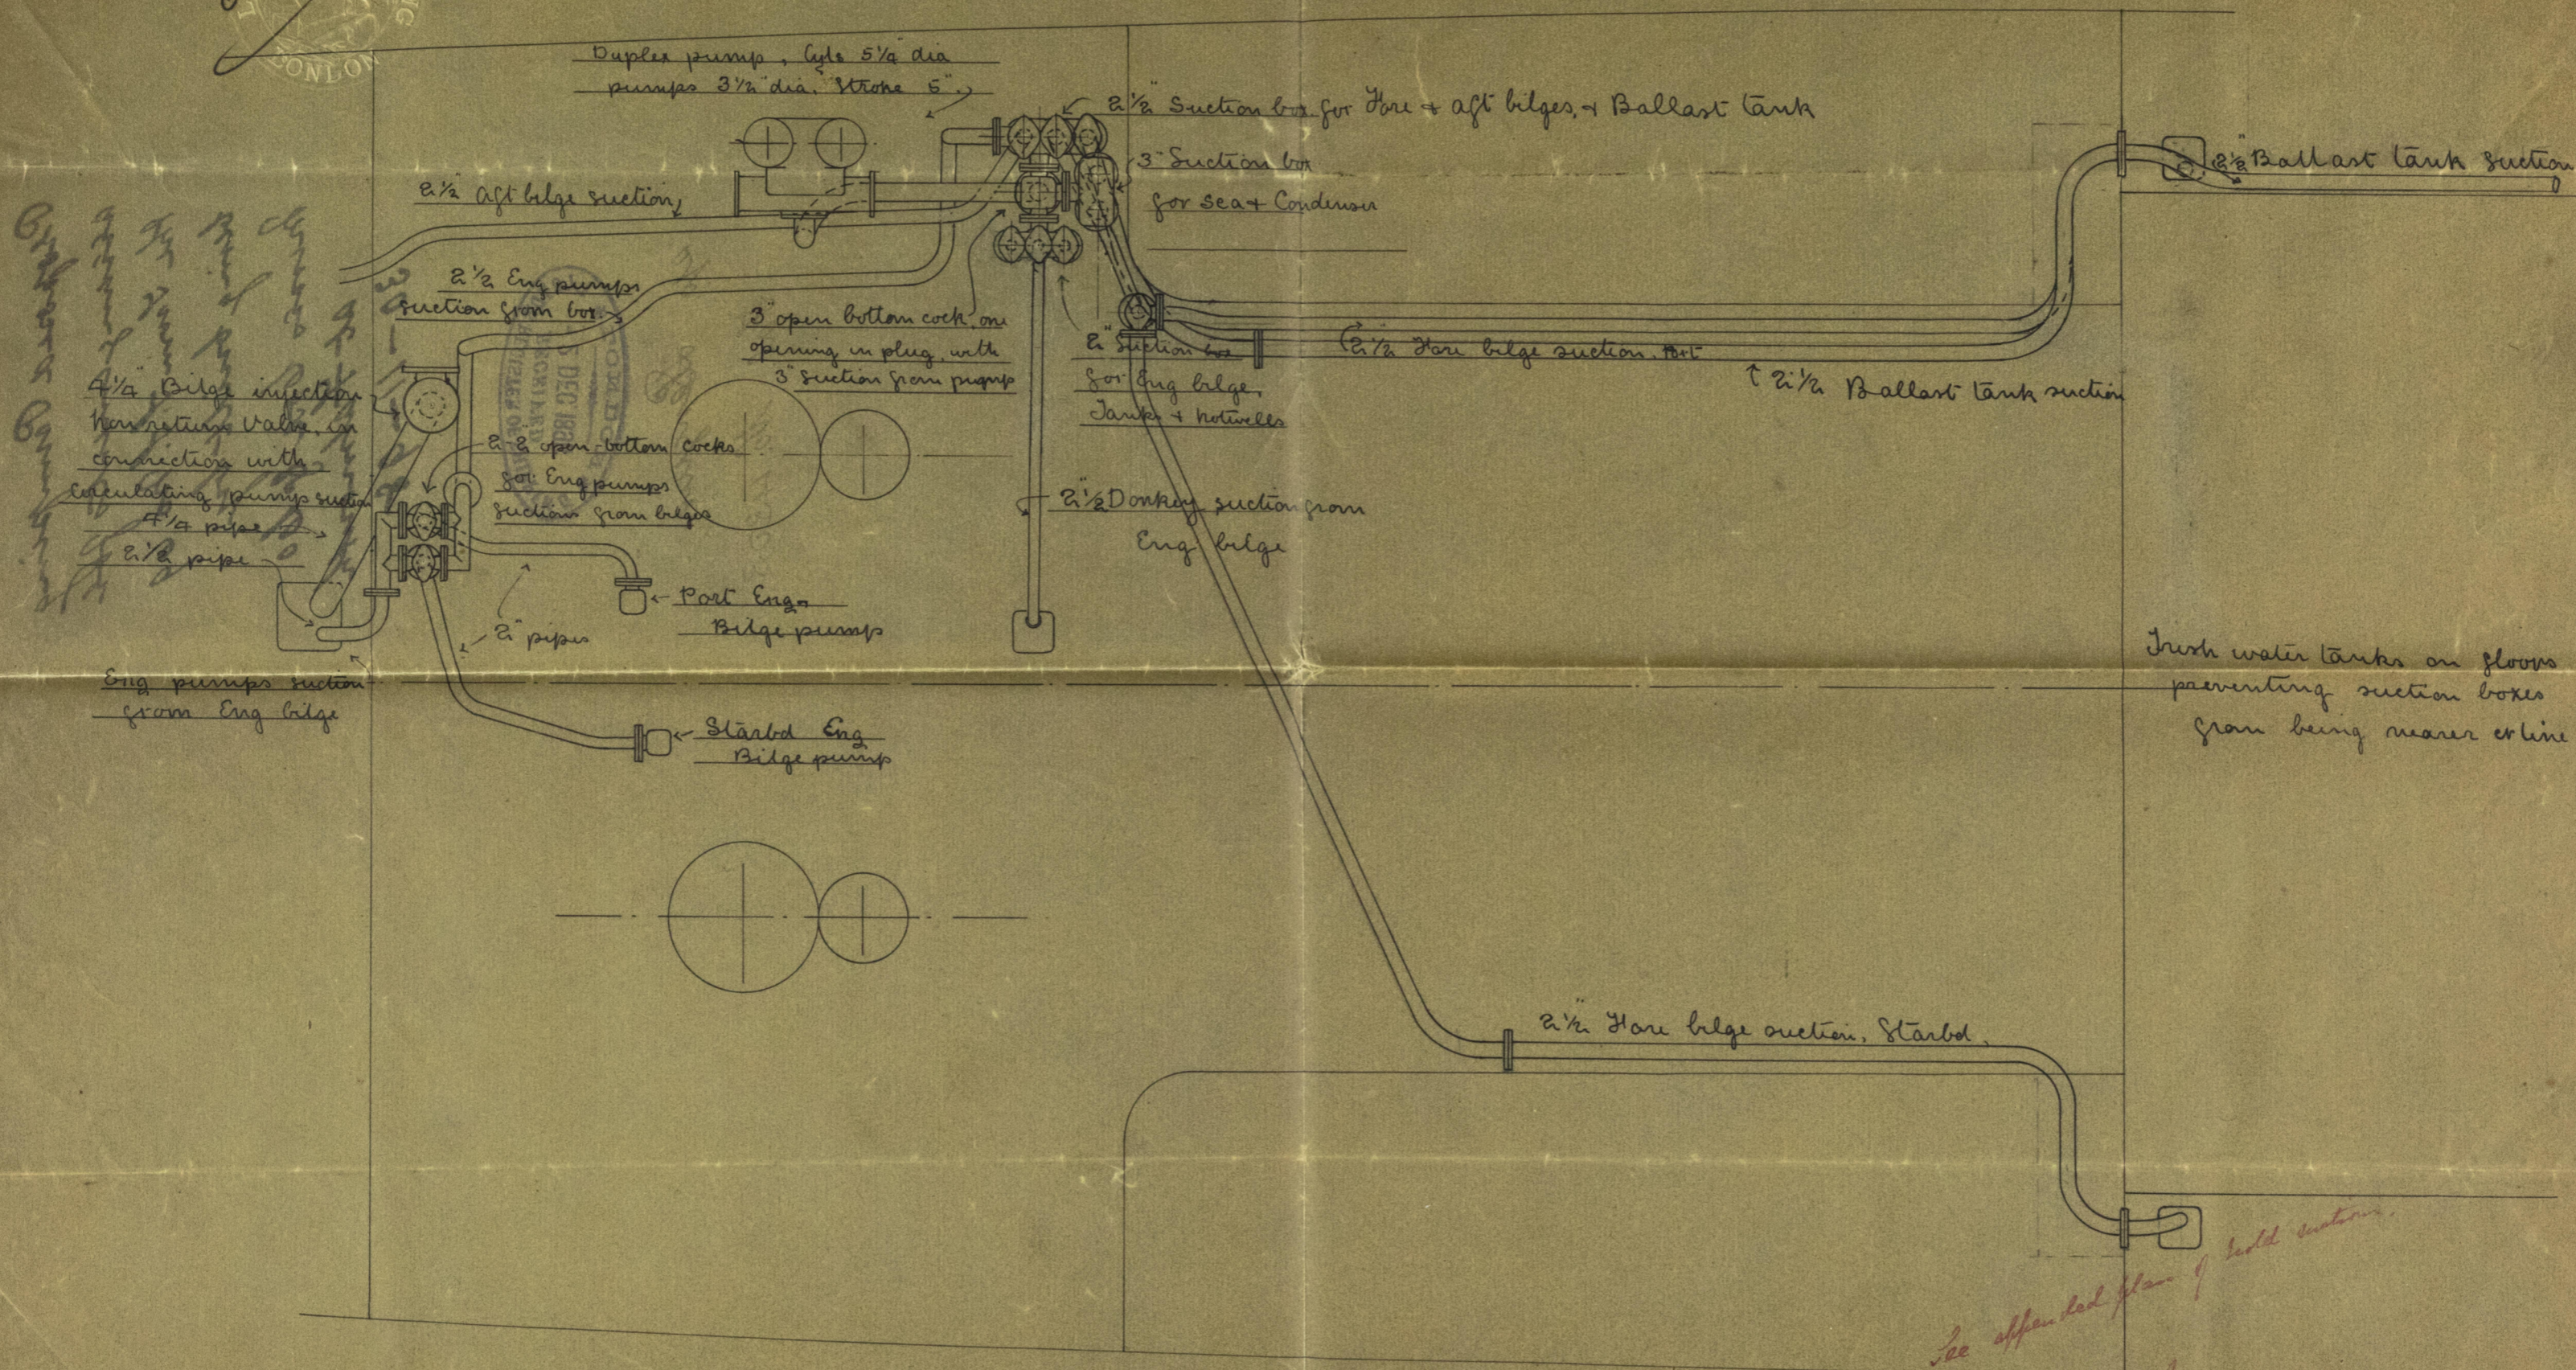

Proposed Bilge pumping arrangement. Ship No 69



© 2019

Lloyd's Register
Foundation