
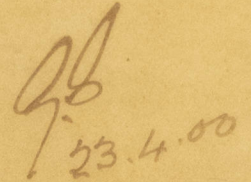


Profile.





[illegible]

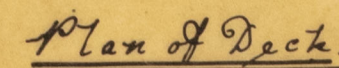

53 7.00  
58

S. S. Lord Panmure  
Palmouth office  
2

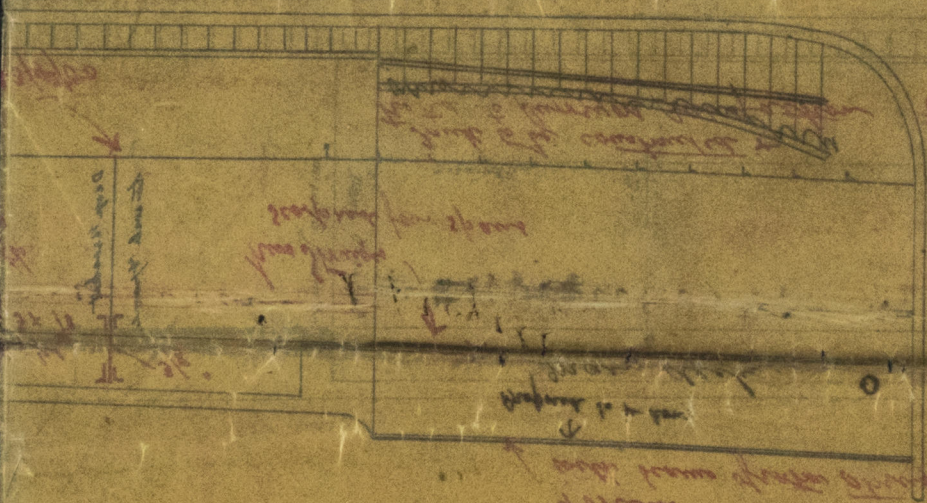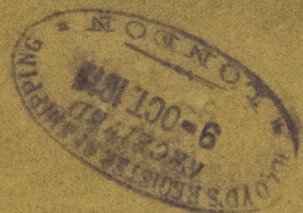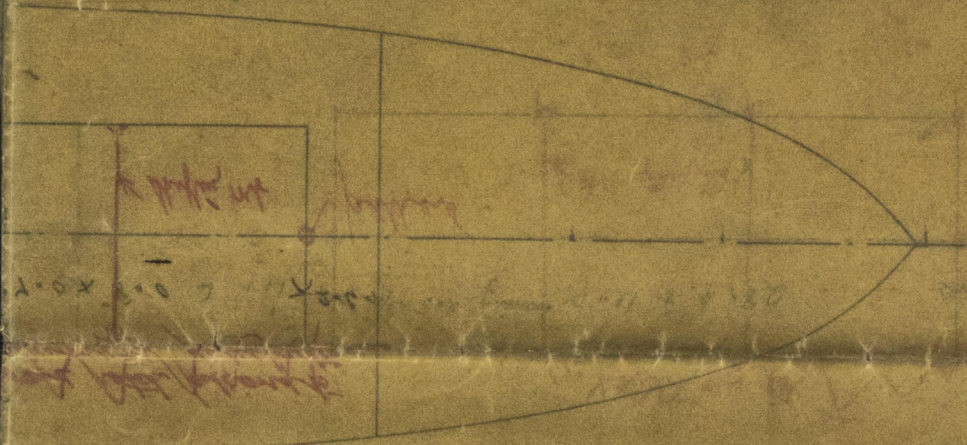

© 2020  
Lloyd's Register  
Foundation

Palmouth 4357

FAL 38 0016