



30.11.05

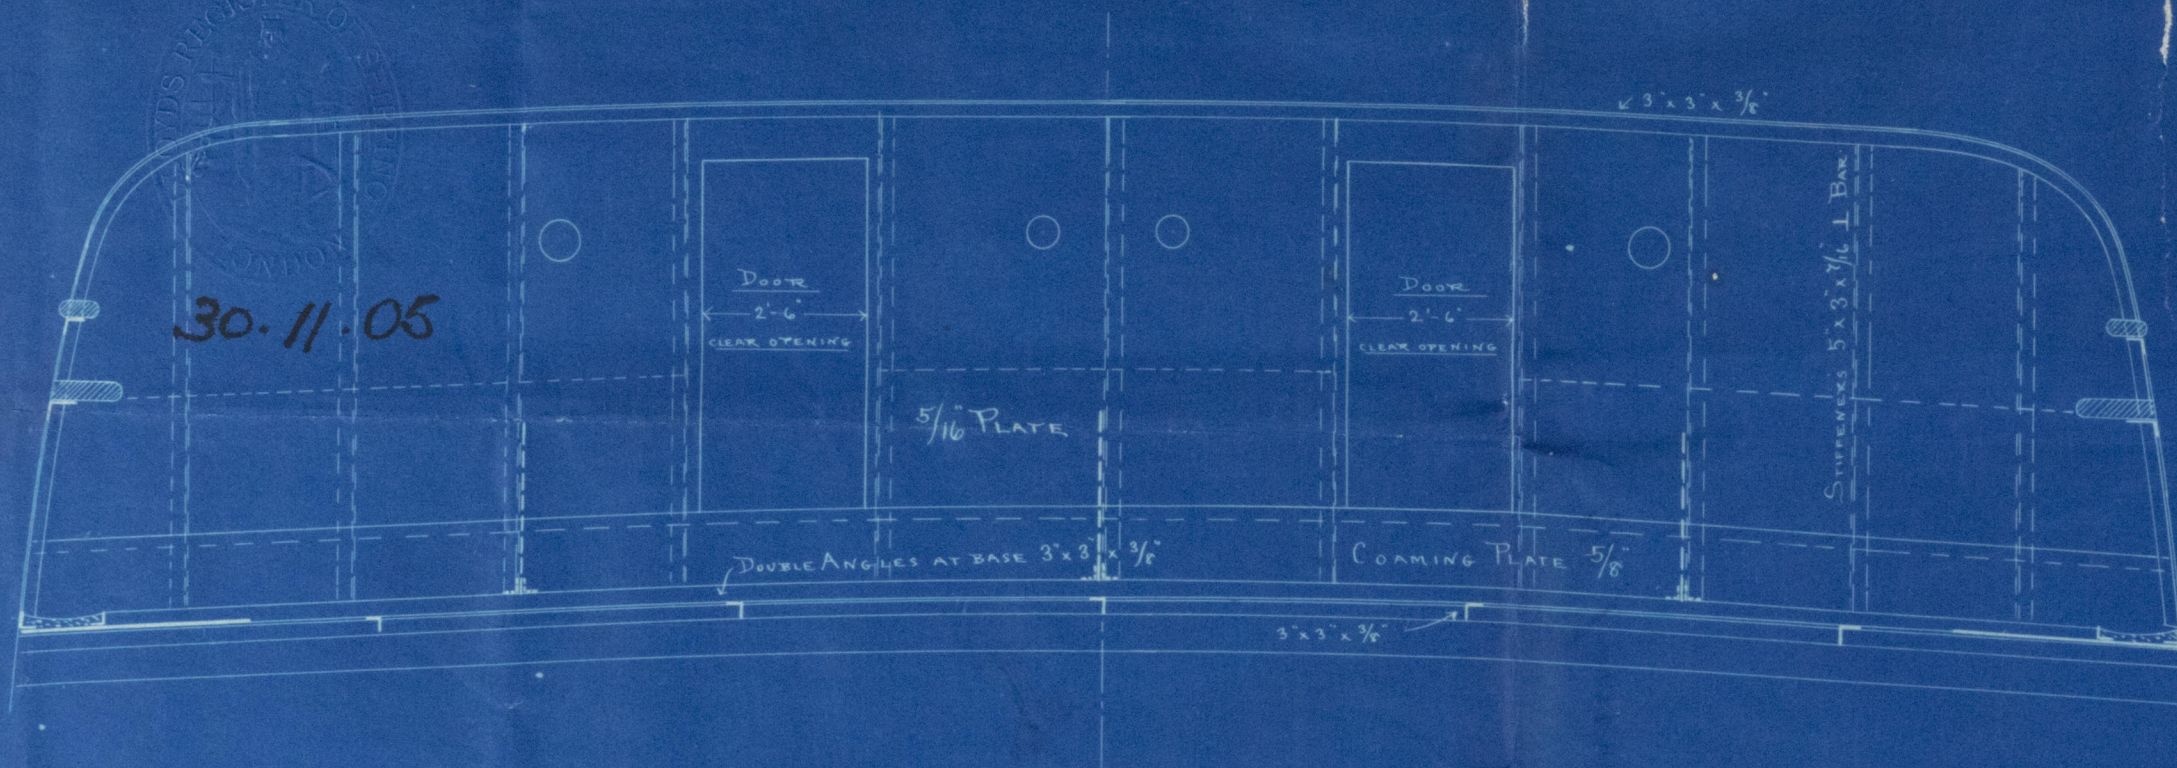

BARQUE "COMMONWEALTH"
 PROPOSED STEEL BULKHEAD AT FORE END OF POOP.
 SCALE 3/8" = 1'-0"

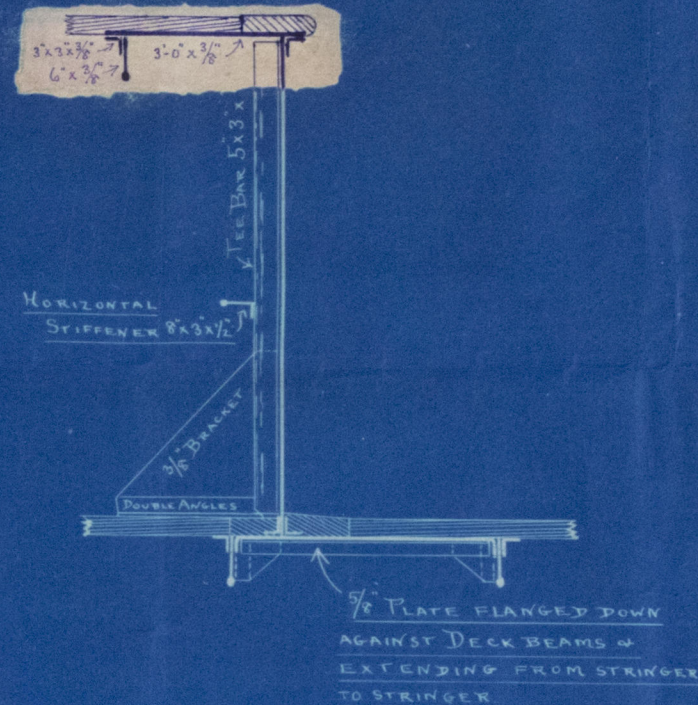

C.F.
 30/11/05



© 2019
 Lloyd's Register
 Foundation



© 2019

Lloyd's Register
Foundation

Palmer