

To Class 100 A1 SPARDECK


with angle bars  
d. The recess built  
by angle bars  
of the vessel to be  
a water-tightness  
recessed in.  
with angle bars two  
sided and side at an  
as the adjoining



S.S. "Venus"

Gen. 1780

Abidship section

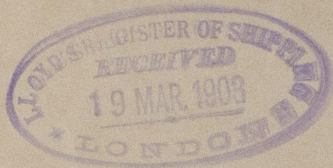

GEN 1114-0027



© 2020

Lloyd's Register  
Foundation




181.R

Mudrupskel

Venus  
to Jupiter

Genoa N. 1750

Incorrect for this  
vessel.

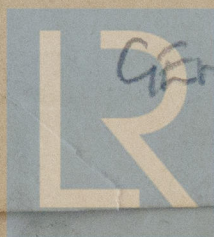

© 2020  
GEN 1114 0027

Lloyd's Register  
Foundation