






Proscavo 181 R

P 45
116

Settore del timone

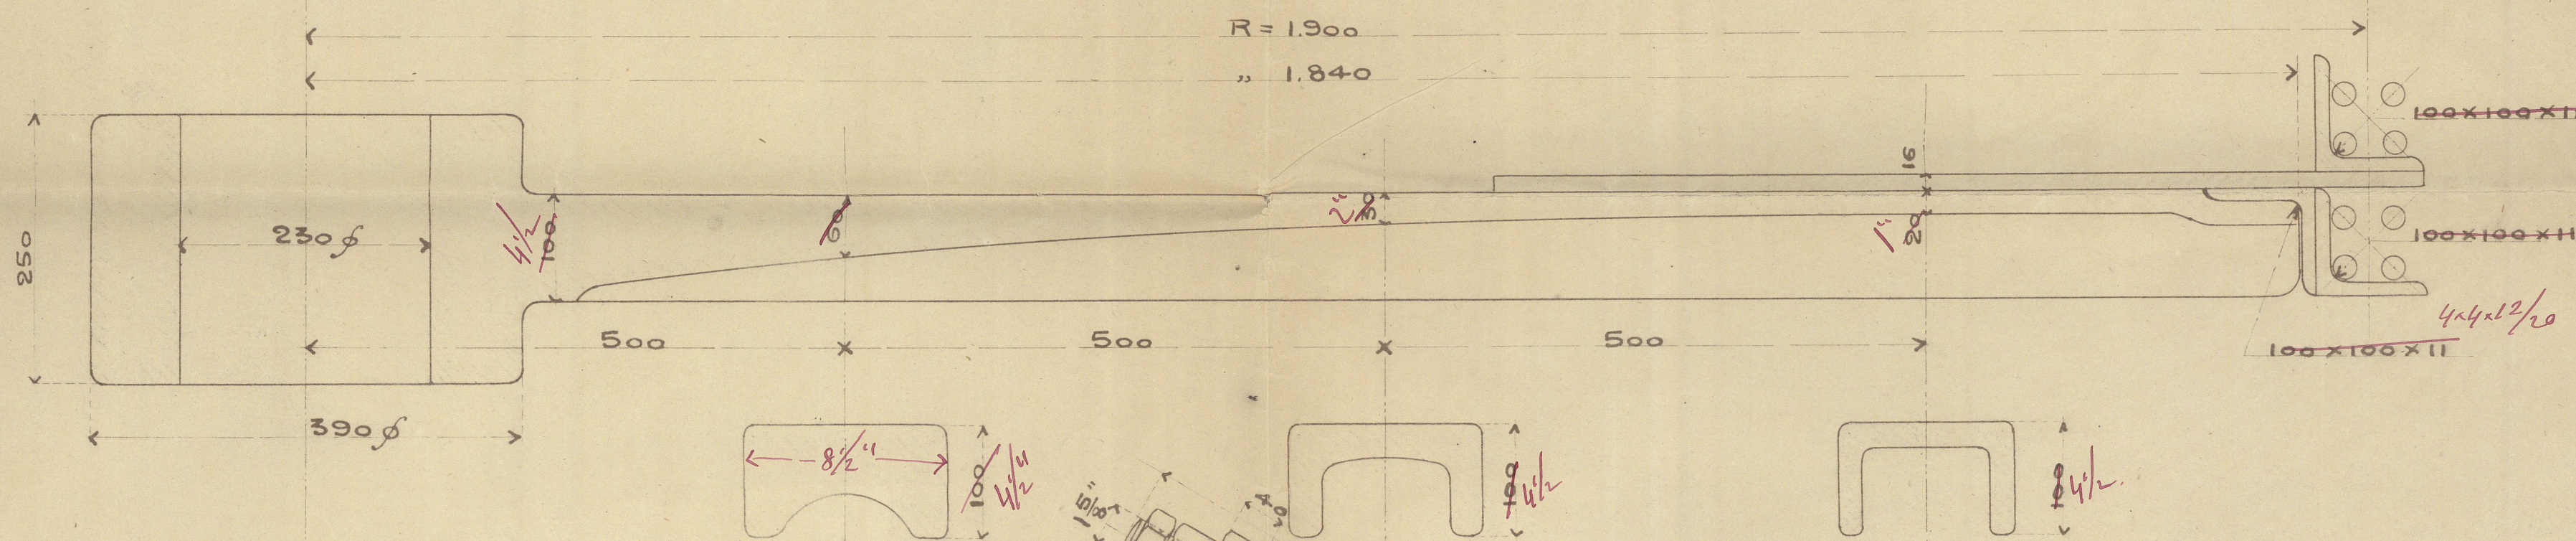

Scala 1:5

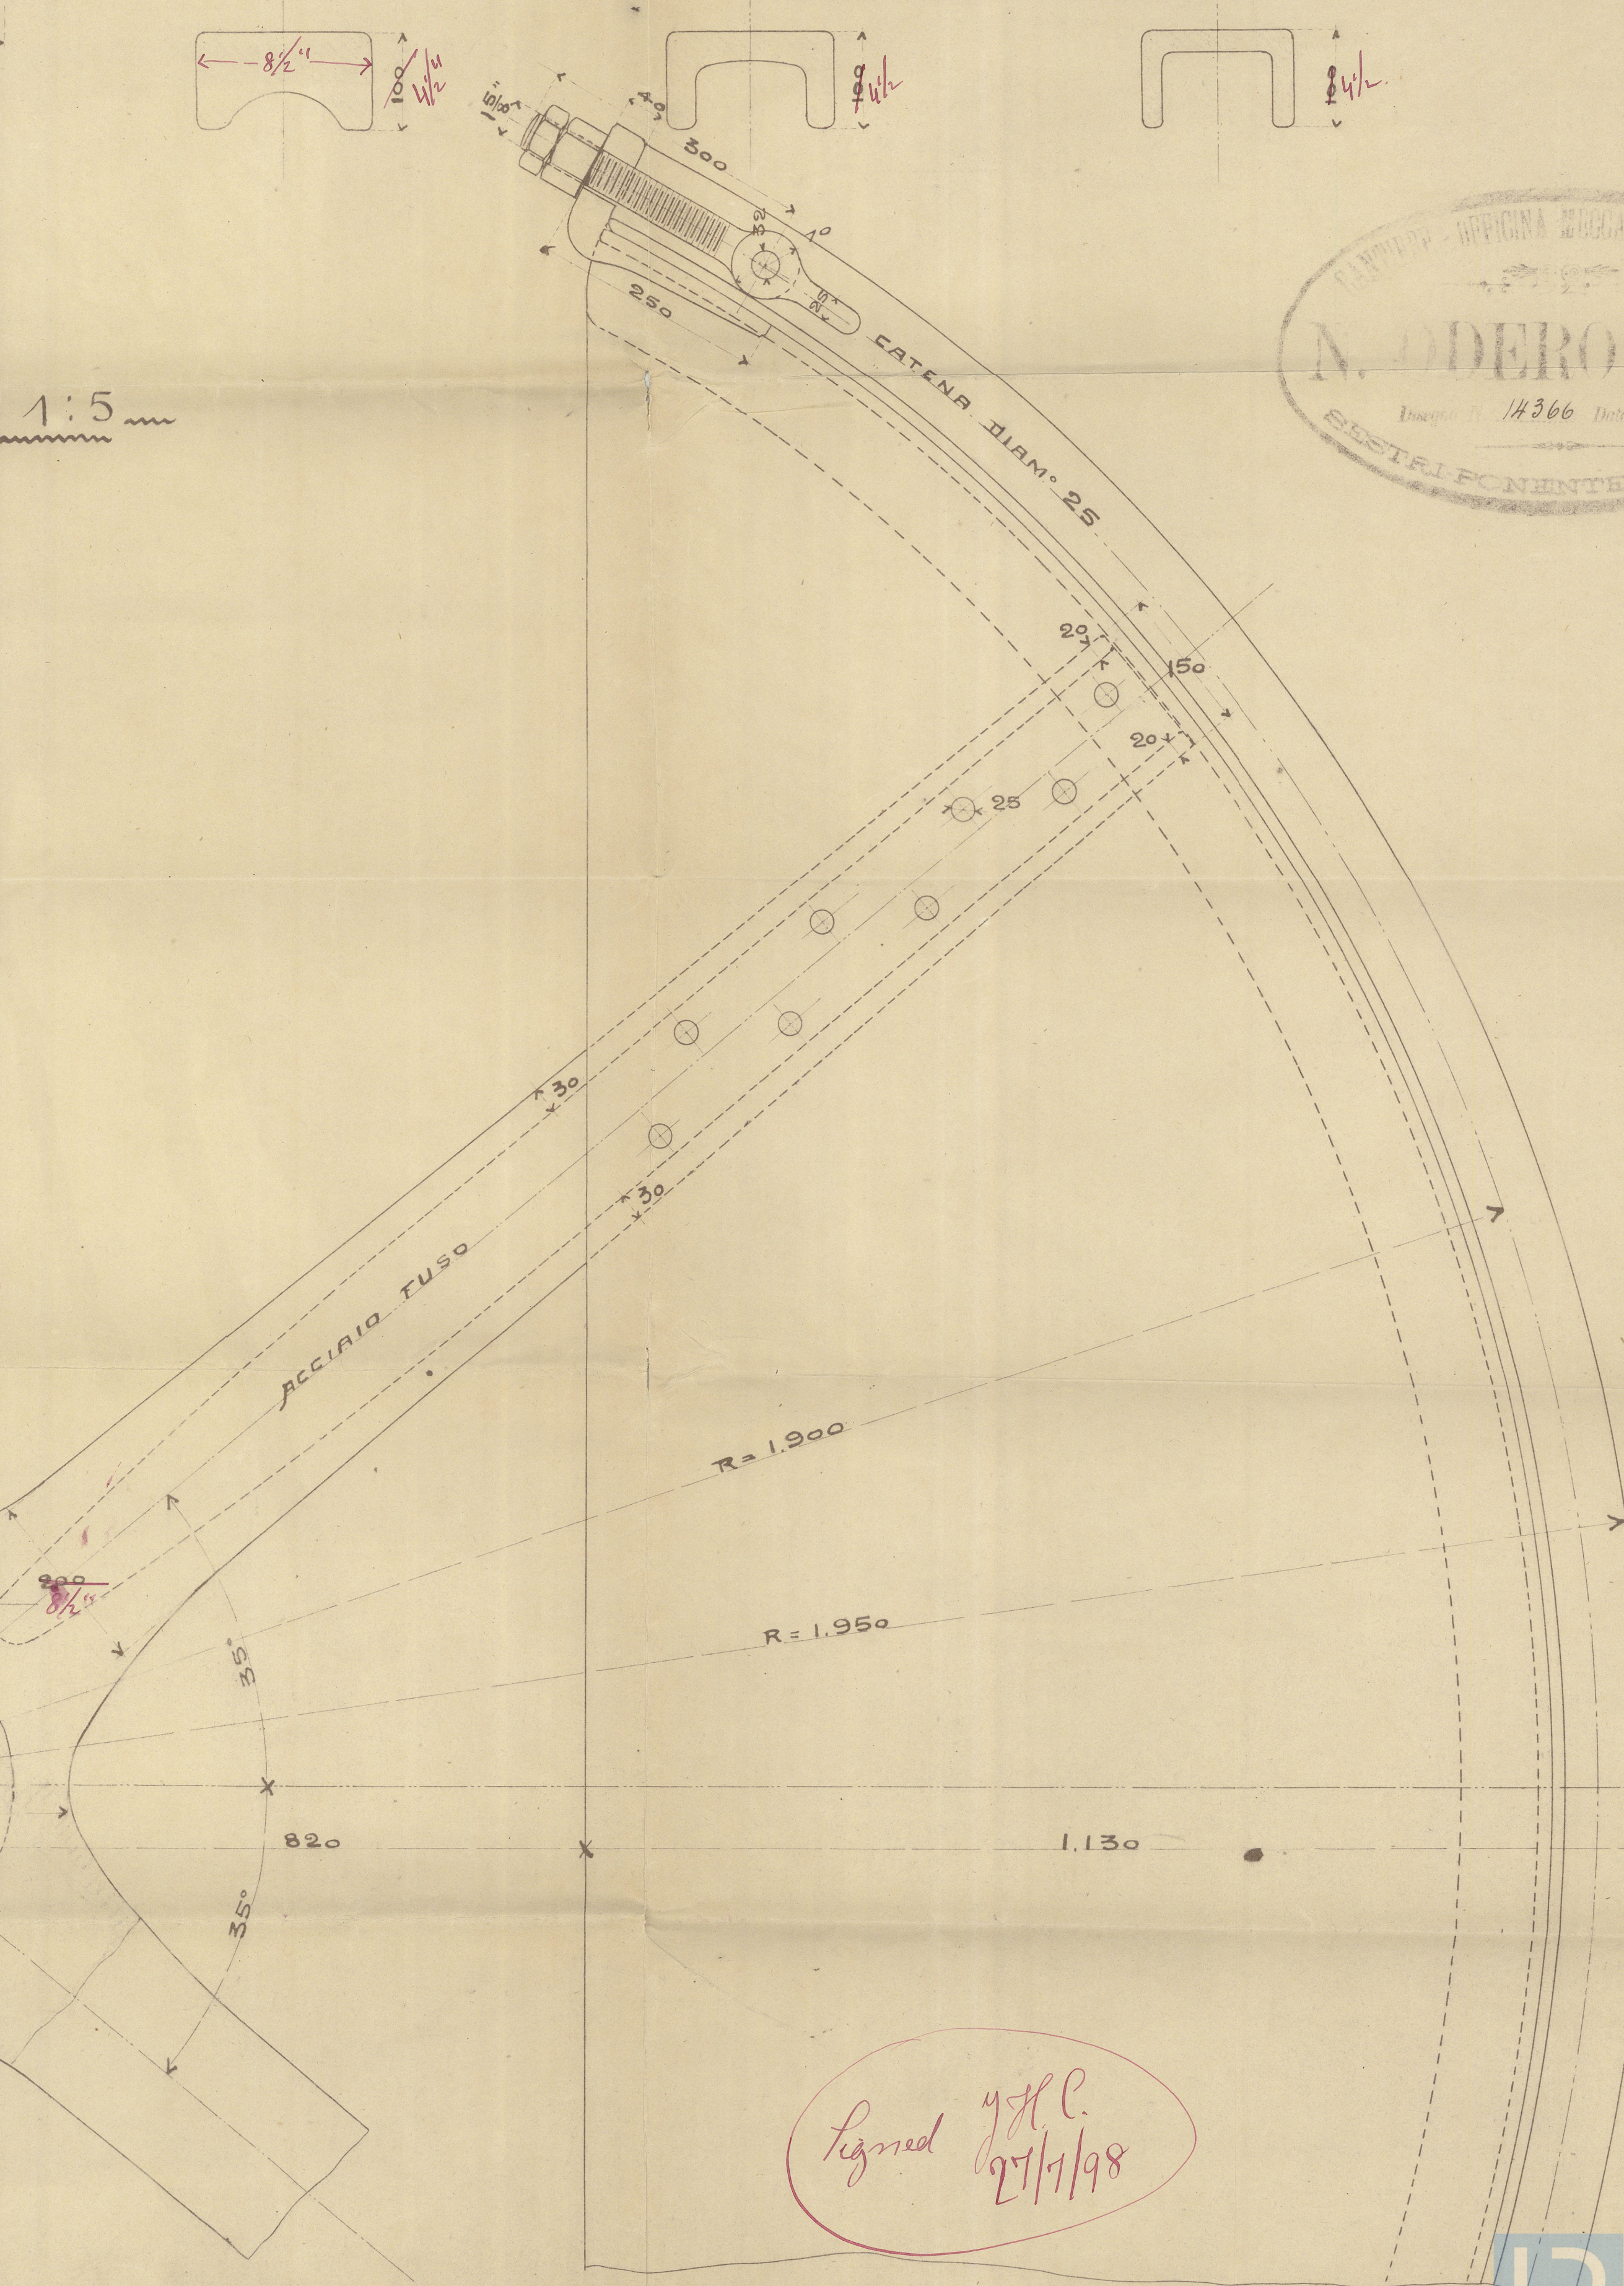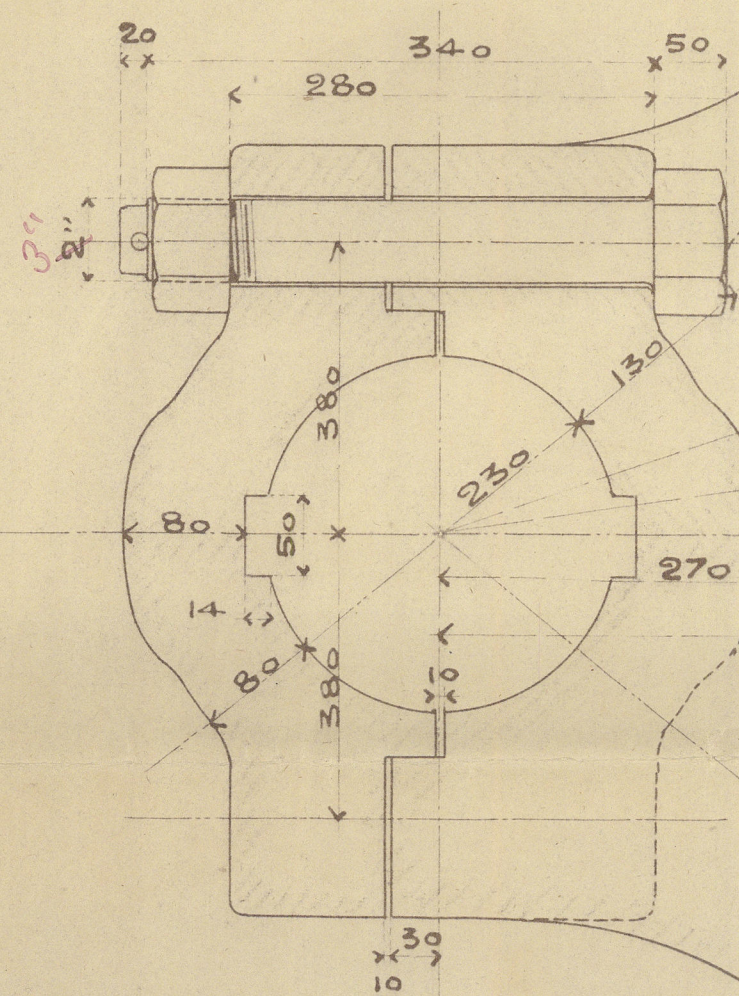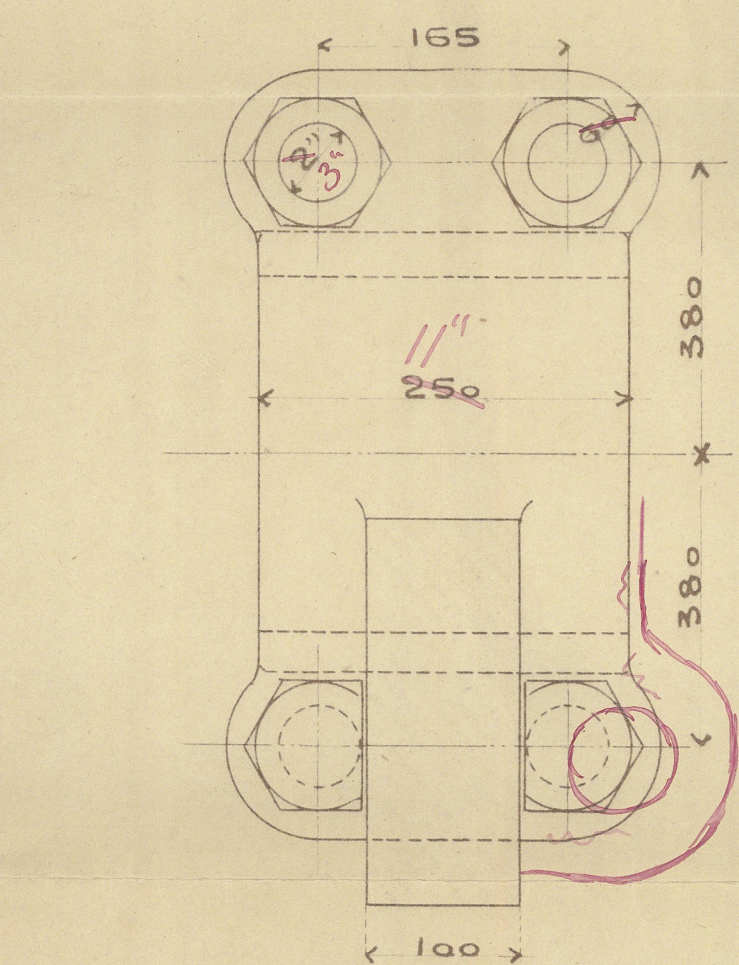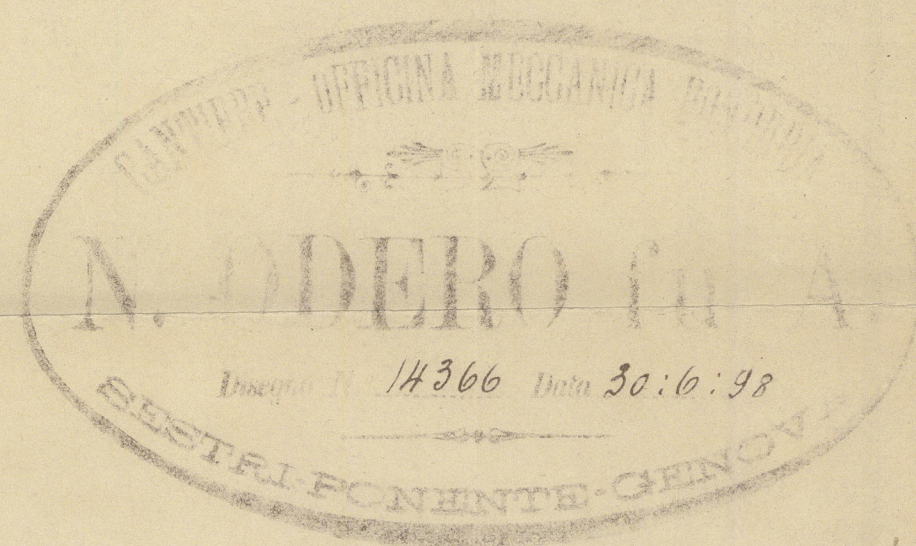

signed y.H.C.
27/7/98

Orders no. 181 R.

~~Stern Post.~~

~~Henry~~ Henry Quadrant

S.S. "Venus" Gen. 1780.

B36u
Gen. Rev.



© 2020

Lloyd's Register

GEN1144-0031