

Lloyd's Register of British and Foreign Shipping.

(Report on Vessel No. 4459 Port Glasgow
Balclutha.)

No. 1264

SHIP FORGINGS OR CASTINGS.

I have to report that the undermentioned Iron ~~or Steel~~ Forgings or Castings, manufactured by
Messrs E. Connall & Co of Glasgow,
for the Vessel No. 147, being built by them
of _____ have been inspected by me as set forth below, and found
to be, so far as can be seen, sound and efficient.


Mark on Forgings.

Lloyd's
No. 1264
G.N.

George Newcomb,
Glasgow, 10/4/86

	STERN FRAME	RUDDER FRAME.	STEM & Keel
Material* - - -	<u>Scrap iron</u>	/	<u>Scrap iron</u>
How made - - -	<u>Forged</u>		<u>Forged</u>
Dimensions - - -	<u>9" x 2 1/2"</u>		<u>Stem 9" x 2 1/2" Keel 9 1/2" x 2 1/2"</u>
Progress on Inspection -	<u>Forging & smithing</u>		<u>Forging.</u>
Dates when Inspected {	<u>8.15.23/6/86.</u>		<u>8.15.23/6/86. 2/7/86.</u>

SKETCHES OF FRAMES SHEWING POSITION AND DESCRIPTION OF WELDS OF FORGINGS, OR PARTICULARS OF TESTS APPLIED TO CASTINGS.

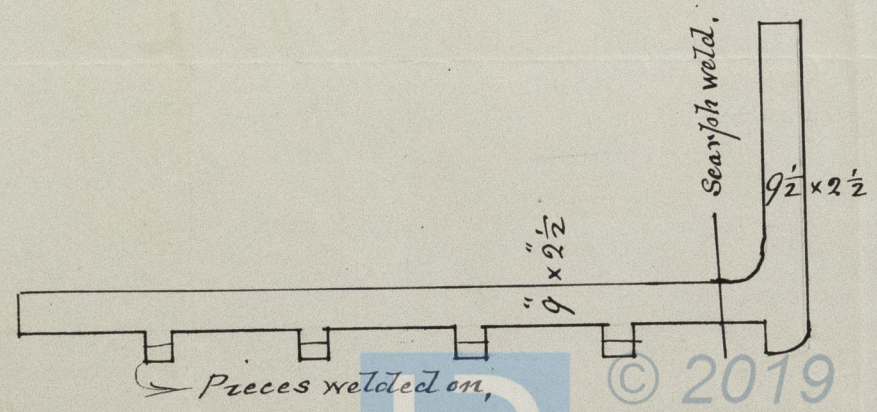

* If of Iron, state whether scrap or puddled iron.