

Lloyd's Register of British and Foreign Shipping.

(Report on Vessel No. 4459 Port Glasgow)
Balclutha

No. 1264

SHIP FORGINGS OR CASTINGS.

The words FORGINGS or CASTINGS, IRON or STEEL, should be struck out as may be required.

I have to report that the undermentioned Iron ~~or Steel~~ Forgings ~~or Castings~~, manufactured by Messrs C. Connall & Co of Glasgow for the Vessel No. 147, being built by them of — have been inspected by me as set forth below, and found to be, so far as can be seen, sound and efficient.

Mark on Forgings.

Lloyd's
 No. 1264
 Q. No.


George Newcomb.

Glasgow.

2/10/86.

	STERN FRAME.	RUDDER FRAME.	STEM.
Material*	/	Scrap iron	/
How made		Forged	
Dimensions		6 1/4 & 3 3/8	
Progress on Inspection		Forging & smithing	
Dates when Inspected		2.13.28/7/86. 4/8/86. 1.14.28/9/86.	

SKETCHES OF FRAMES SHEWING POSITION AND DESCRIPTION OF WELDS OF FORGINGS, OR PARTICULARS OF TESTS APPLIED TO CASTINGS.

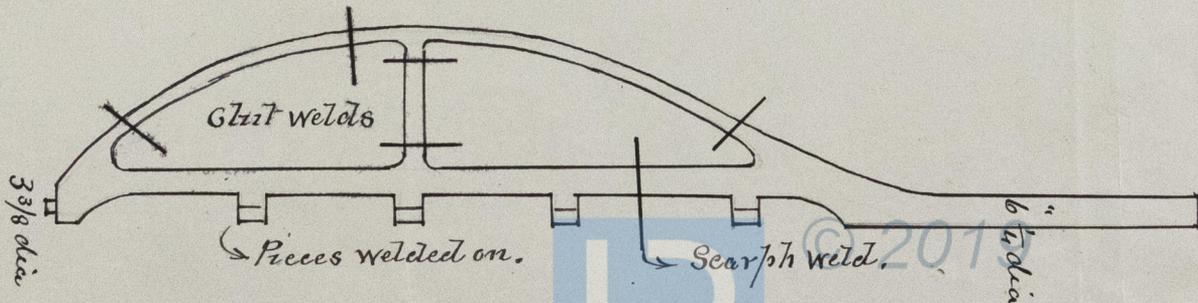

* If of Iron, state whether scrap or puddled iron.