


NO 93

 


Length - 190.00 Feet
 Breadth - 28.50 do - 6.76 Breadth in Length
 Depth - 14.33 do - 13.85 Depth in Length
 Sponge Water Deck 500 Ins.
 Gross 750 Ins.

Hyndman & Co
 ENGINEERS & SHIP BUILDERS
 Ship Dock RENFREW

SCALE 1/2 INCH TO A FOOT

Light Querry Deck S.S. "Sakura" 18.5.64

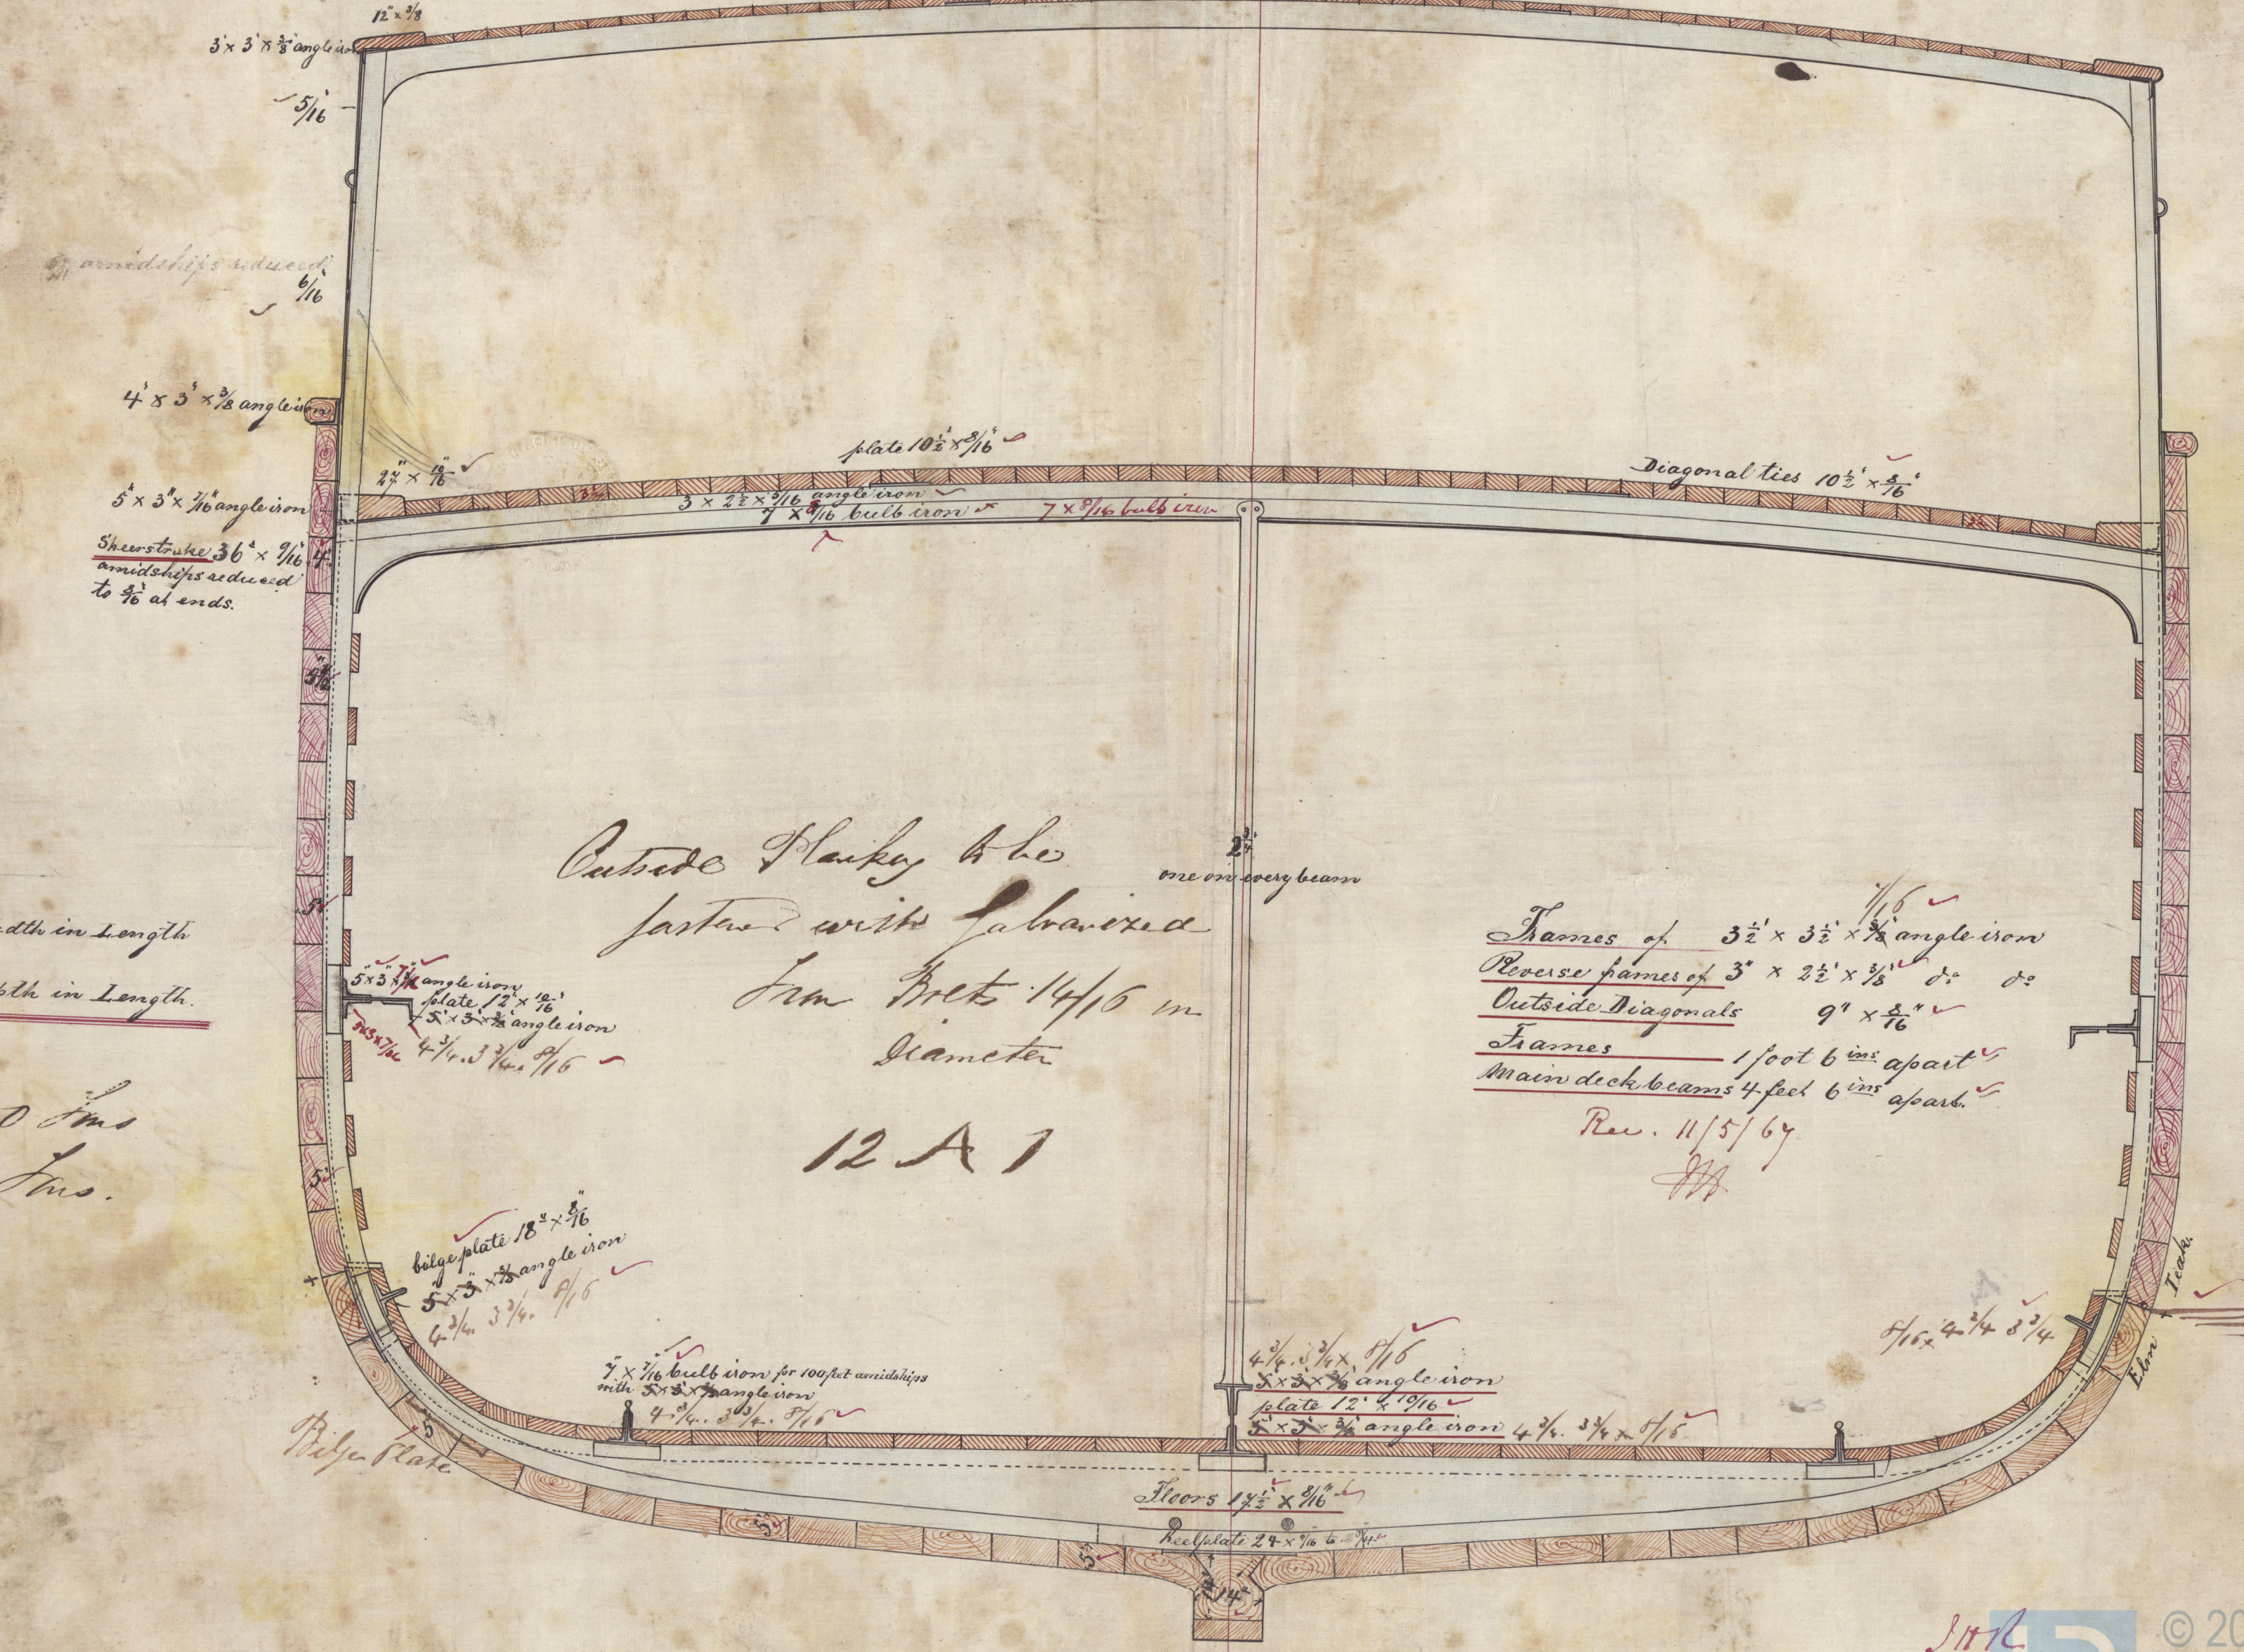

 Diameter
 12 A 1

Frames of 3 1/2 x 3 1/2 x 1/2 angle iron
 Outside Diagonals 9 x 1/2 in.
 Frames 1 foot 6 in. apart
 Main deck beams 4 feet 6 in. apart

SCALE 1/2 INCH TO A FOOT