

MIDSHIP

SECTION


Nº 128

S. Arkham Castle
2974

2974 glo

Scale $\frac{1}{2}$ Inch to one Foot

Recd 26/11/68
See spec

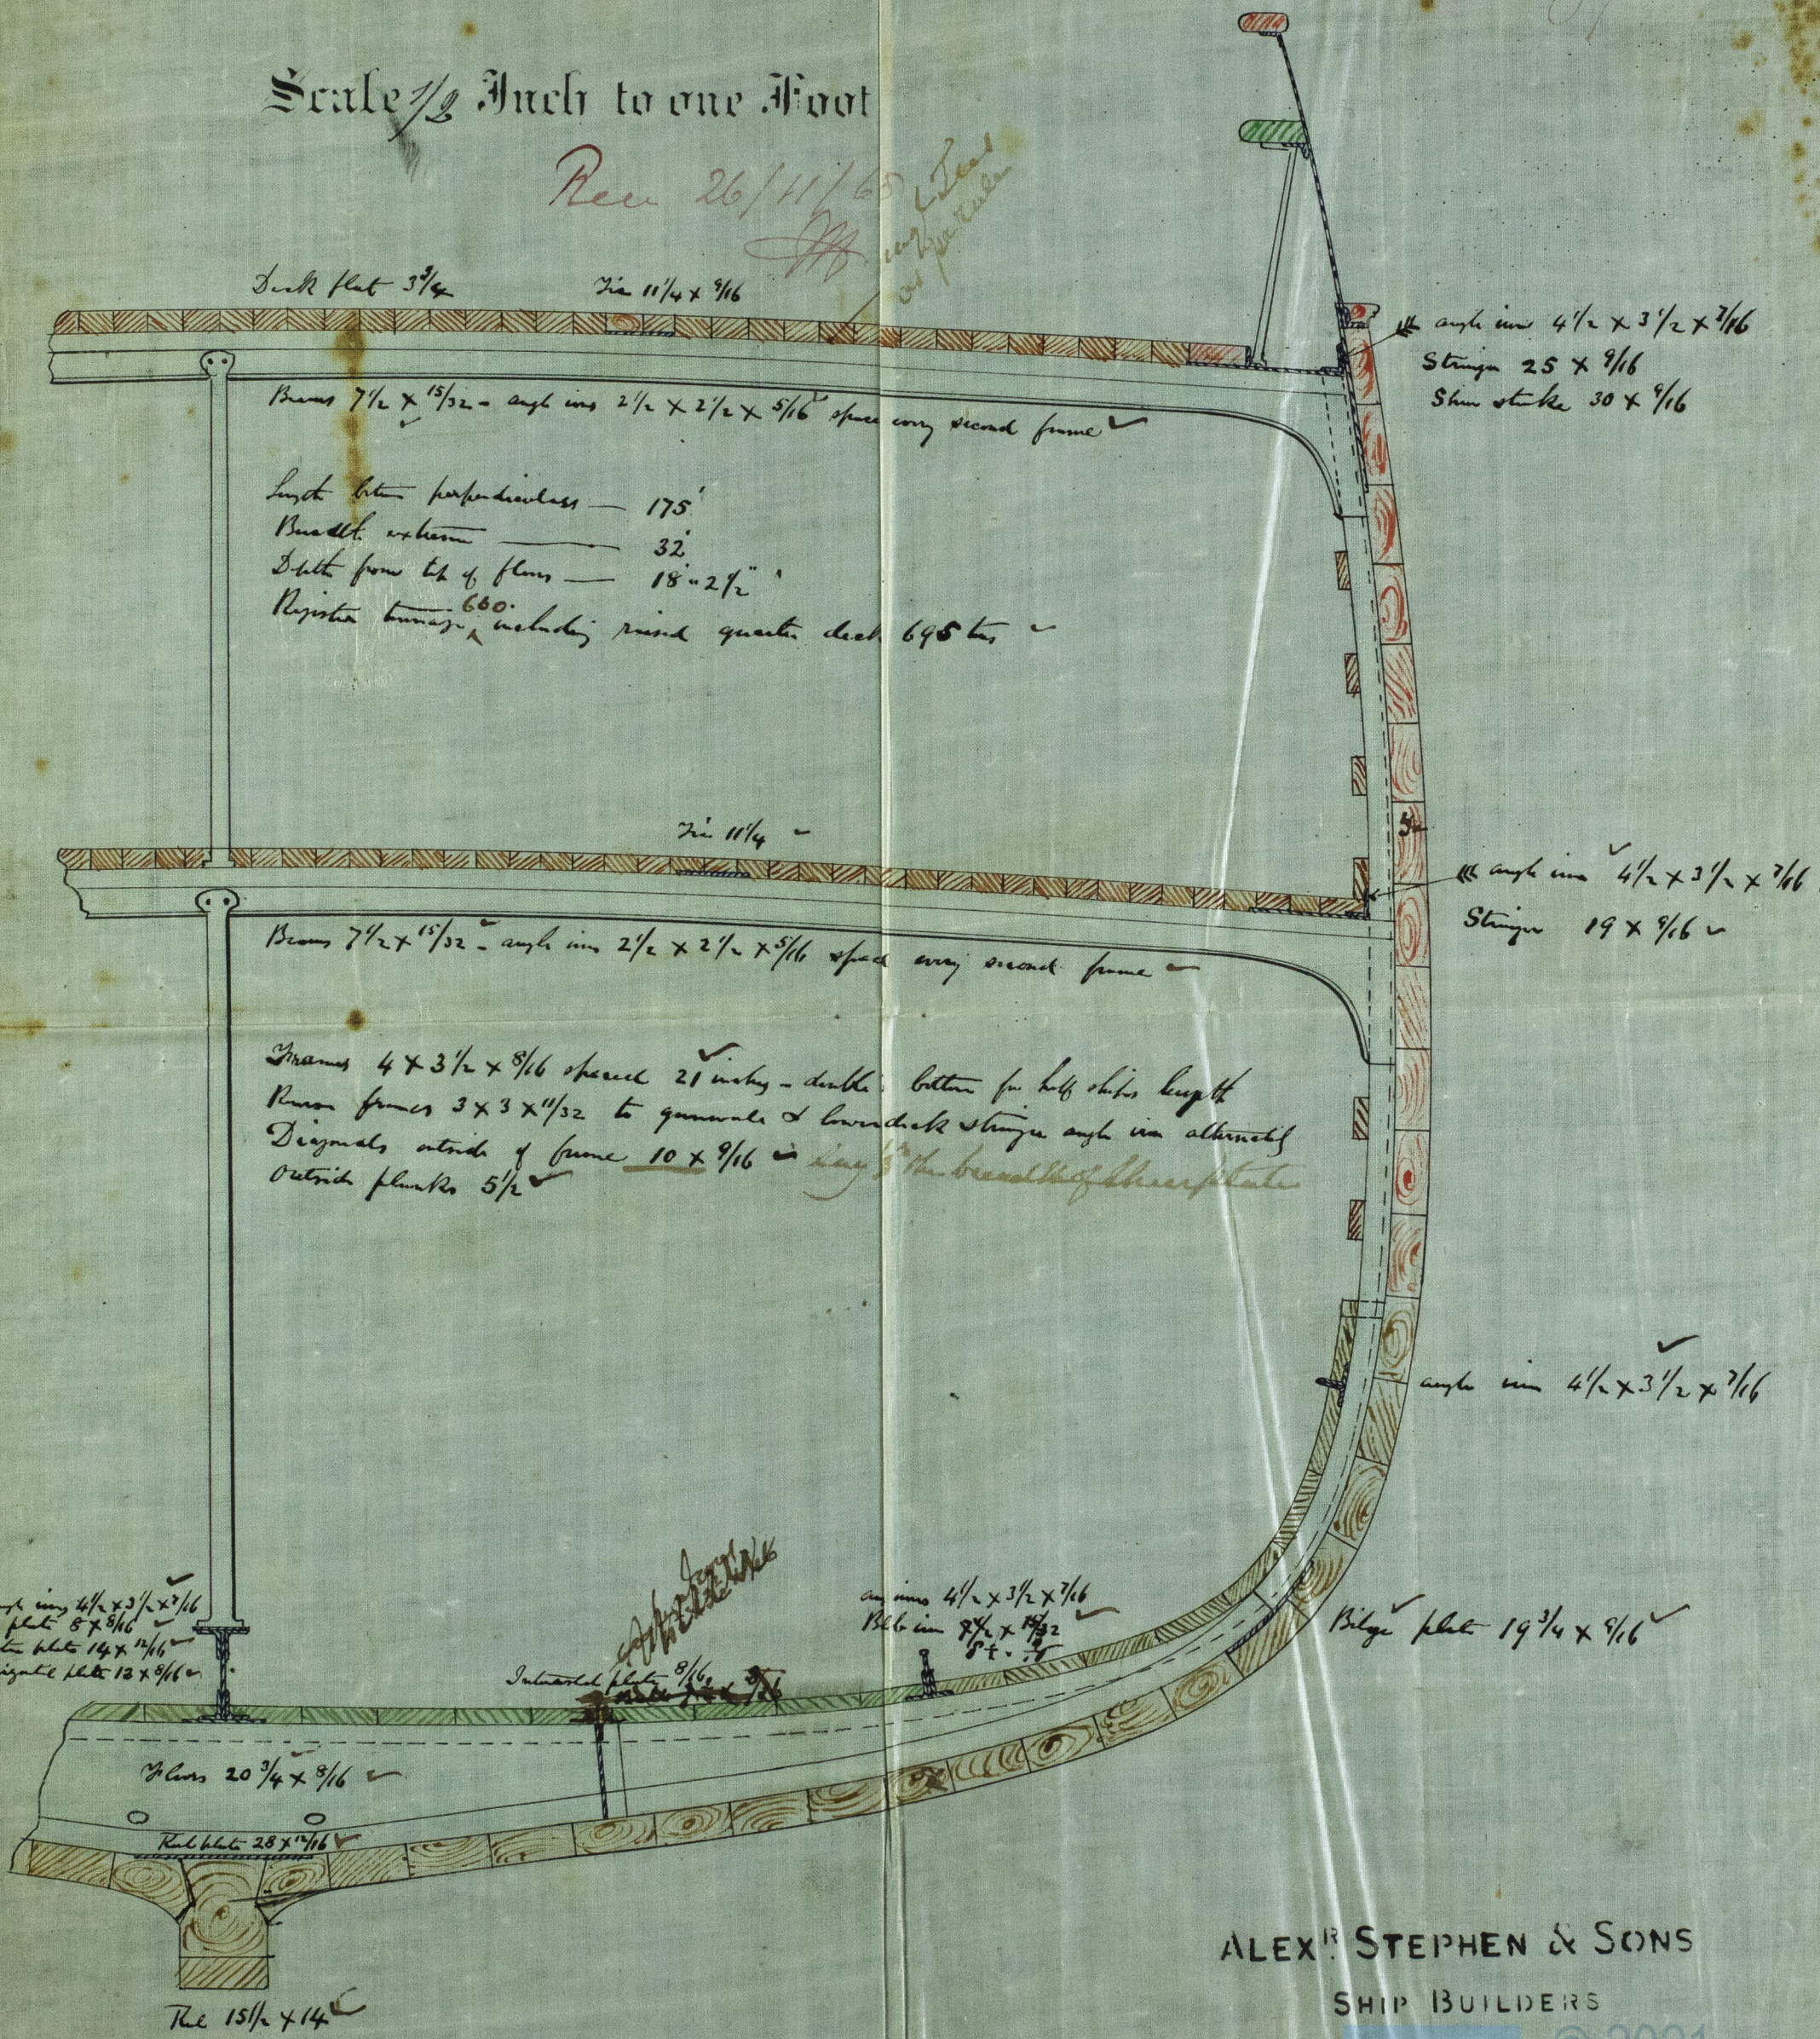

ALEX^R STEPHEN & SONS
 SHIP BUILDERS

GLASGOW

November 24, 1868

26.11.68

GLS 87-0070