

S.S. "EGERON" *Design Report No 185*

N^o 185

COMPOSITE
STEAMER

173 x 25.3 x 14.0

Rec 17/8/94 & 18/3/96 A.I.

under 7' breadth
over 12' depth

Lloyd's 15 Years A1

Length 173'-0"
Breadth moulded 25'-3"
Depth of hold 14'-0"
Tonnage under deck under 400
Regular tonnage + engine space about 435

Balusters 2

Keel 2 1/2" x 9 1/2" for 84 ft
Runstrake 3 1/2" x 9 1/2" for 84 ft
tapering to 2 1/2" x 9 1/2" at ends
Angle iron at top of plating
3 1/2" x 3 1/2"


Forecastle

Plating 9/8
Singer 12 x 3/8 angle 2 1/2" x 2 1/2" x 7/16
Beams 9 x 3/4
Keels 5 x 3/4 angle
Ribs 5 x 3/4

Plating of American elm to
5 ft 6" above top of keel remainder teak
4 1/2" ins thick amidships tapering
to 3 1/2" at extreme ends

Diagonal plates on frames 9 x 2

Iron Bridge Plate 1 1/2" x 1/2" for 100 ft
tapering to 9 x 7/16 at ends

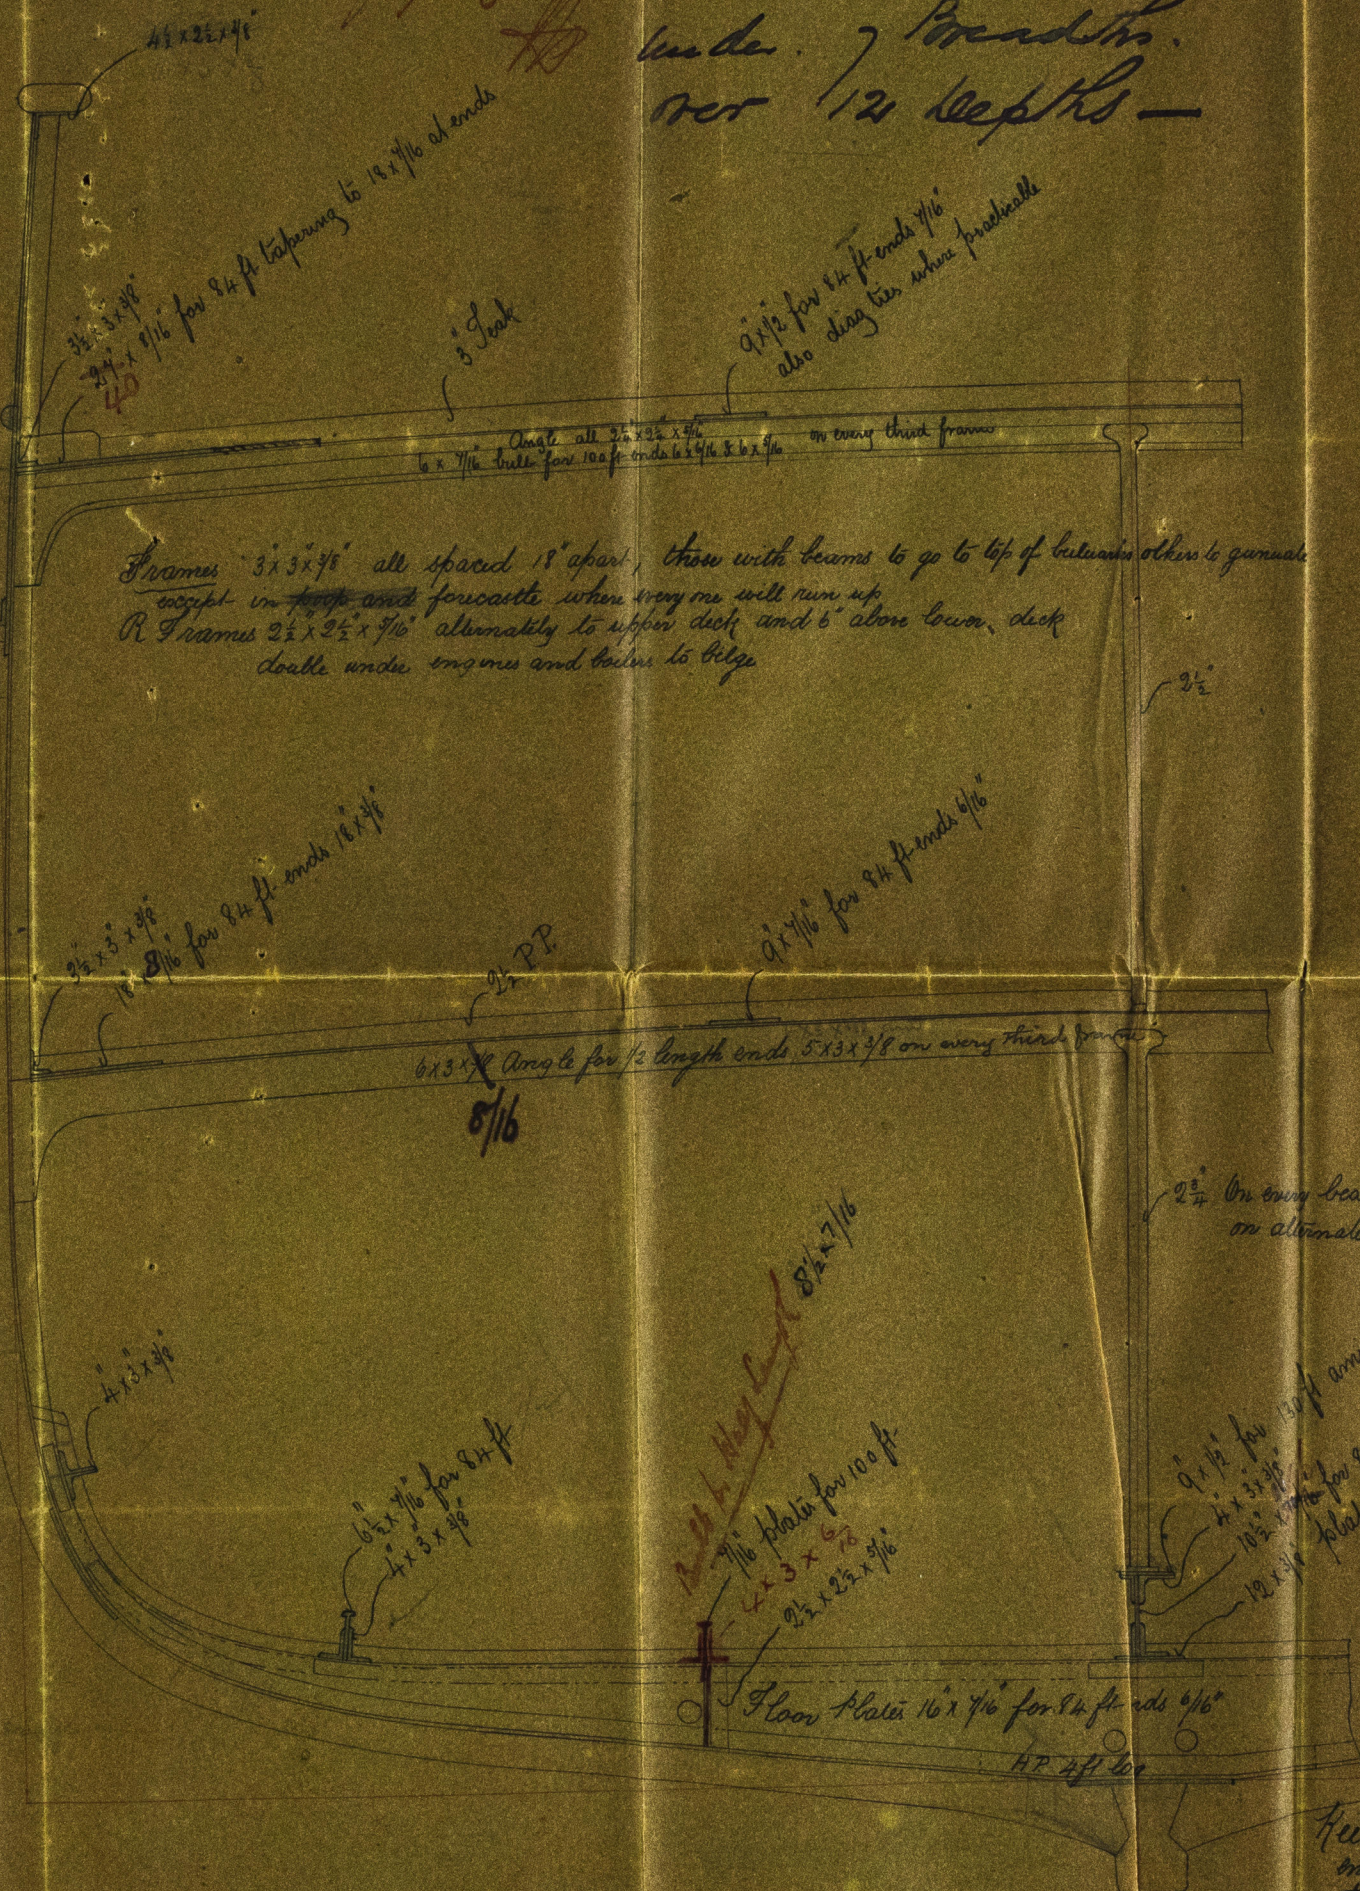

SHIP DRAWING OFFICE
13/8/94
FAIRFIELD

JOHN ELDER & CO

Shipbuilders & Engineers

GLASCOW



Lloyd's Register
Foundation