


S.S. GARTH CASTLE
Glasgow Report No. 5306

24.9.80

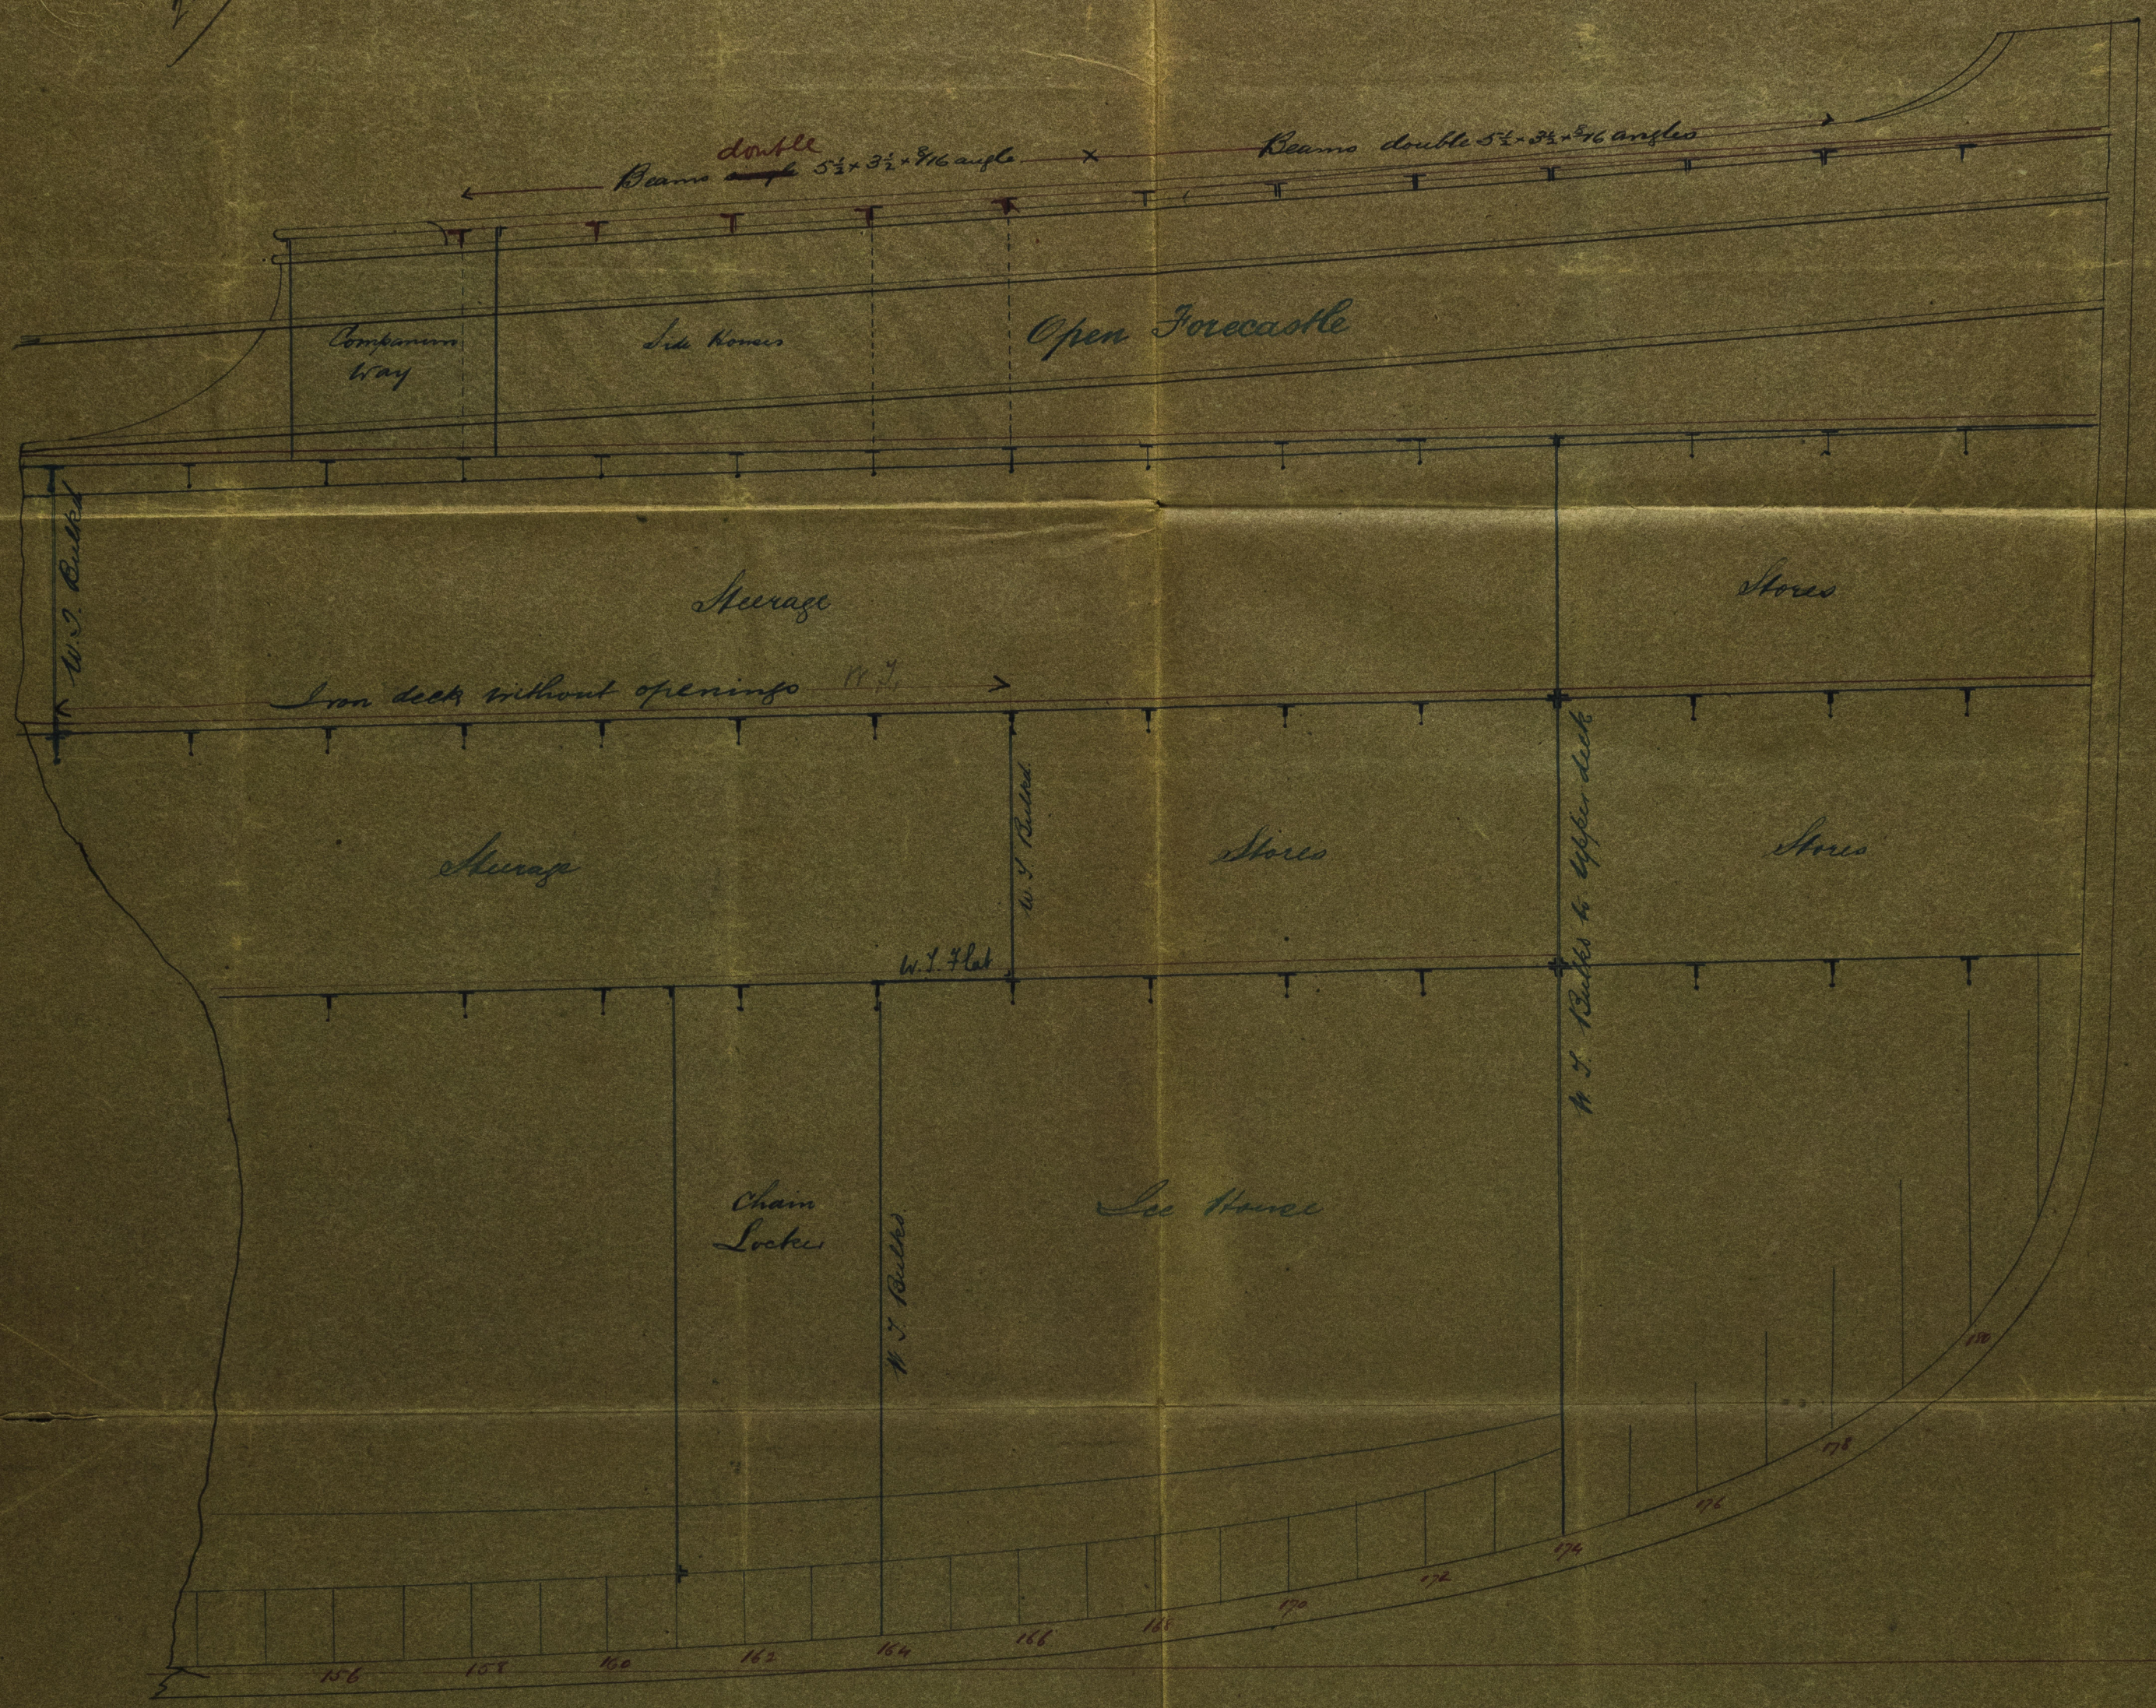

Forecastle Plan
Nov 24/5 6
Scale 1/4 inch to one foot



23/9/80

JOHN ELDER & CO.
Shipbuilders and Engineers
GLASGOW
Lloyd's Register
Foundation

915187-0018