


9/8/80

S.S. No. 16
Scale 1/4" = 1 foot

Profile

S.S. "Pertusola"

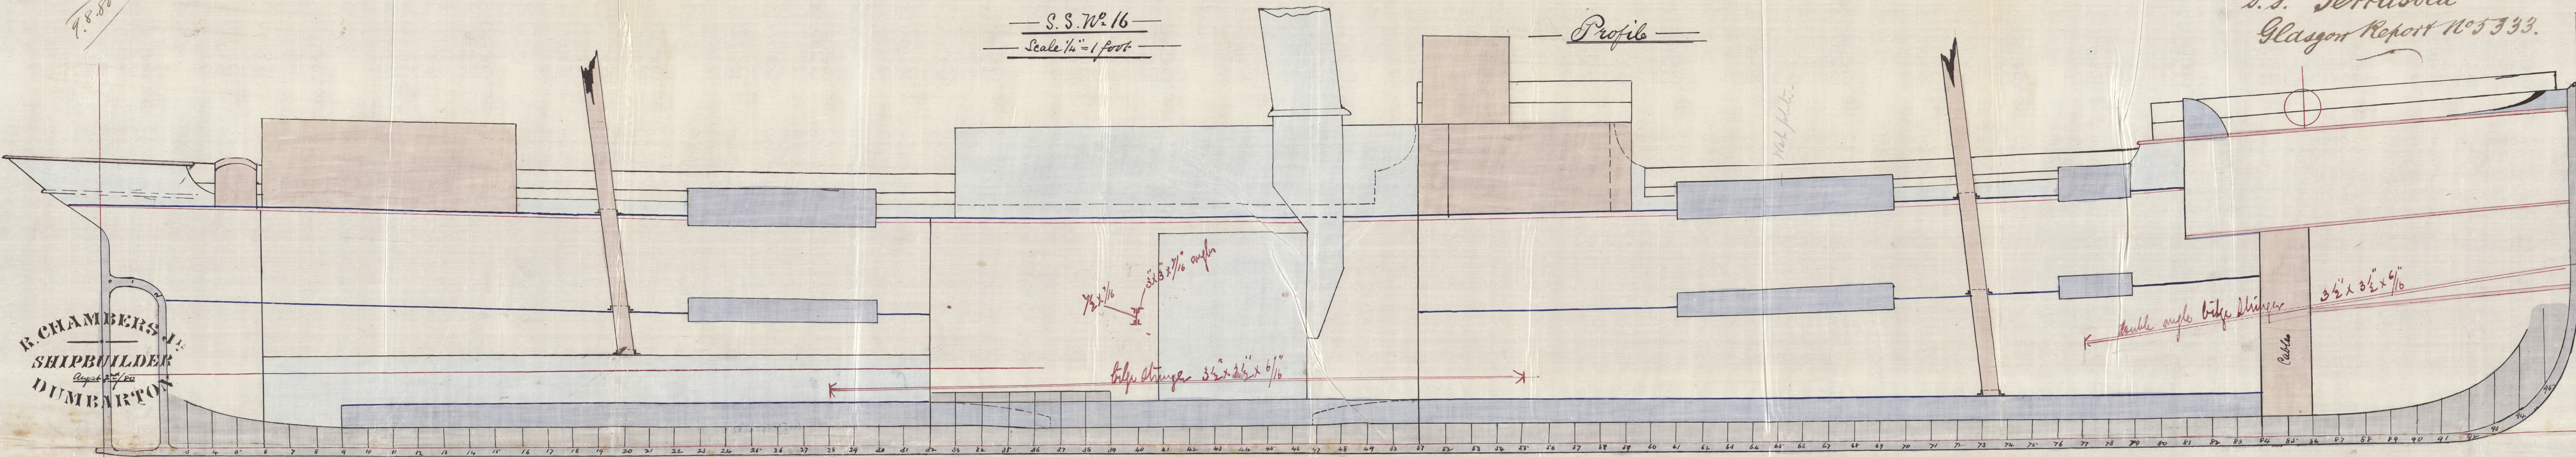

R. CHAMBERS JR.
SHIPBUILDER

R. CHAMBERS JR.
SHIPBUILDER

Top of Water Ballast Tank

