


Plan of Shelter Deck of the S.S. "Egyptian Monarch"
 Scale $\frac{1}{8}$ of an inch = 1 foot.

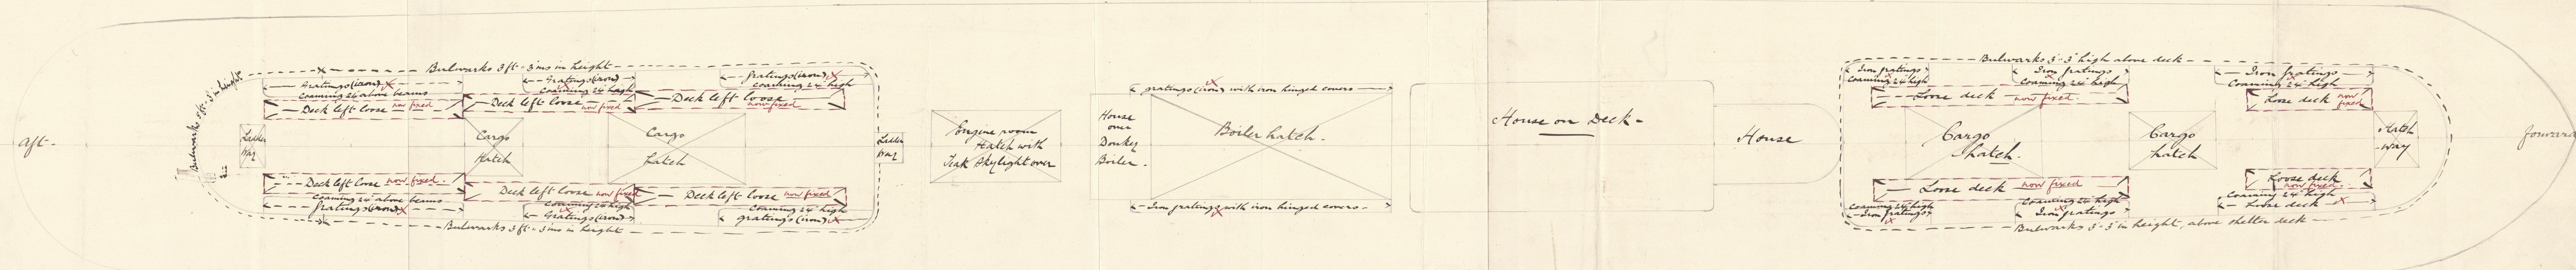

N.B. The whole of the loose deck has now been fastened and caulked in, and the Owners are having canvas covers fitted to the whole of the spaces (X) where iron gratings are fitted.

J.H.
 13/4/87.

N.B. The whole of the loose deck is now fastened and caulked in, and the Owners are having canvas covers fitted to the whole of the spaces (X) where iron gratings are fitted.

J.H.
 13/4/87.