



S.S. "Catania"
Glasgow Report No 5360

IRON SCREW STEAMER N° 253

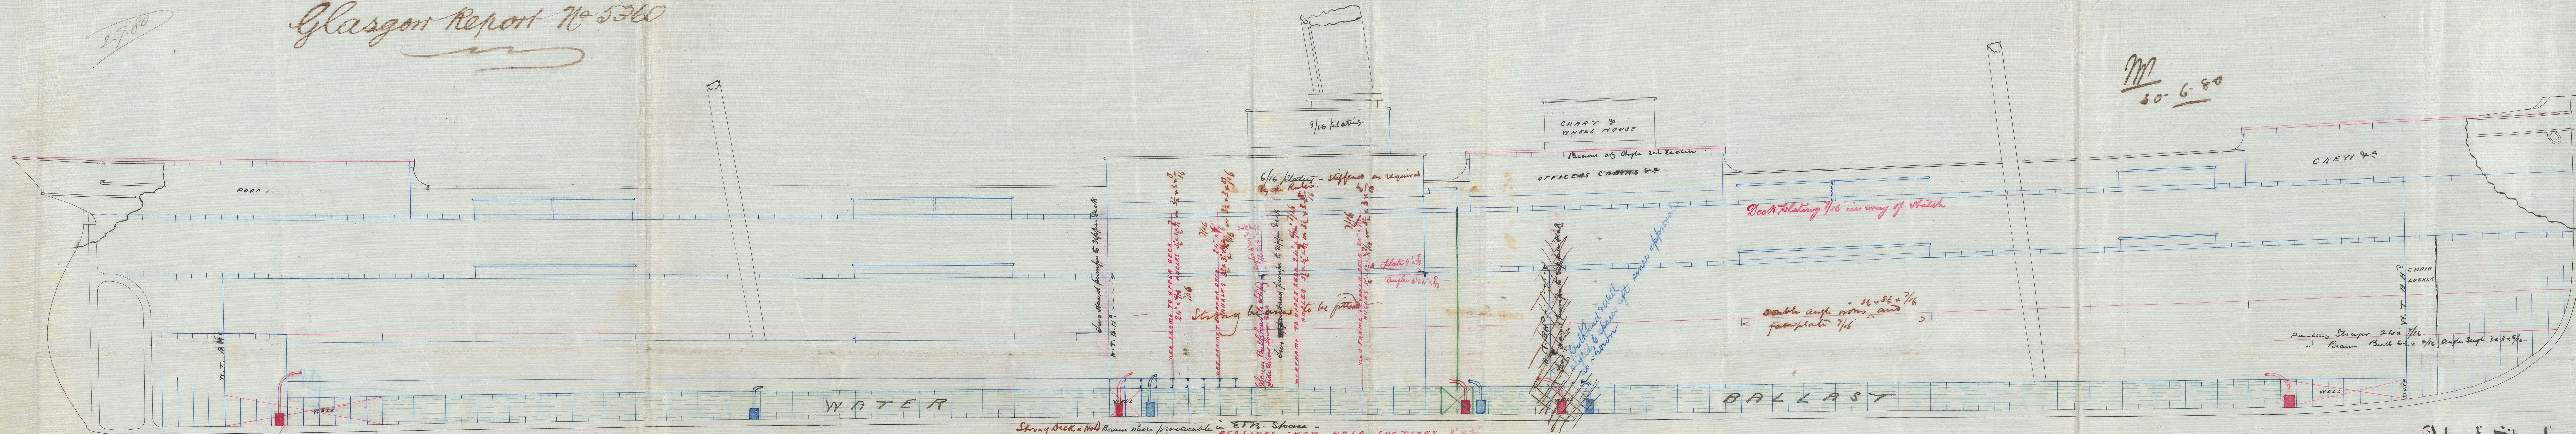

SCALE 1/4 INCH TO A FOOT

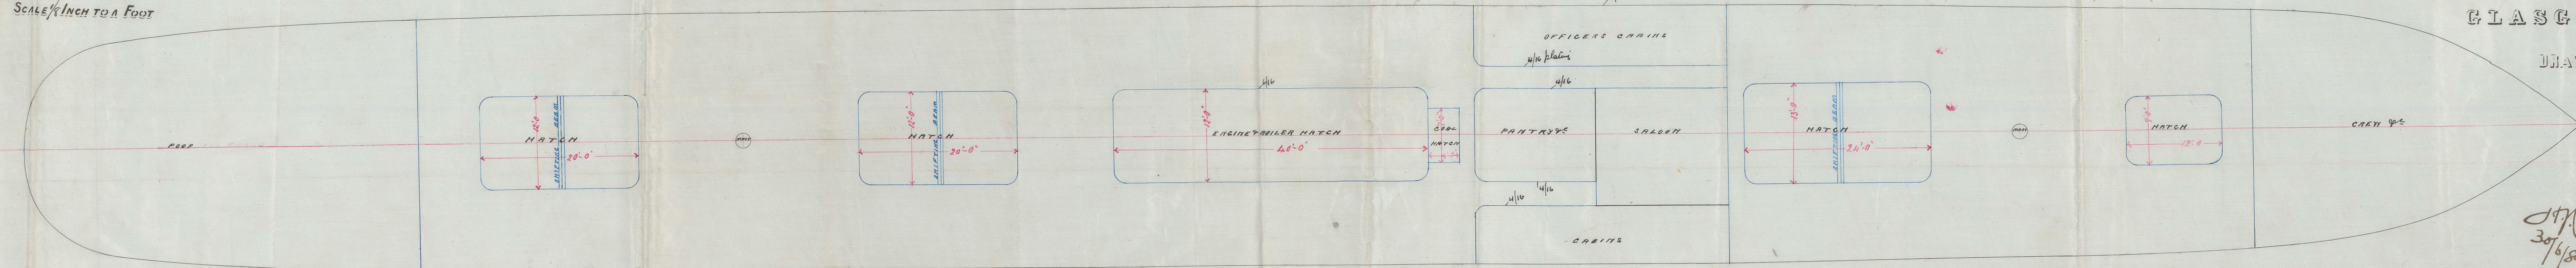

Alex. Stephen & Sons.
SHIPBUILDERS & ENGINEERS
GLASGOW

DRAWING N° 1817
En 20/6/80
Mica

GLS188-0031

30/6/80