


534.76

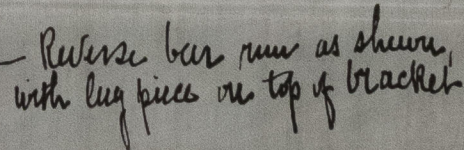

Lloyd's Register  
Foundation

GLS/88-0082