

S.S. "Atanmore"  
Glasgow Report of 55392

21.5.80

— S S N 220 —



— W SIMONS & CO —  
SHIPBUILDERS, ENGINEERS, & FOUNDERS.  
LONDON WORKS  
RENFREW.

Fore and Main Lower Masts of Steel

	Partners	Heel	Hounds	Head
	dia	cks	cks	cks

Masts to have 12 ft. doublings  
in way of Wedging.  
see letter 2 June 1880

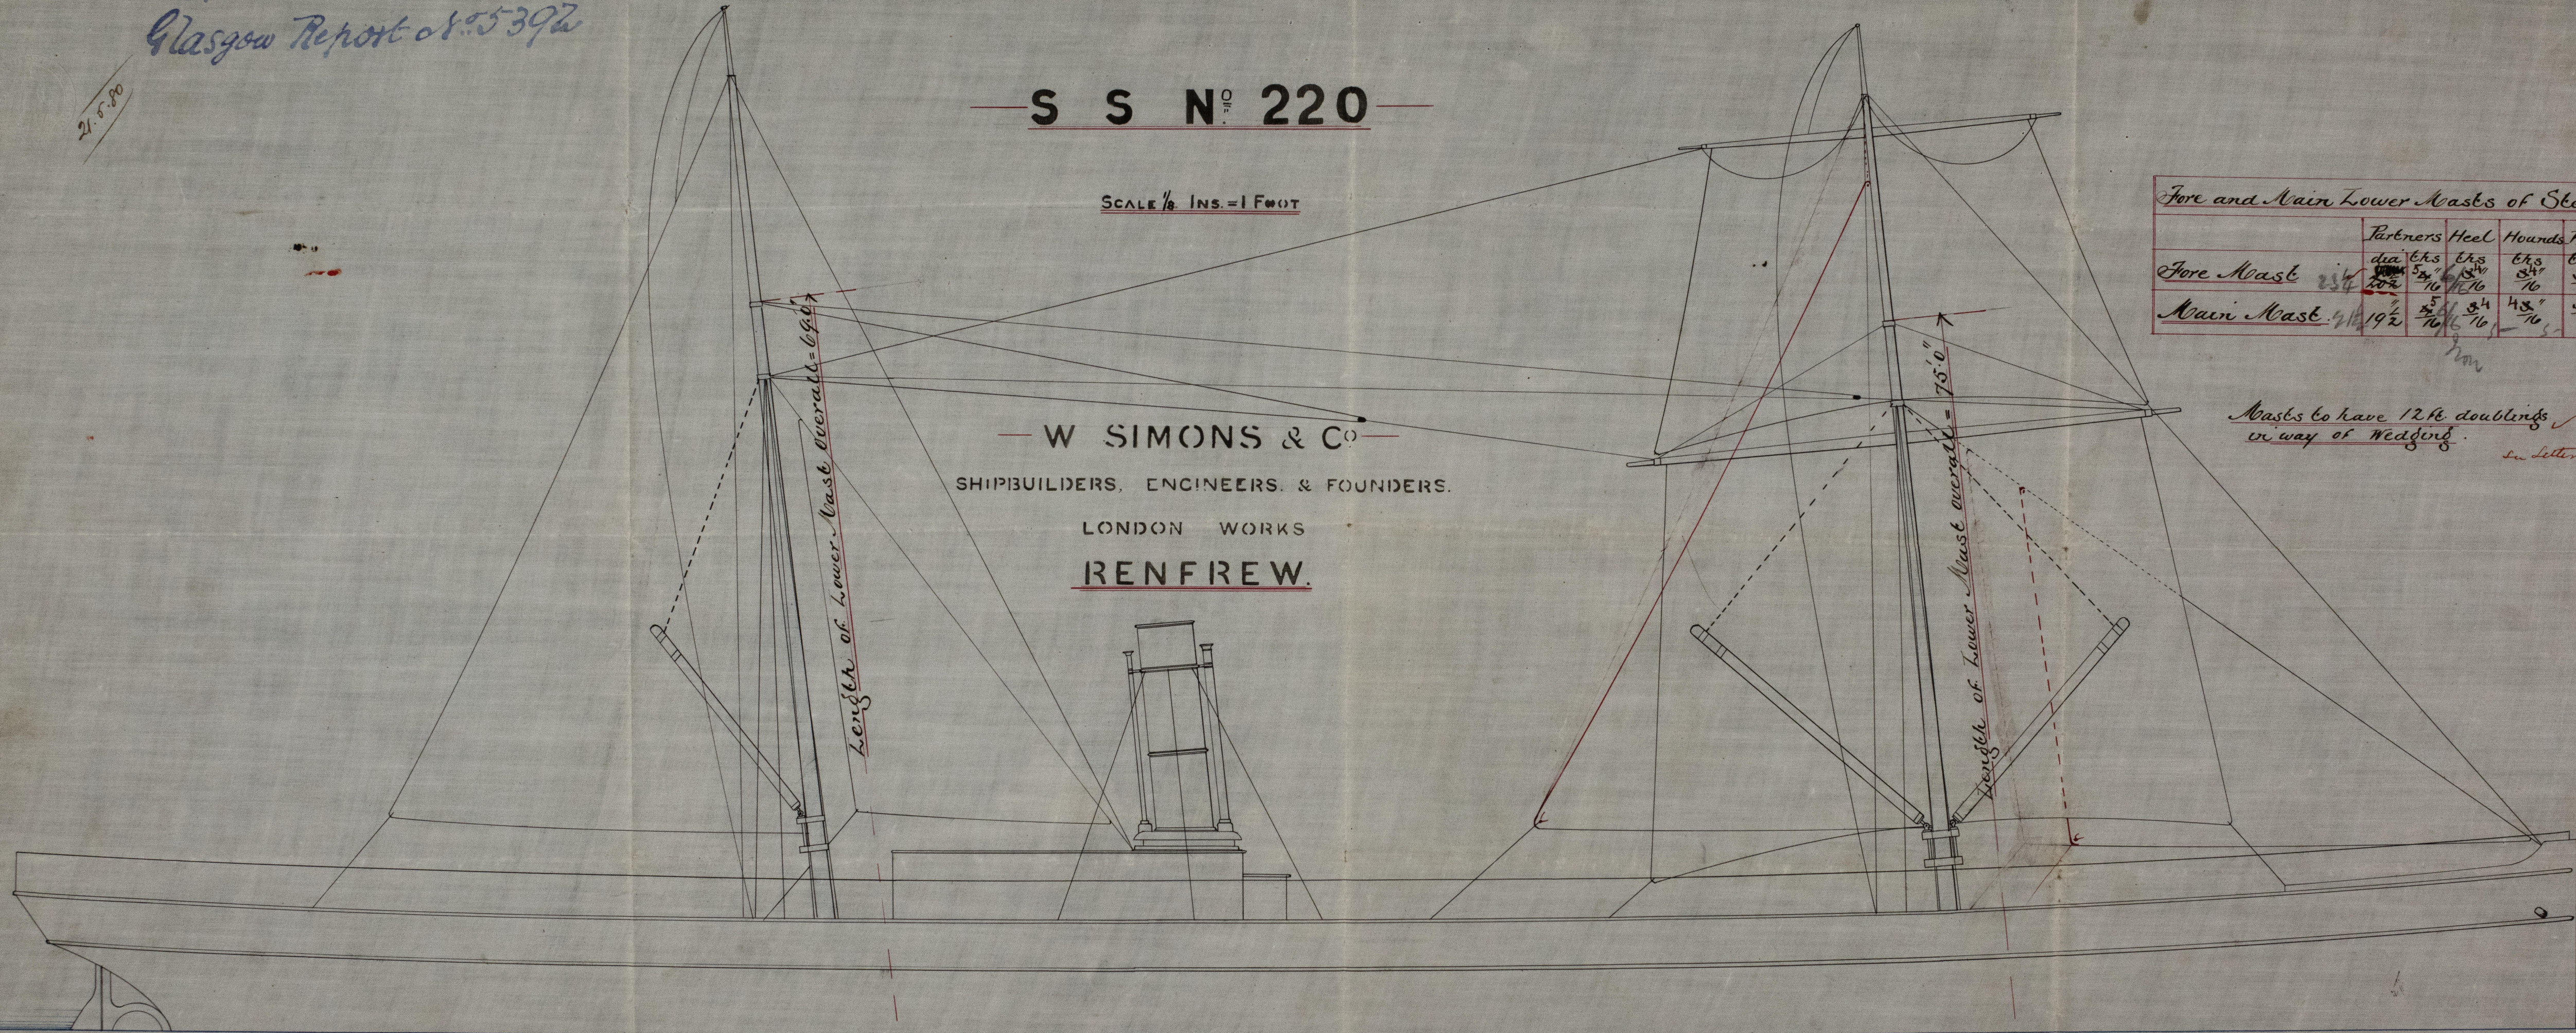

GLS188-0084