


Lo. to Hls. 2015/81

21/1/81



S.S. "Fieramosca"
Glasgow Report No 5424

Scale 1/4 inch to the foot

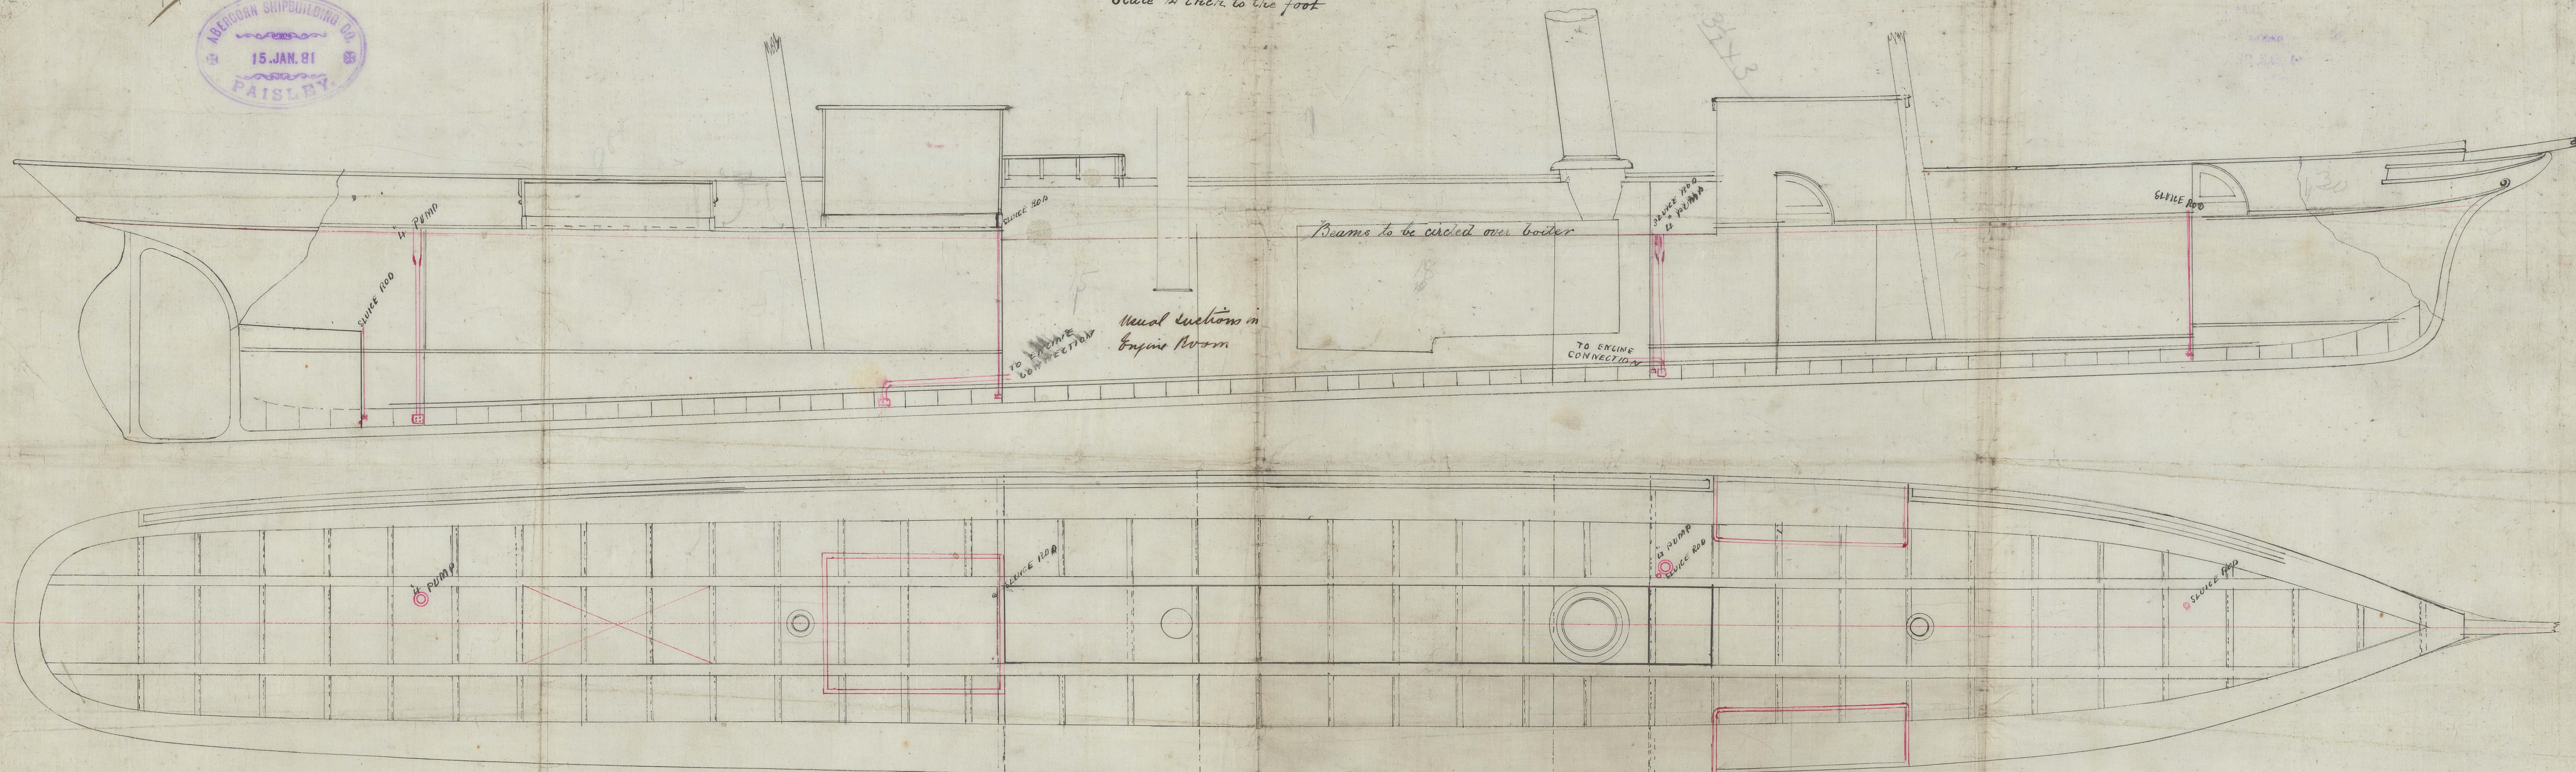

10/6/81

GLS1881-0048