

26/8/80


12/8/80

N^o 231 (Steel)

Shelter Deck for Cattle

Scale $\frac{1}{2}$ inch = one foot

S.S. "Lydian Monarch"
Glasgow Report No. 5428

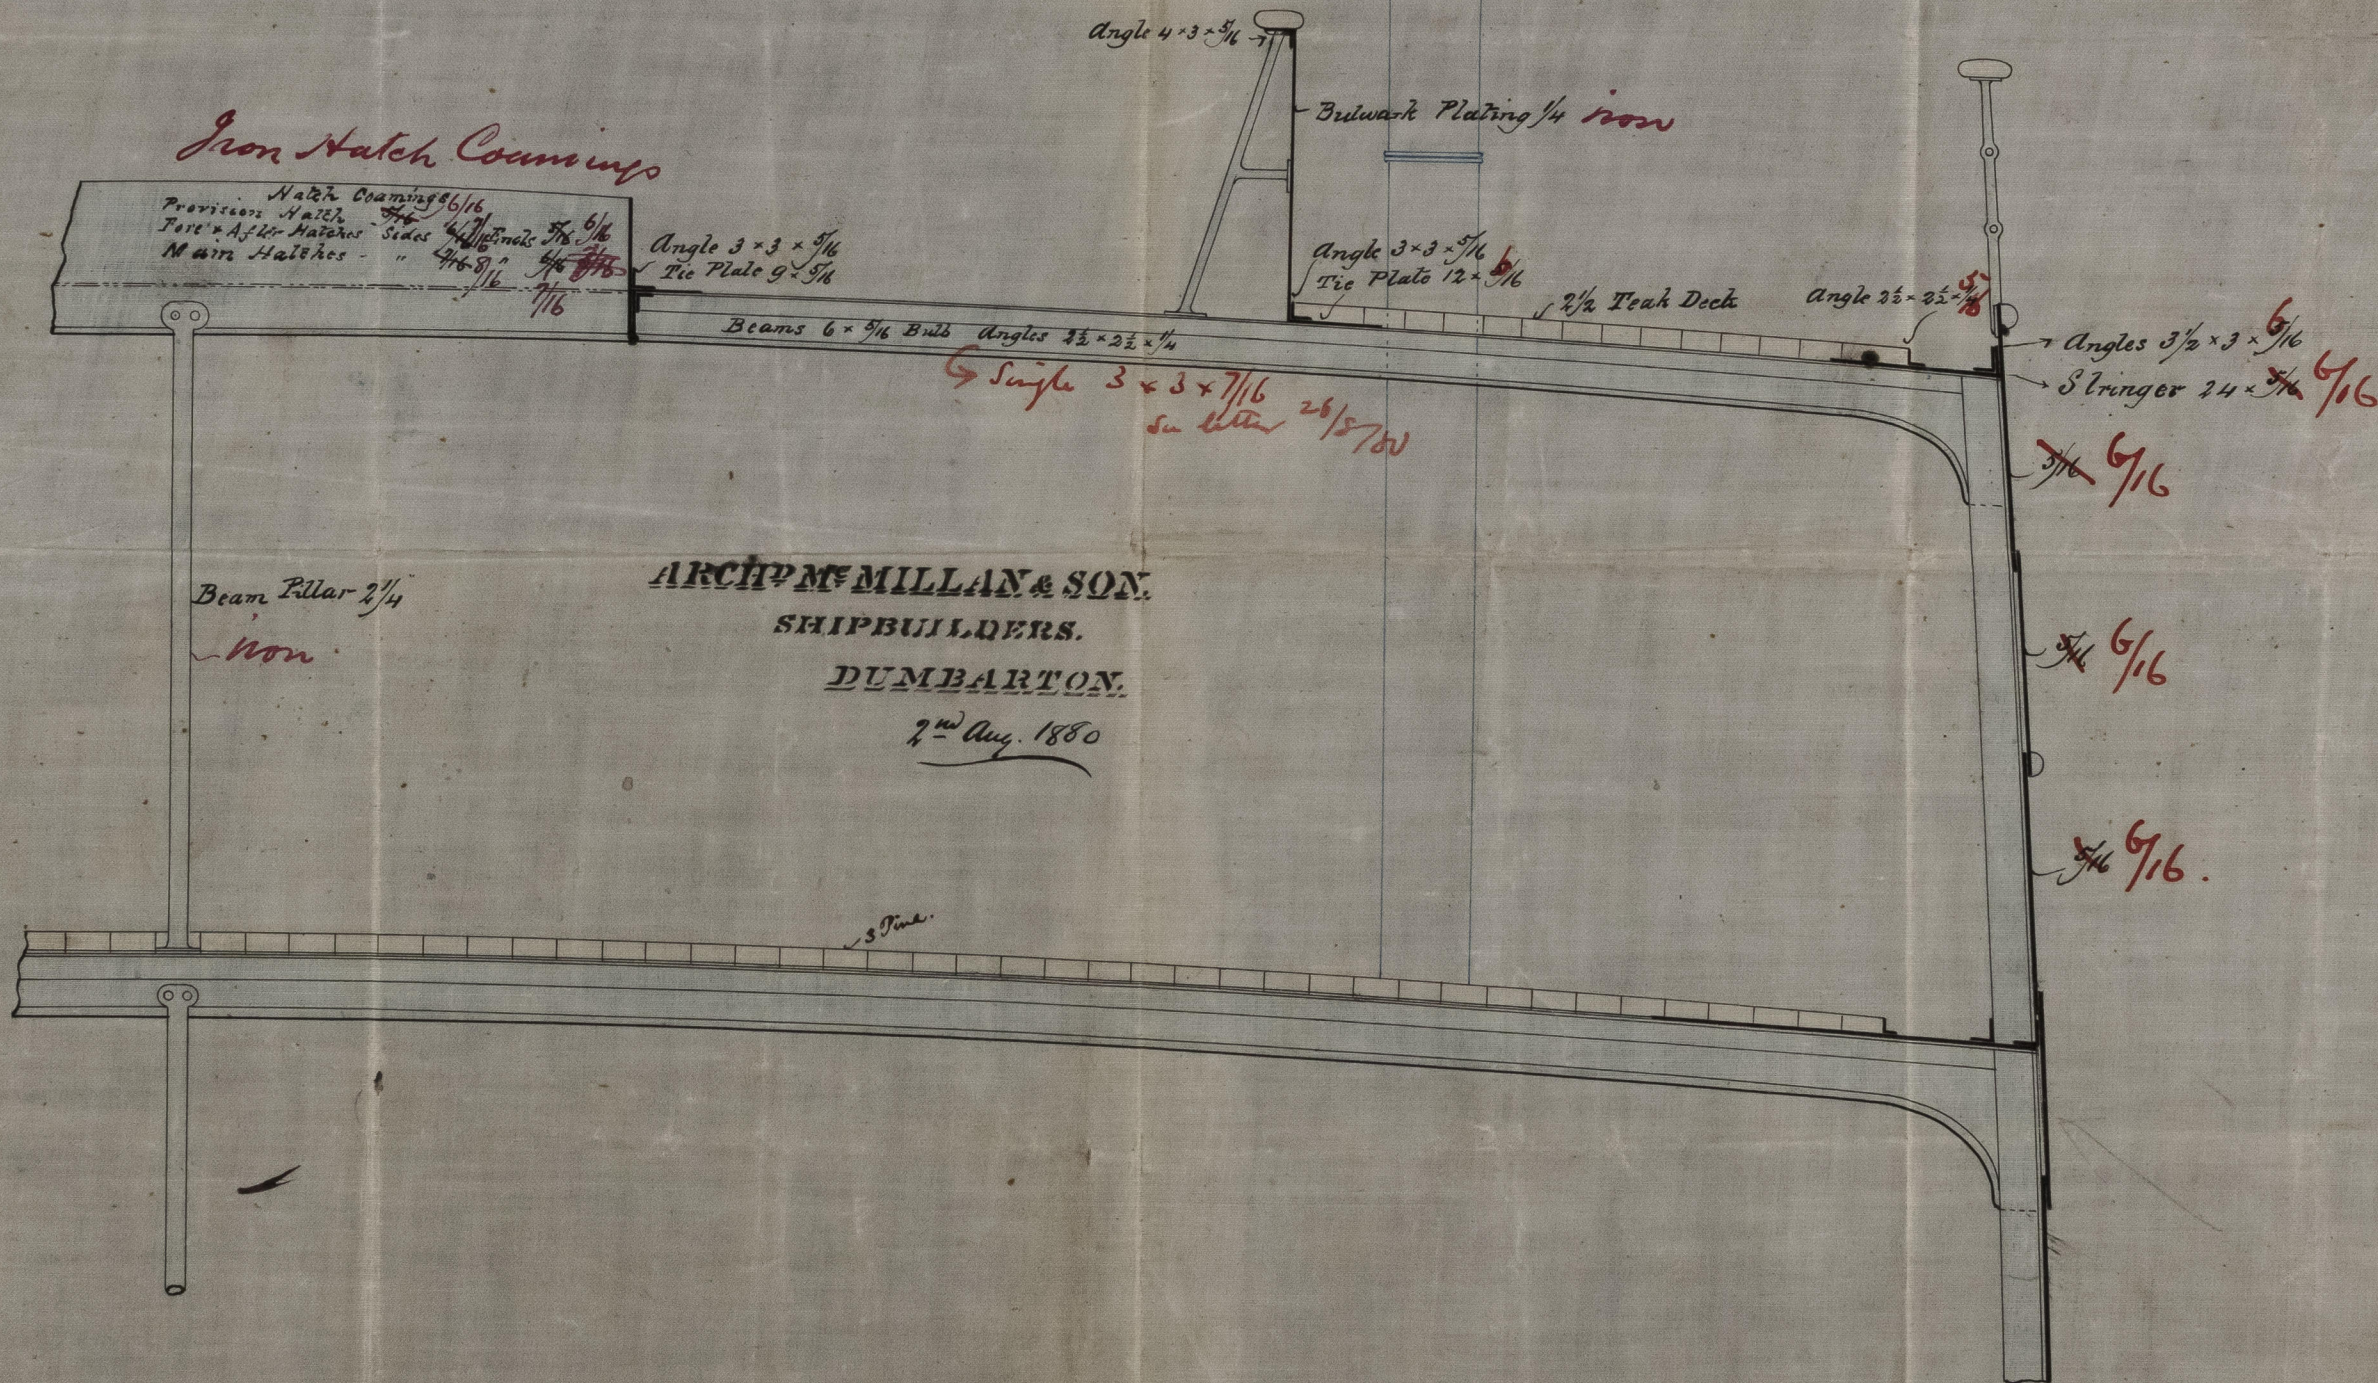

18M
J.H.
10/8/80

GLS188A-0058



© 2021
Lloyd's Register
Foundation