



S.S. "Lylian Monarch"
Glasgow Report of 24.2.28.

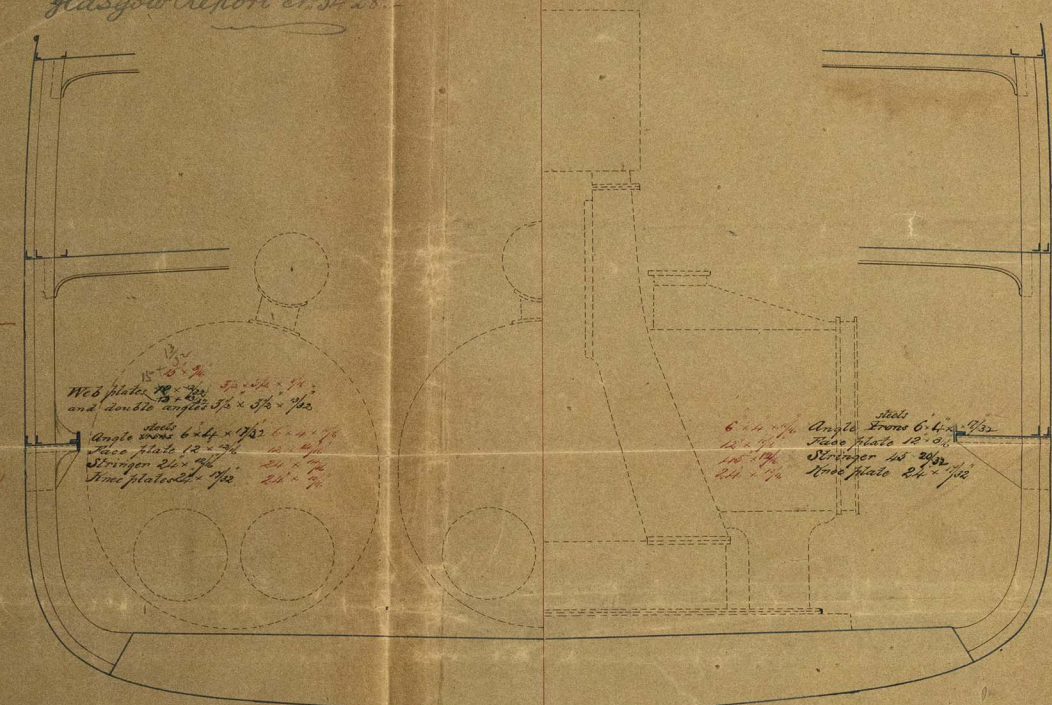


Section at Boiler Space showing
Web Frames and Side Stringers



Section at Engine Space showing
Web Frames and Side Stringers

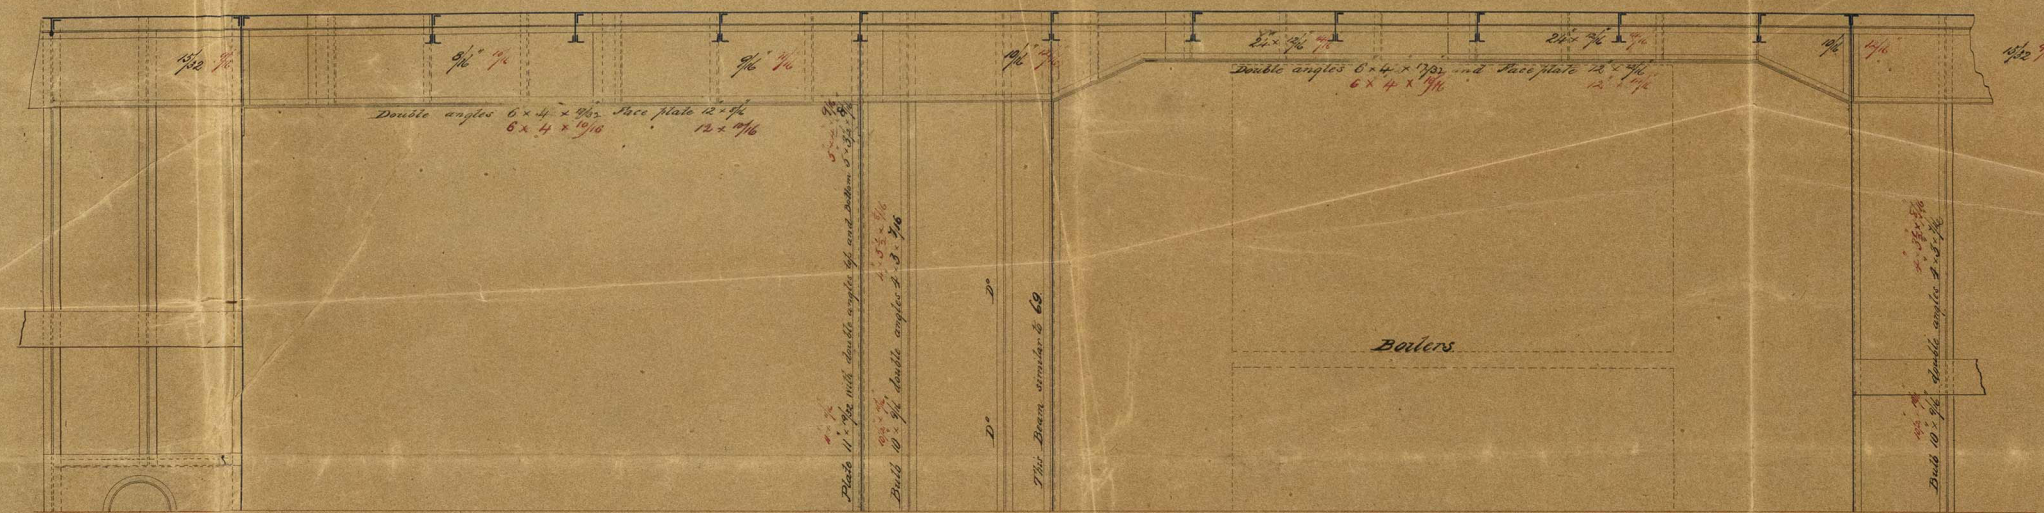

Lower Deck

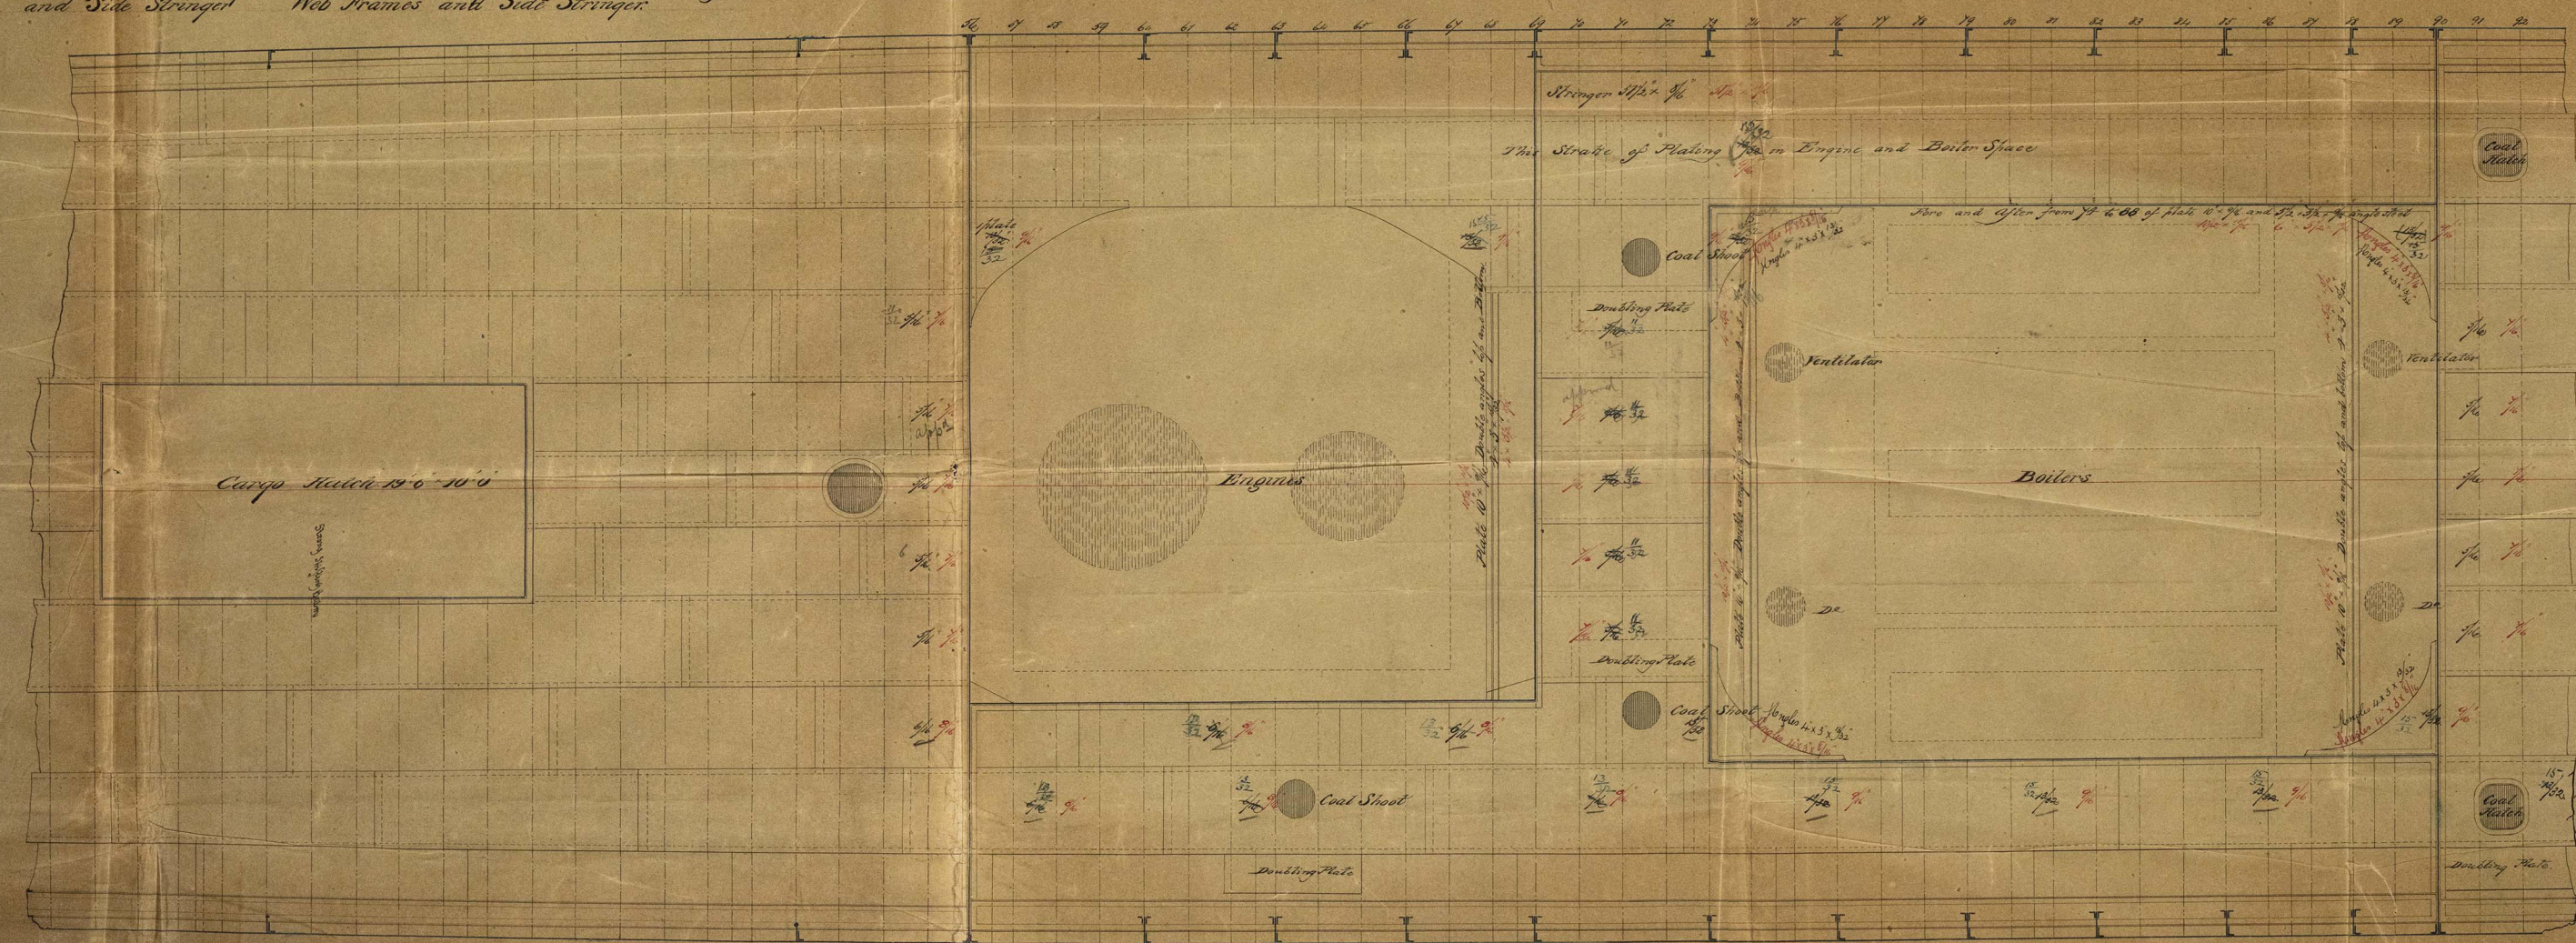

Main Deck

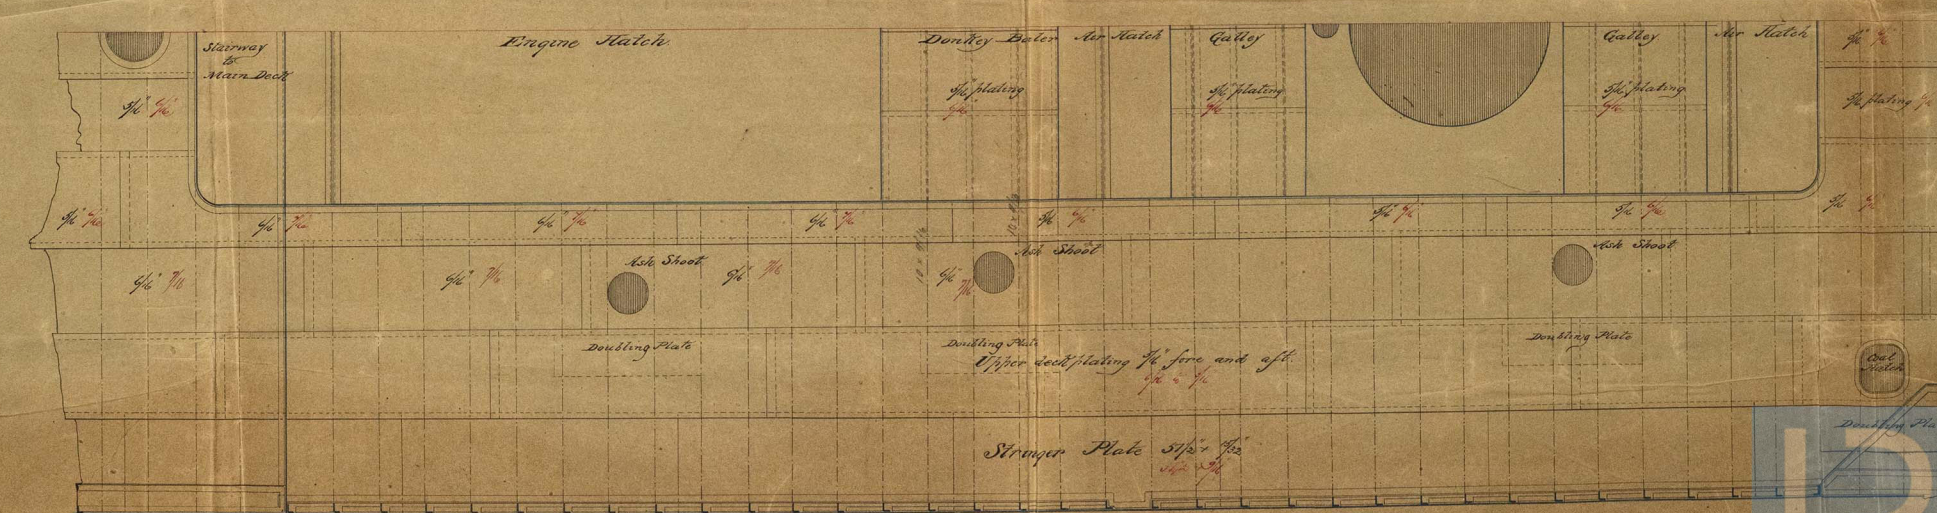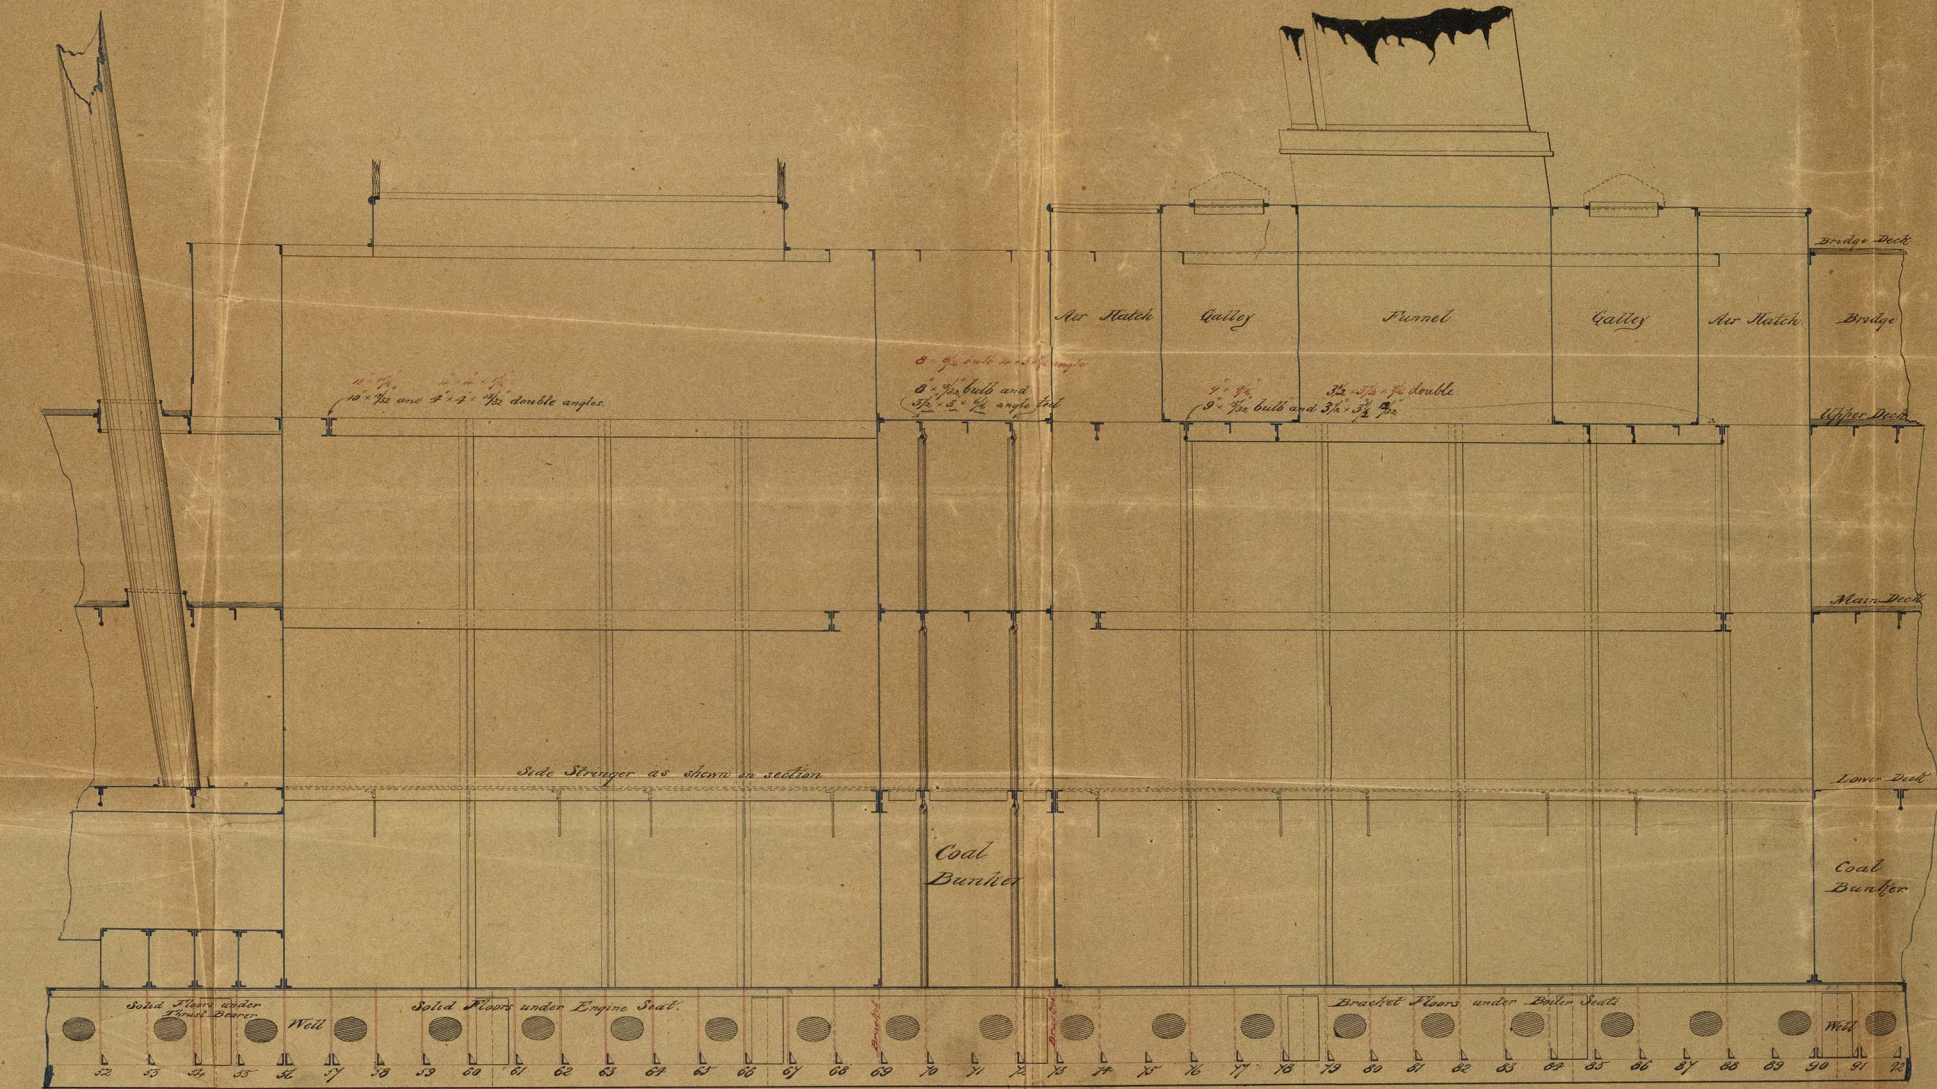

Note: Holes in Centre Line Plates to
be omitted in Nos 228-31.

Compensation in Wake
of
Engines and Boilers
Steel S.S. No 251
Scale 1/2" = 1' 0" 0"

ARCHD Mc MILLAN & SON
SHIPBUILDERS
DUNDEE
1876

Red figures: Iron Scallops
Black: Steel



© 2021
Lloyd's Register
Foundation

Ln 5450

GLS188A-0060



© 2021

Lloyd's Register
Foundation