
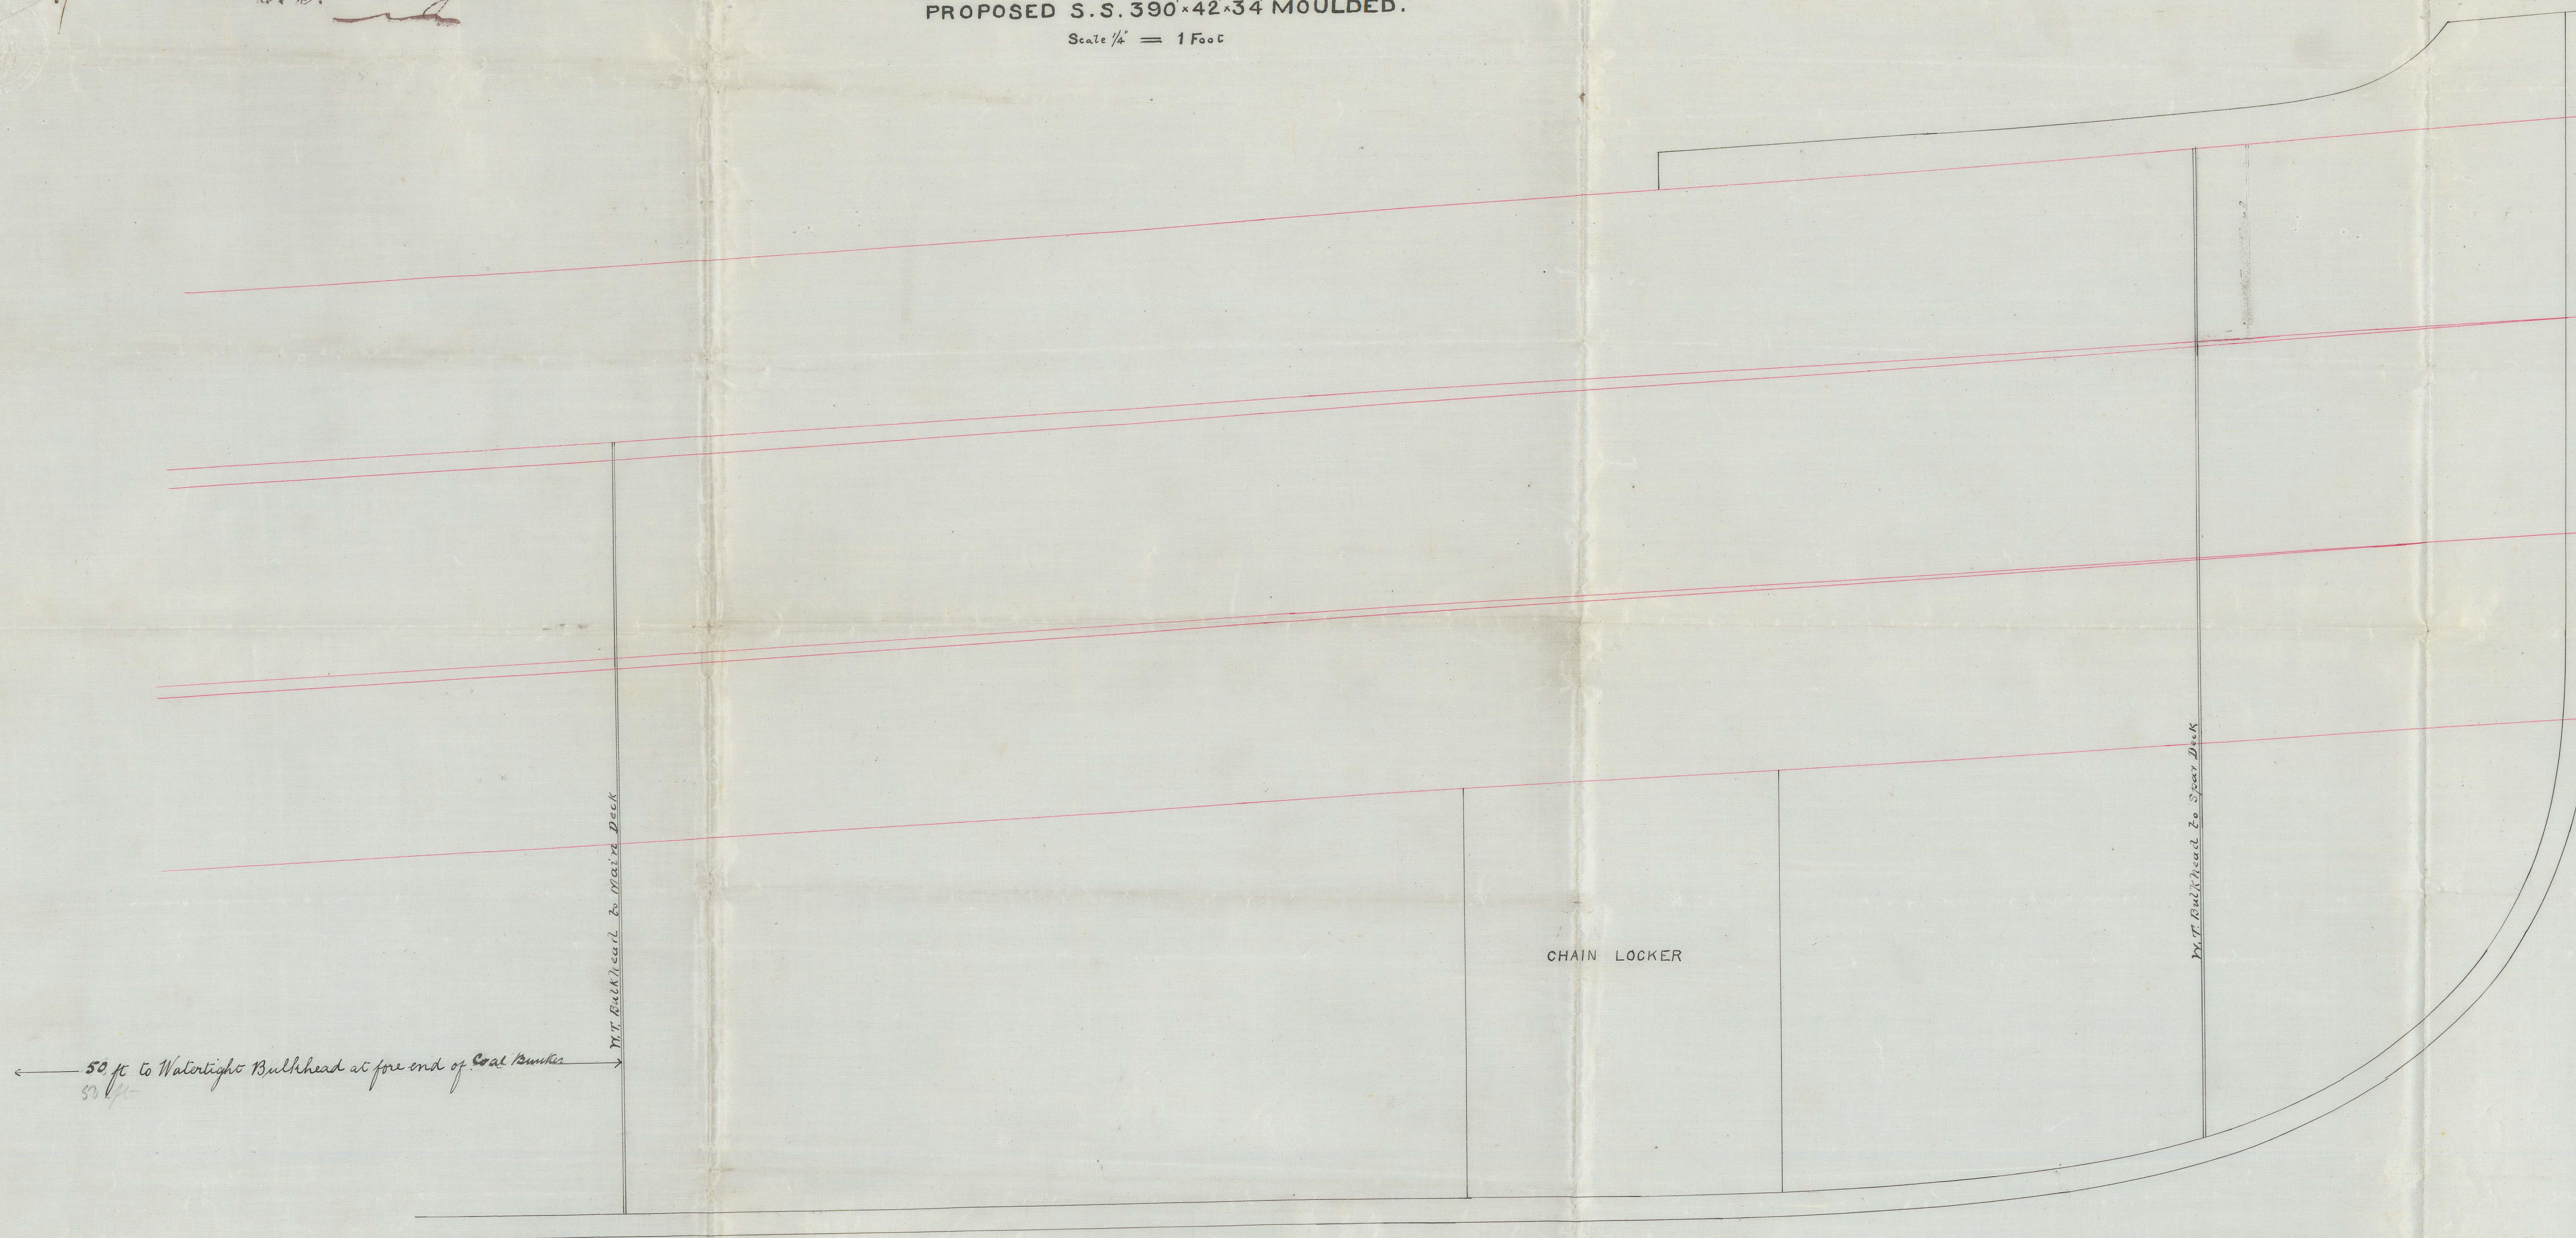


17.6.80 Glasgow Report No. 34-83
S.S. "Glyde"

SKETCH SHEWING POSITION OF PEAK BULKHEAD
PROPOSED S.S. 390' x 42' x 34' MOULDED.

Scale $\frac{1}{4}$ " = 1 Foot

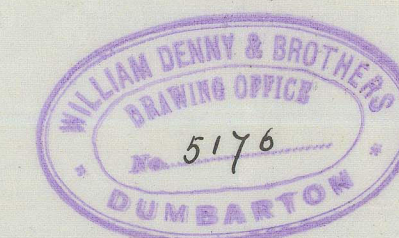

← 50 ft to Watertight Bulkhead at fore end of Coal Bunker →
50 ft

18M
17/6/80

GLS189-0025



© 2021
Lloyd's Register
Foundation