


MIDSHIP SECTION

Nº 247

S.S. "Alaska"
Glasgow Report Nº 5526

20.7.80

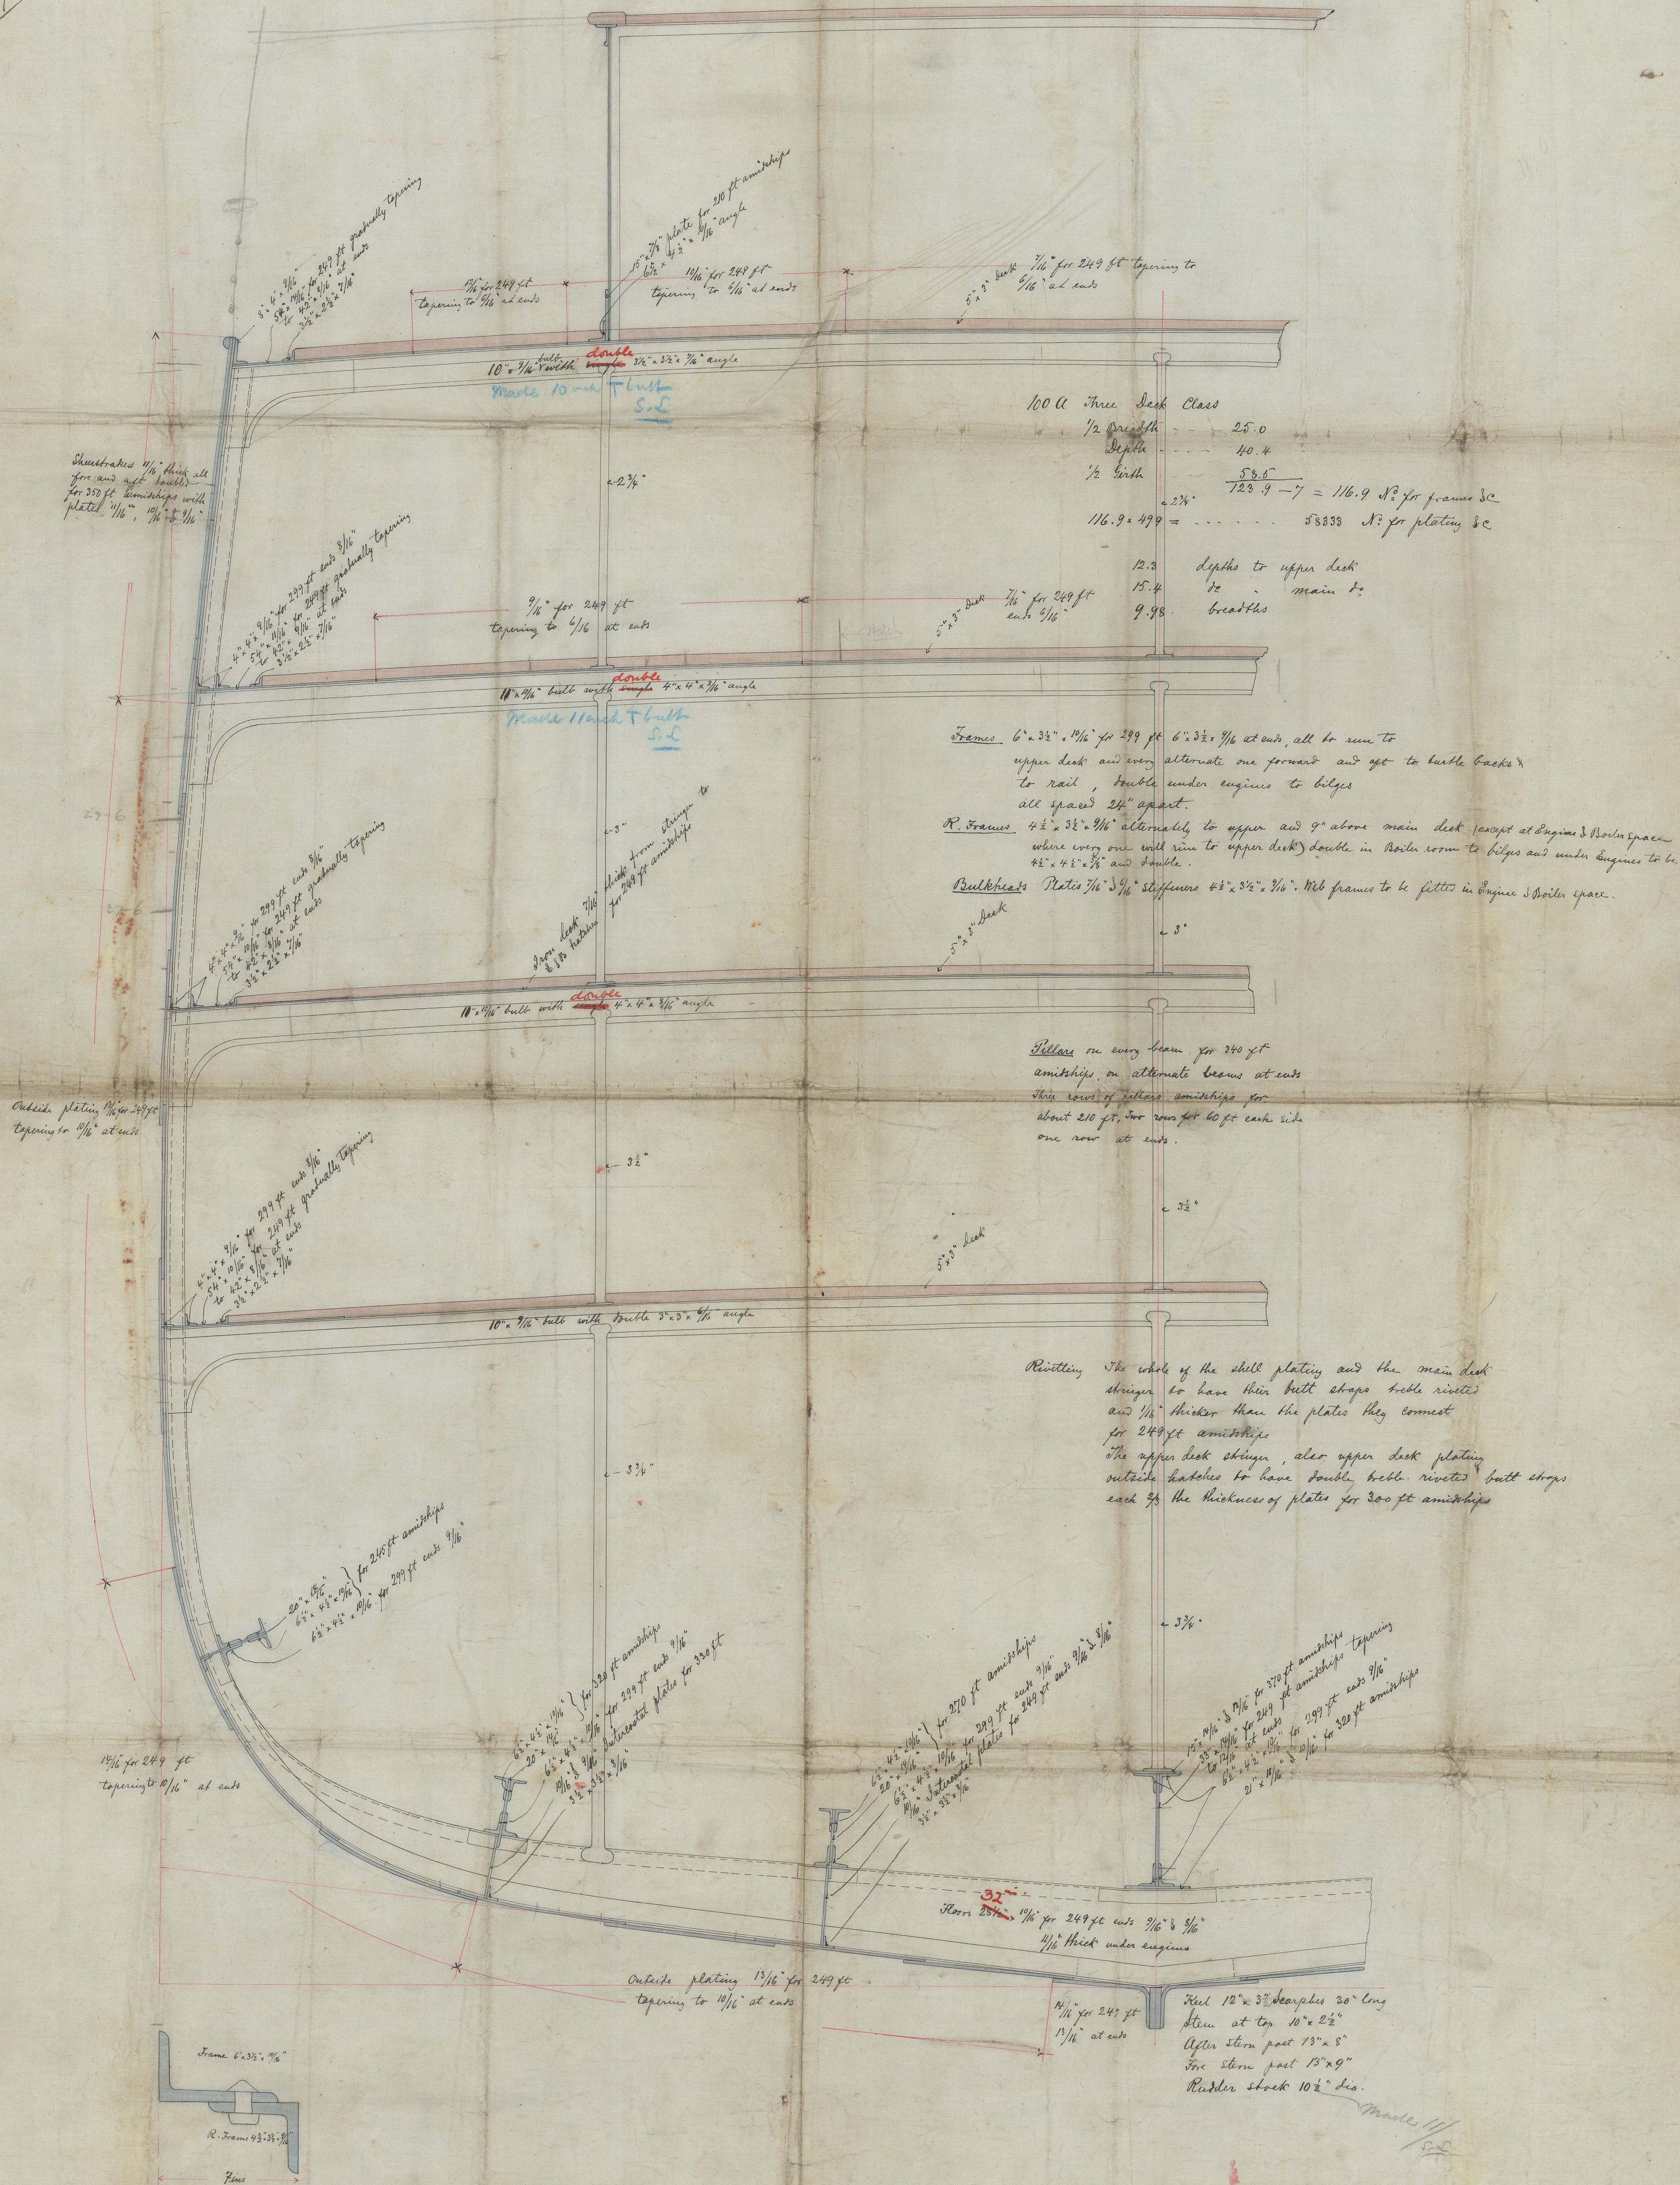

SCALE 1/2 INCH TO THE FOOT

28/7/80