


MIDSHIP SECTION IRON SCREW STEAMER N° 125

SCALE $\frac{1}{2}$ INCH PER FOOT

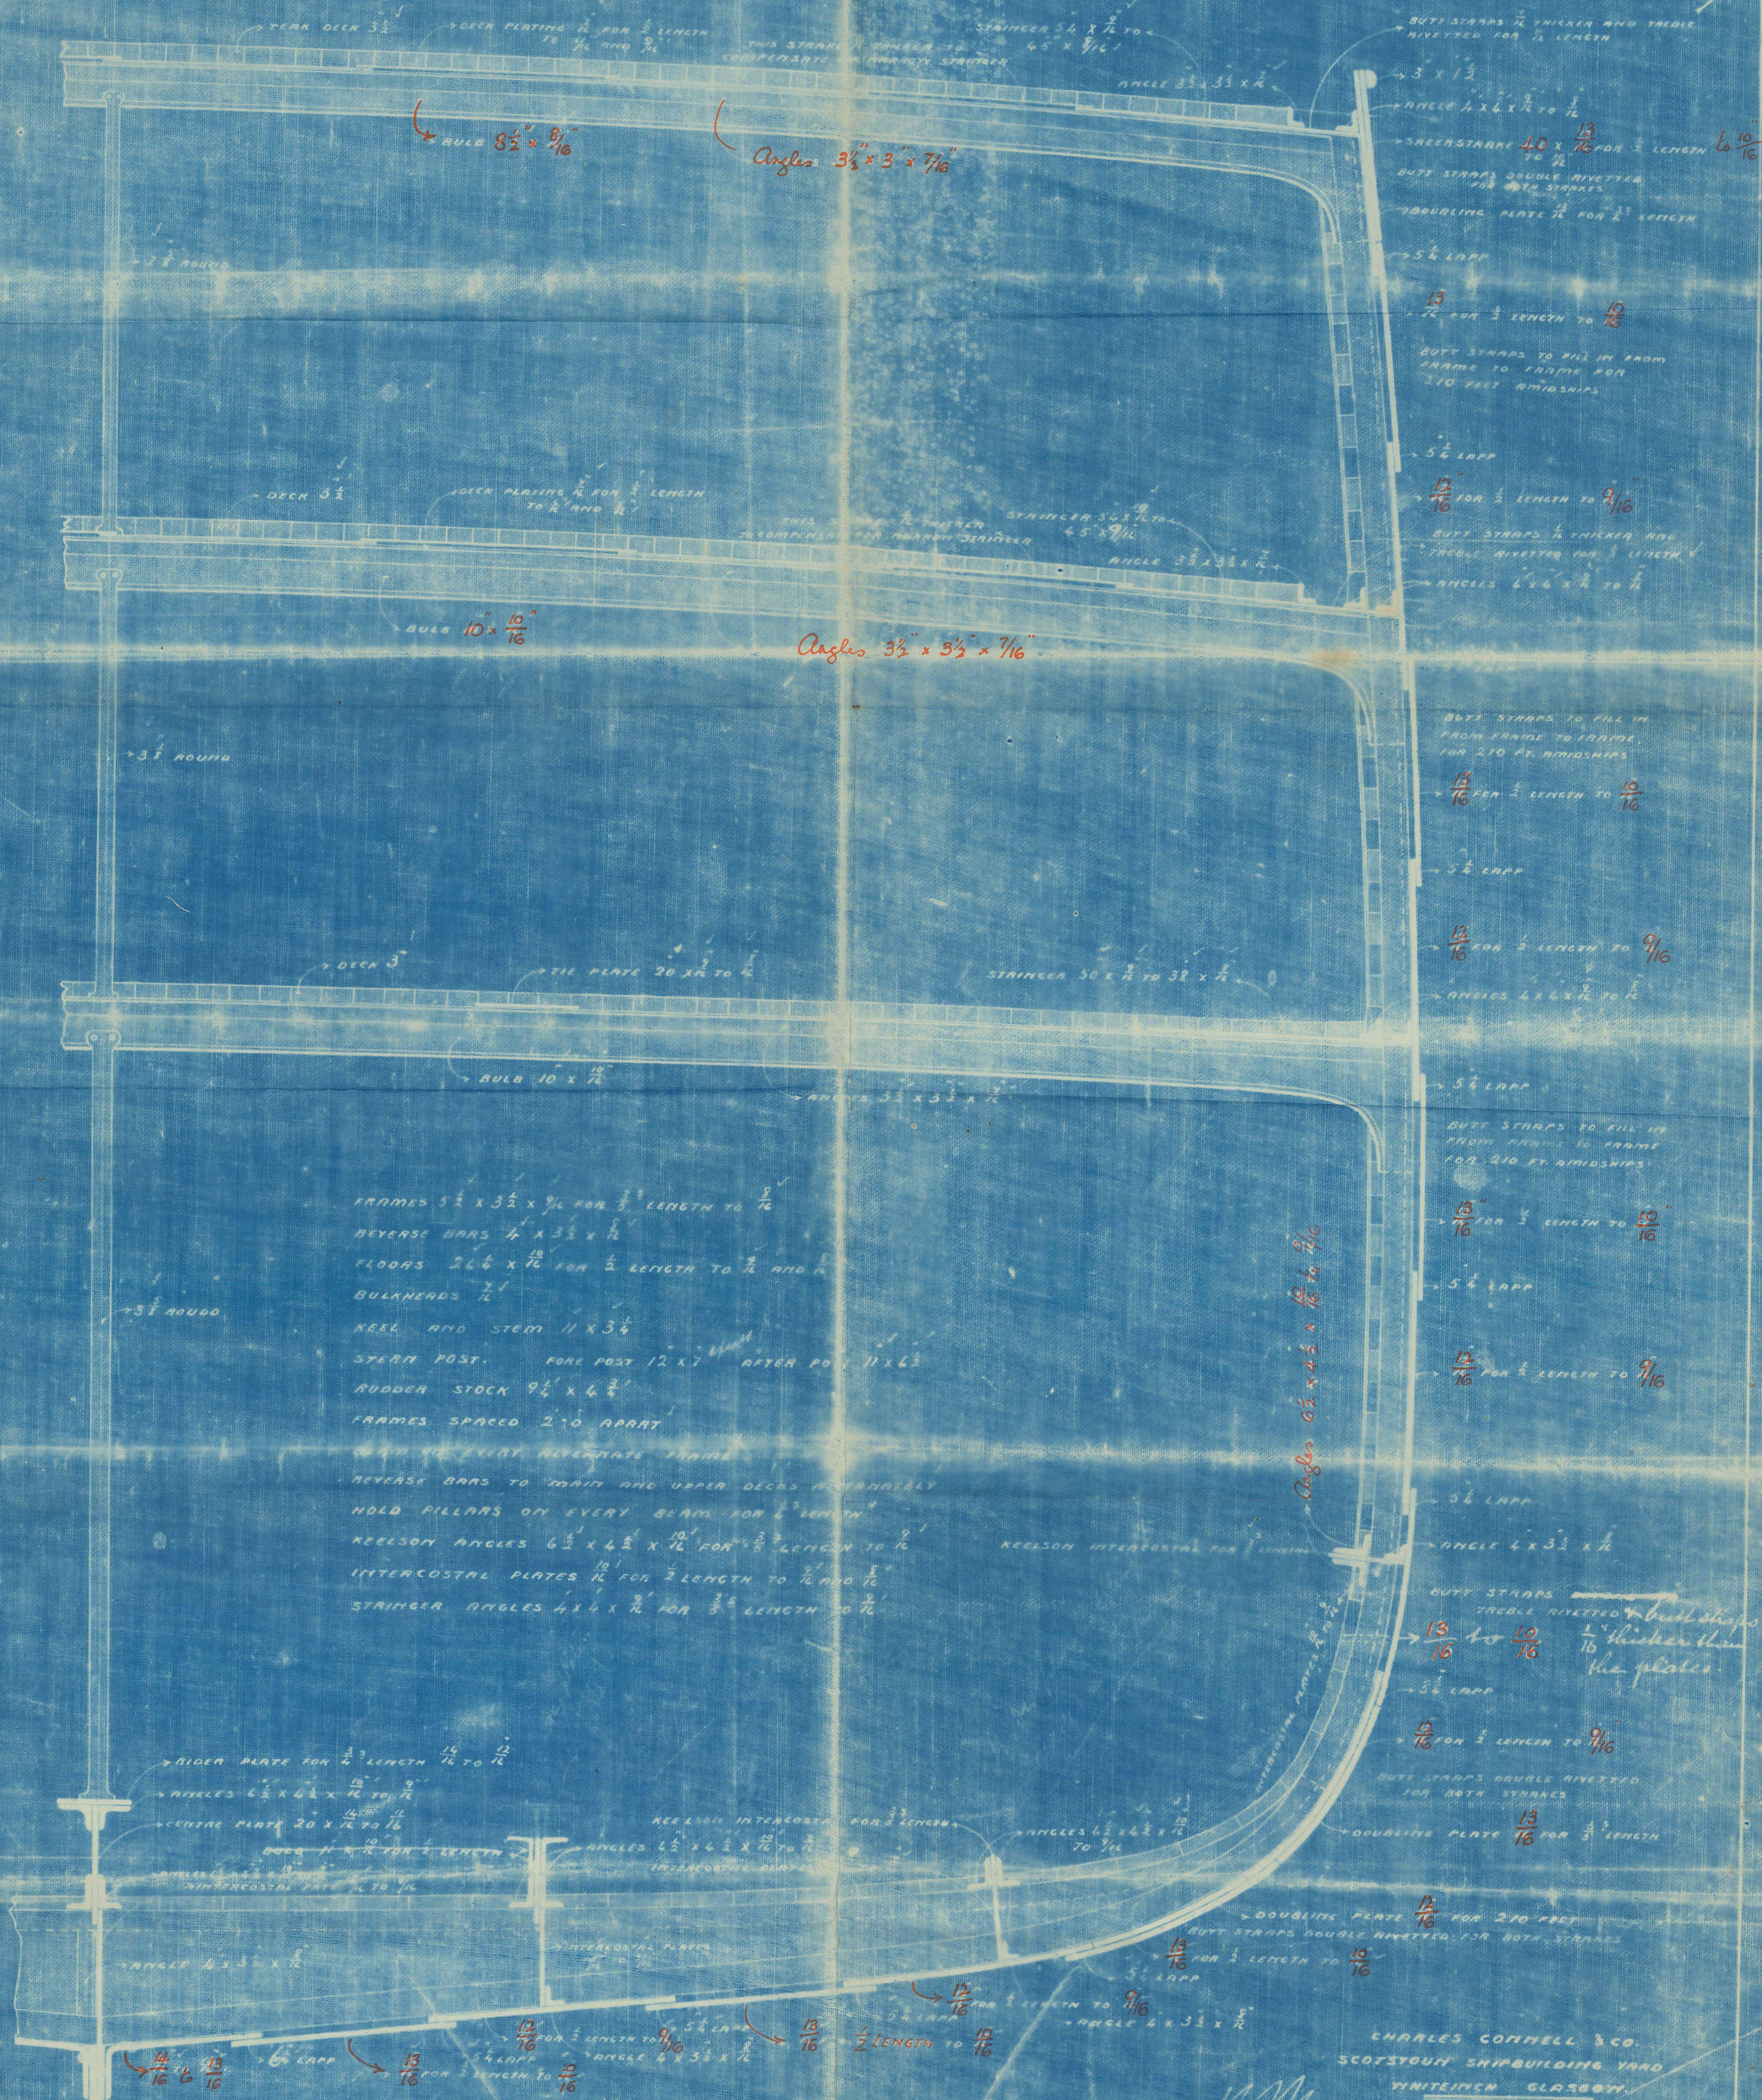

Lloyd's Register
Foundation

HONG MOH.


Midship Section

To be returned to the
London Office

City of London

GL

5536

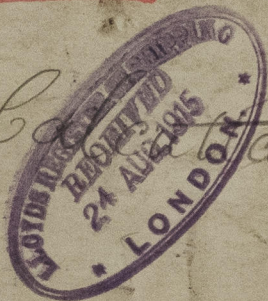

© 2021

Lloyd's Register
Foundation

GLS189A-0028